


PLOT INFO: 8/27/2018 8:53:20 AM C:\Work\Revit\2017_A_180746_wpslowk.rvt

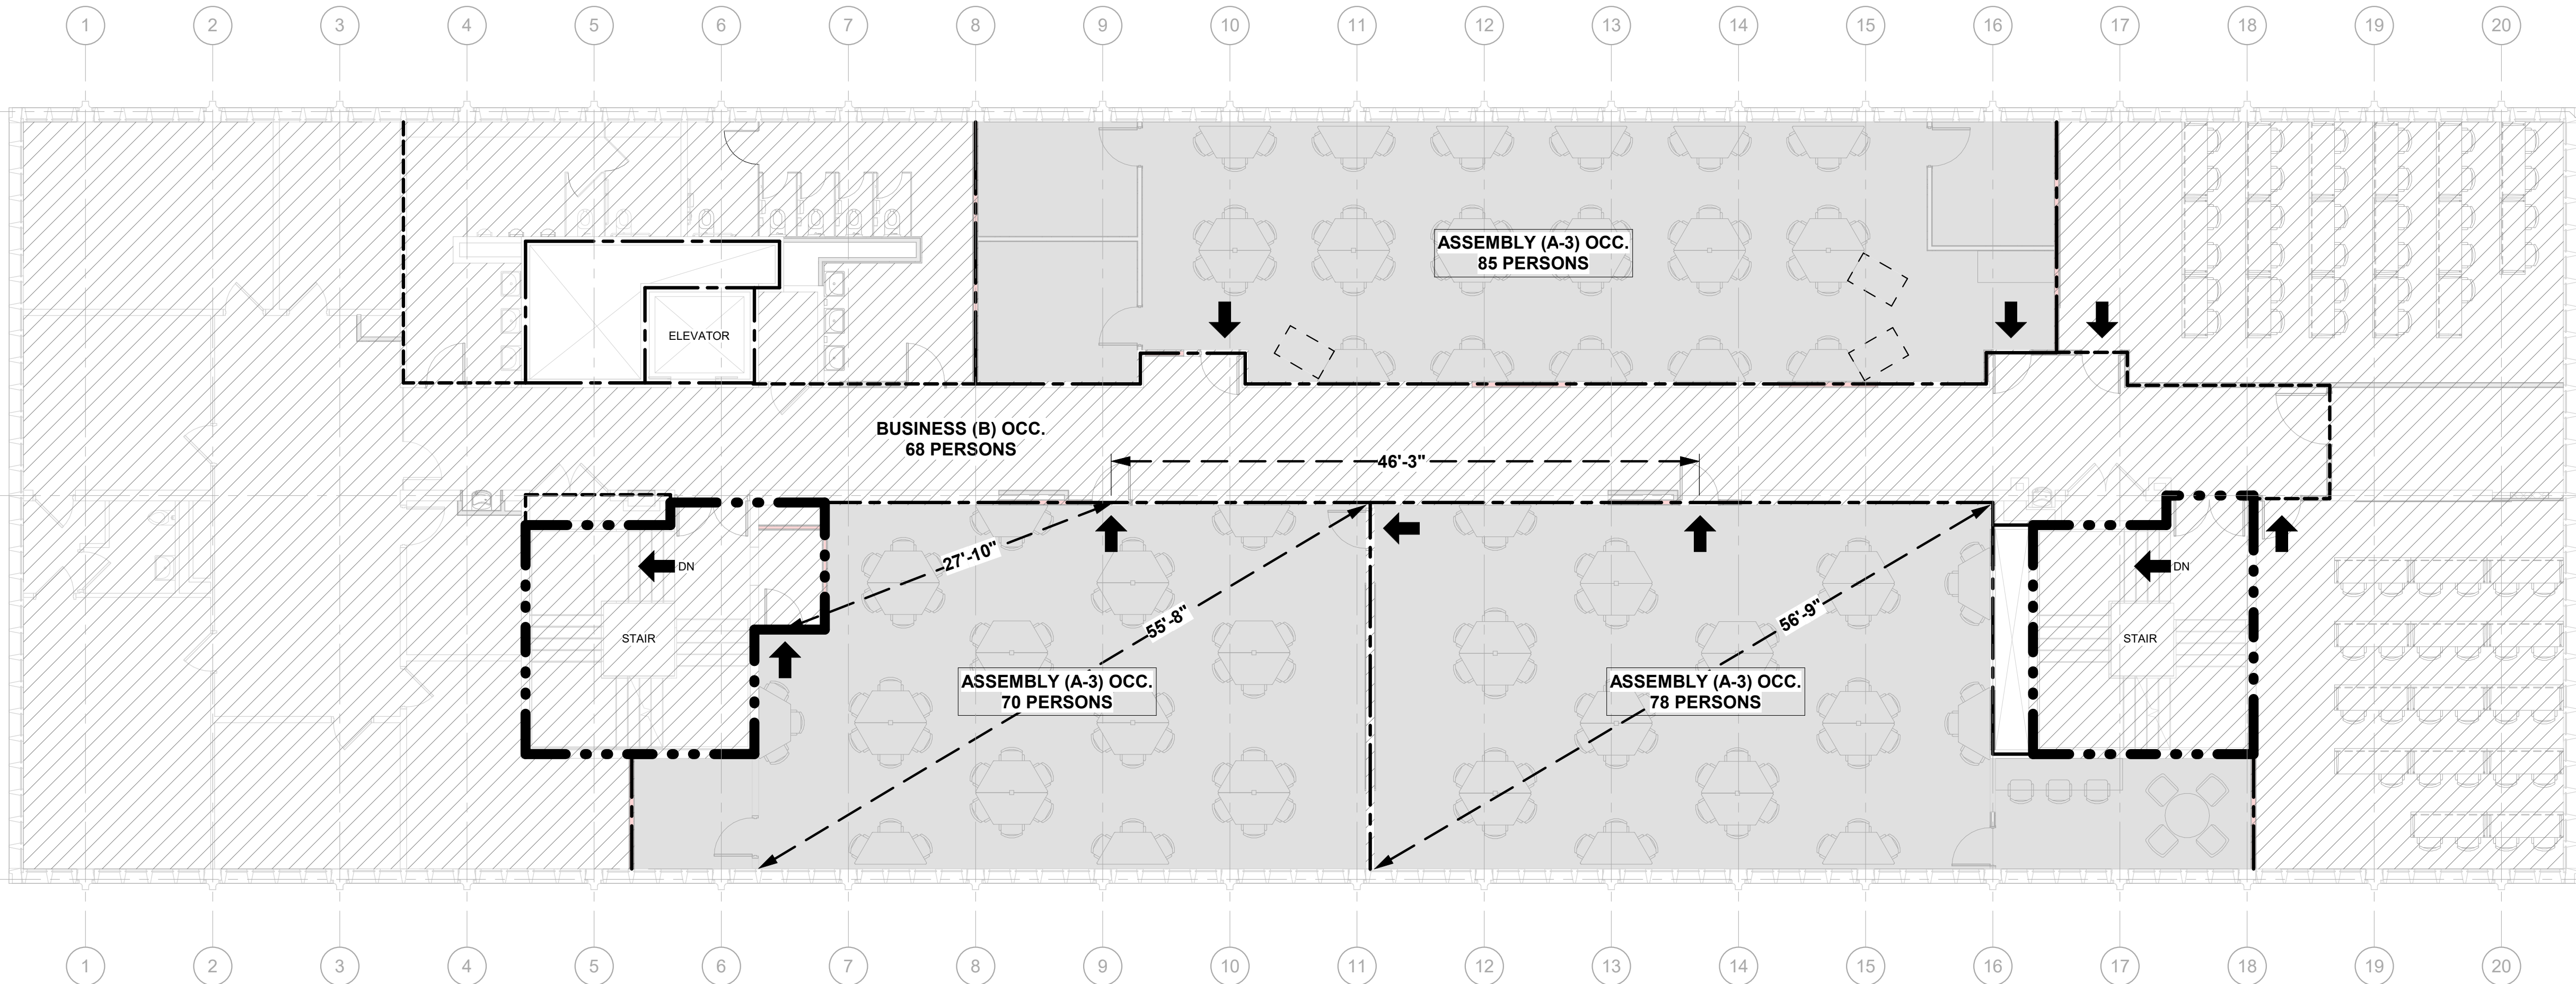

SECOND FLOOR LIFE SAFETY PLAN

SCALE: 1/8" = 1'-0"



BUILDING CODE INFORMATION:

THE DRAWINGS HAVE BEEN PREPARED IN ACCORDANCE WITH THE FOLLOWING CODES. NOTIFY THE ARCHITECT OF ANY CONFLICTS

CODES

2015 MICHIGAN REHABILITATION CODE (AS AMENDED) - Chapters 7 & 8
2015 MICHIGAN MECHANICAL CODE (AS AMENDED)
2015 MICHIGAN PLUMBING CODE (AS AMENDED)
2014 NATIONAL ELECTRIC CODE (NEC) (AS AMENDED - MICHIGAN AMENDMENTS PART 8 RULES)
2015 MICHIGAN ENERGY CODE
INTERNATIONAL ENERGY CONSERVATION CODE - 2009, SECTION 501.1
ANSI/ASHRAE/IESNA STANDARD 90.1-2007 (AS AMENDED)
2015 INTERNATIONAL FIRE CODE
2012 NFPA LSC
WSU FIRE SAFETY MANUAL
BARRIER FREE REQUIREMENTS:
AMERICANS WITH DISABILITIES ACT (ADA)
MBC-2015, CHAPTER 11
ICC A117.1-2009, EXCEPT SECTIONS 611 & 707

STANDARDS

WAYNE STATE UNIVERSITY CONSTRUCTION DESIGN STANDARDS - SECOND REVISION, SEP. 2012
WAYNE STATE UNIVERSITY C&IT DESIGN STANDARDS

ITEM

CODE SECTION

(INCL. AMENDMENTS)

CLASSIFICATION OF WORK

ALTERATION LEVEL 2 (MRC-CHAPTER 5)

BUILDING USE GROUP

MIXED USE, SEPARATED USES (MBC-SEC. 304)
B BUSINESS
A-3 ASSEMBLY

TYPE OF CONSTRUCTION

CONSTRUCTION TYPE IIB - ASSUMED (PARTIALLY SPRINKLERED) (MBC-SEC. 602)

FIRE RESISTANCE RATINGS OF STRUCTURAL ELEMENTS

ITEM	RATING (HOURS)	UL NO.	REMARKS
STRUCTURAL FRAME	0	---	(TABLE 601)
BEARING WALLS - EXT.	0	---	(TABLE 601)
INT.	0	---	(TABLE 601)
NONBEARING WALLS - EXT.	0	---	(TABLE 601)
INT.	0	---	(TABLE 601)
FLOOR CONSTRUCTION	0	---	(TABLE 601)
ROOF CONSTRUCTION	0	---	(TABLE 601)
SHAFT ENCLOSURES	0	---	(SEC. 707.4)
STAIR ENCLOSURES	0	---	(SEC. 707.4)

OCCUPANCY

SECOND FLOOR	
BUSINESS (B) OCCUPANCY	6.702 S.F./100 PER OCCUP. = 68 OCCUPANTS
ASSEMBLY (A-3) OCCUPANCY	4.706 S.F./20 PER OCCUP. = 233 OCCUPANTS
TOTAL	= 301 OCCUPANTS

EGRESS COMPONENTS (TABLE 1005.1)

OCCUPANCY: MIXED USE SEPARATED STAIRWAYS 0.2' OTHER COMPONENTS 0.15'
SECOND FLOOR: 302 PEOPLE x 0.15'/PERSON = 45.3 INCHES
PROVIDED: 2 DOORS @ 63 INCHES CLEAR = 126 INCHES

STAIRS: 302 PEOPLE x 0.2'/PERSON = 60.4 INCHES (36 MIN.)
PROVIDED: 2 STAIRS @ 65 INCHES CLEAR = 130 INCHES

PLUMBING FIXTURE COUNT

MINIMUM NUMBER OF PLUMBING FACILITIES (TABLE 403.1)

A-3 OCCUPANCY: 233 OCCUPANTS - 117 EACH GENDER

B OCCUPANCY: 68 OCCUPANTS - 34 EACH GENDER

MALE (REQUIRED - A-3)

1 W.C. (A-3) + 2 W.C. (B)
1 LAV. (A-3) + 1 LAV. (B)

FEMALE (REQUIRED - A-3)

2 W.C. (A-3) + 2 W.C. (B)
1 LAV. (A-3) + 1 LAV. (B)

OTHER (REQUIRED)

2 DRINKING FOUNTAIN
1 SERVICE SINK

MALE (PROVIDED)

2 W.C.
3 LAV.

3 URINALS

FEMALE (PROVIDED)

5 W.C.

3 LAV.

OTHER (PROVIDED)

2 DRINKING FOUNTAIN

1 SERVICE SINK

LIFE SAFETY NOTES:

- CLEAR UNOBSTRUCTED EGRESS TO BE MAINTAINED. ALL CONSTRUCTION MATERIALS AND EQUIPMENT SHALL BE STAGED WITHIN CONSTRUCTION AREAS OR DESIGNATED AREA AND NOT IN EGRESS CORRIDORS.
- MAINTAIN TEMPORARY 1 HOUR FIRE BARRIER BETWEEN CONSTRUCTION AREA AND ADJACENT OCCUPIED SPACES. PROVIDE DUST BARRIERS/CONTROL MEASURES FOR DUST GENERATING ACTIVITIES. DOORS TO CONSTRUCTION AREAS TO REMAIN CLOSED AT ALL TIMES TO SEPARATE CONSTRUCTION FROM ANY OCCUPIED AREAS. THE SECOND FLOOR IS UNOCCUPIED DURING PROJECT SCHEDULE. PROVIDE SIGNS INDICATING CONSTRUCTION ON STAIRWELL DOORS.
- CONSTRUCTION CONTRACTOR TO PROVIDE FIRE EXTINGUISHER WITHIN THE CONSTRUCTION SITE AT ALL TIMES DURING PROJECT.
- PLAN INDICATES BOTH NEW AND EXISTING RATED PARTITIONS. SEE FLOOR PLAN ON SHEET A101 FOR NEW RATED PARTITION LOCATIONS. MAINTAIN RATING AT EXISTING STAIR TOWERS AND MECHANICAL SHAFTS.

LIFE SAFETY LEGEND

- EXIT
- SMOKE-TIGHT PARTITION
- 1-HOUR FIRE RATED WALL ASSEMBLY
- 2-HOUR FIRE RATED WALL ASSEMBLY



WAYNE STATE
UNIVERSITY

ftc&h

engineers
scientists
architects
constructors

fishbeck, thompson, carr & huber, inc.
www.fth.com

Wayne State University

5201 Cass Ave, Detroit, MI 48202

Prentis Building Computer Lab Relocation

WSU Project: 022-313456

REVISIONS

08/23/2018 A3 ADDENDUM 3

8/13/2018 BIDS

Drawn By WPS/HMW

Designer WPS

Reviewer

Manager MMS

Hard copy is intended to be 24"x36" when plotted. Scale(s) indicated and graphic quality may not be accurate for any other size.


PROJECT NO.

180746


SECOND FLOOR LIFE
SAFETY PLAN

LS101


©Copyright 2018
All Rights Reserved

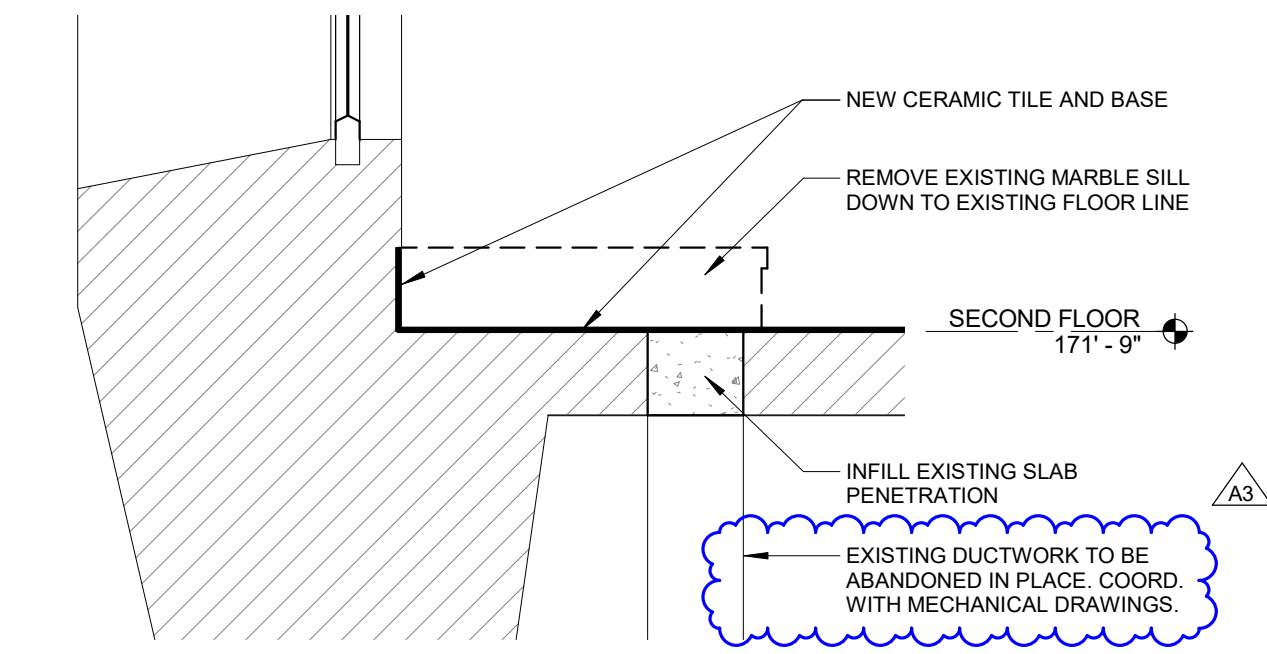

3 BATHROOM SILL DETAIL
SCALE: 1 1/2" = 1'-0"

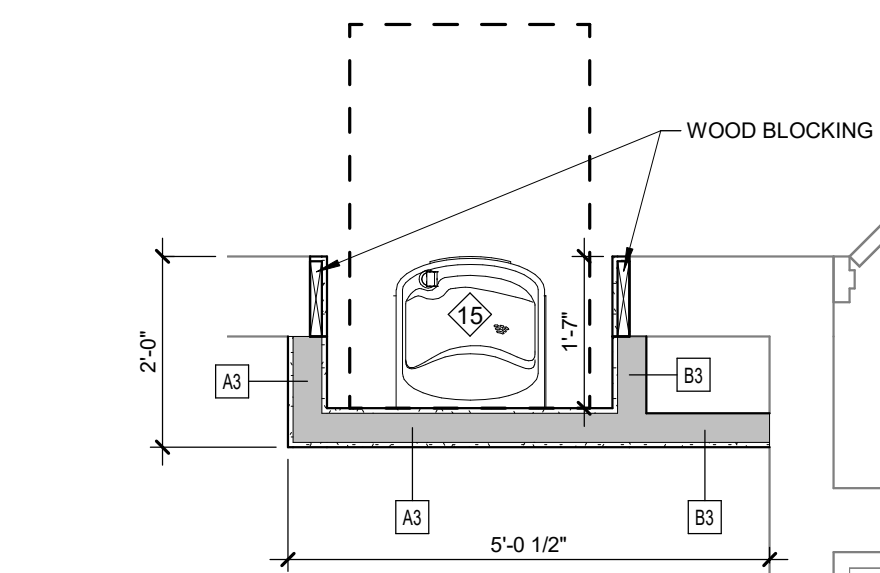

2 ENLARGED B.F. FOUNTAIN PLAN
SCALE: 1/2" = 1'-0"

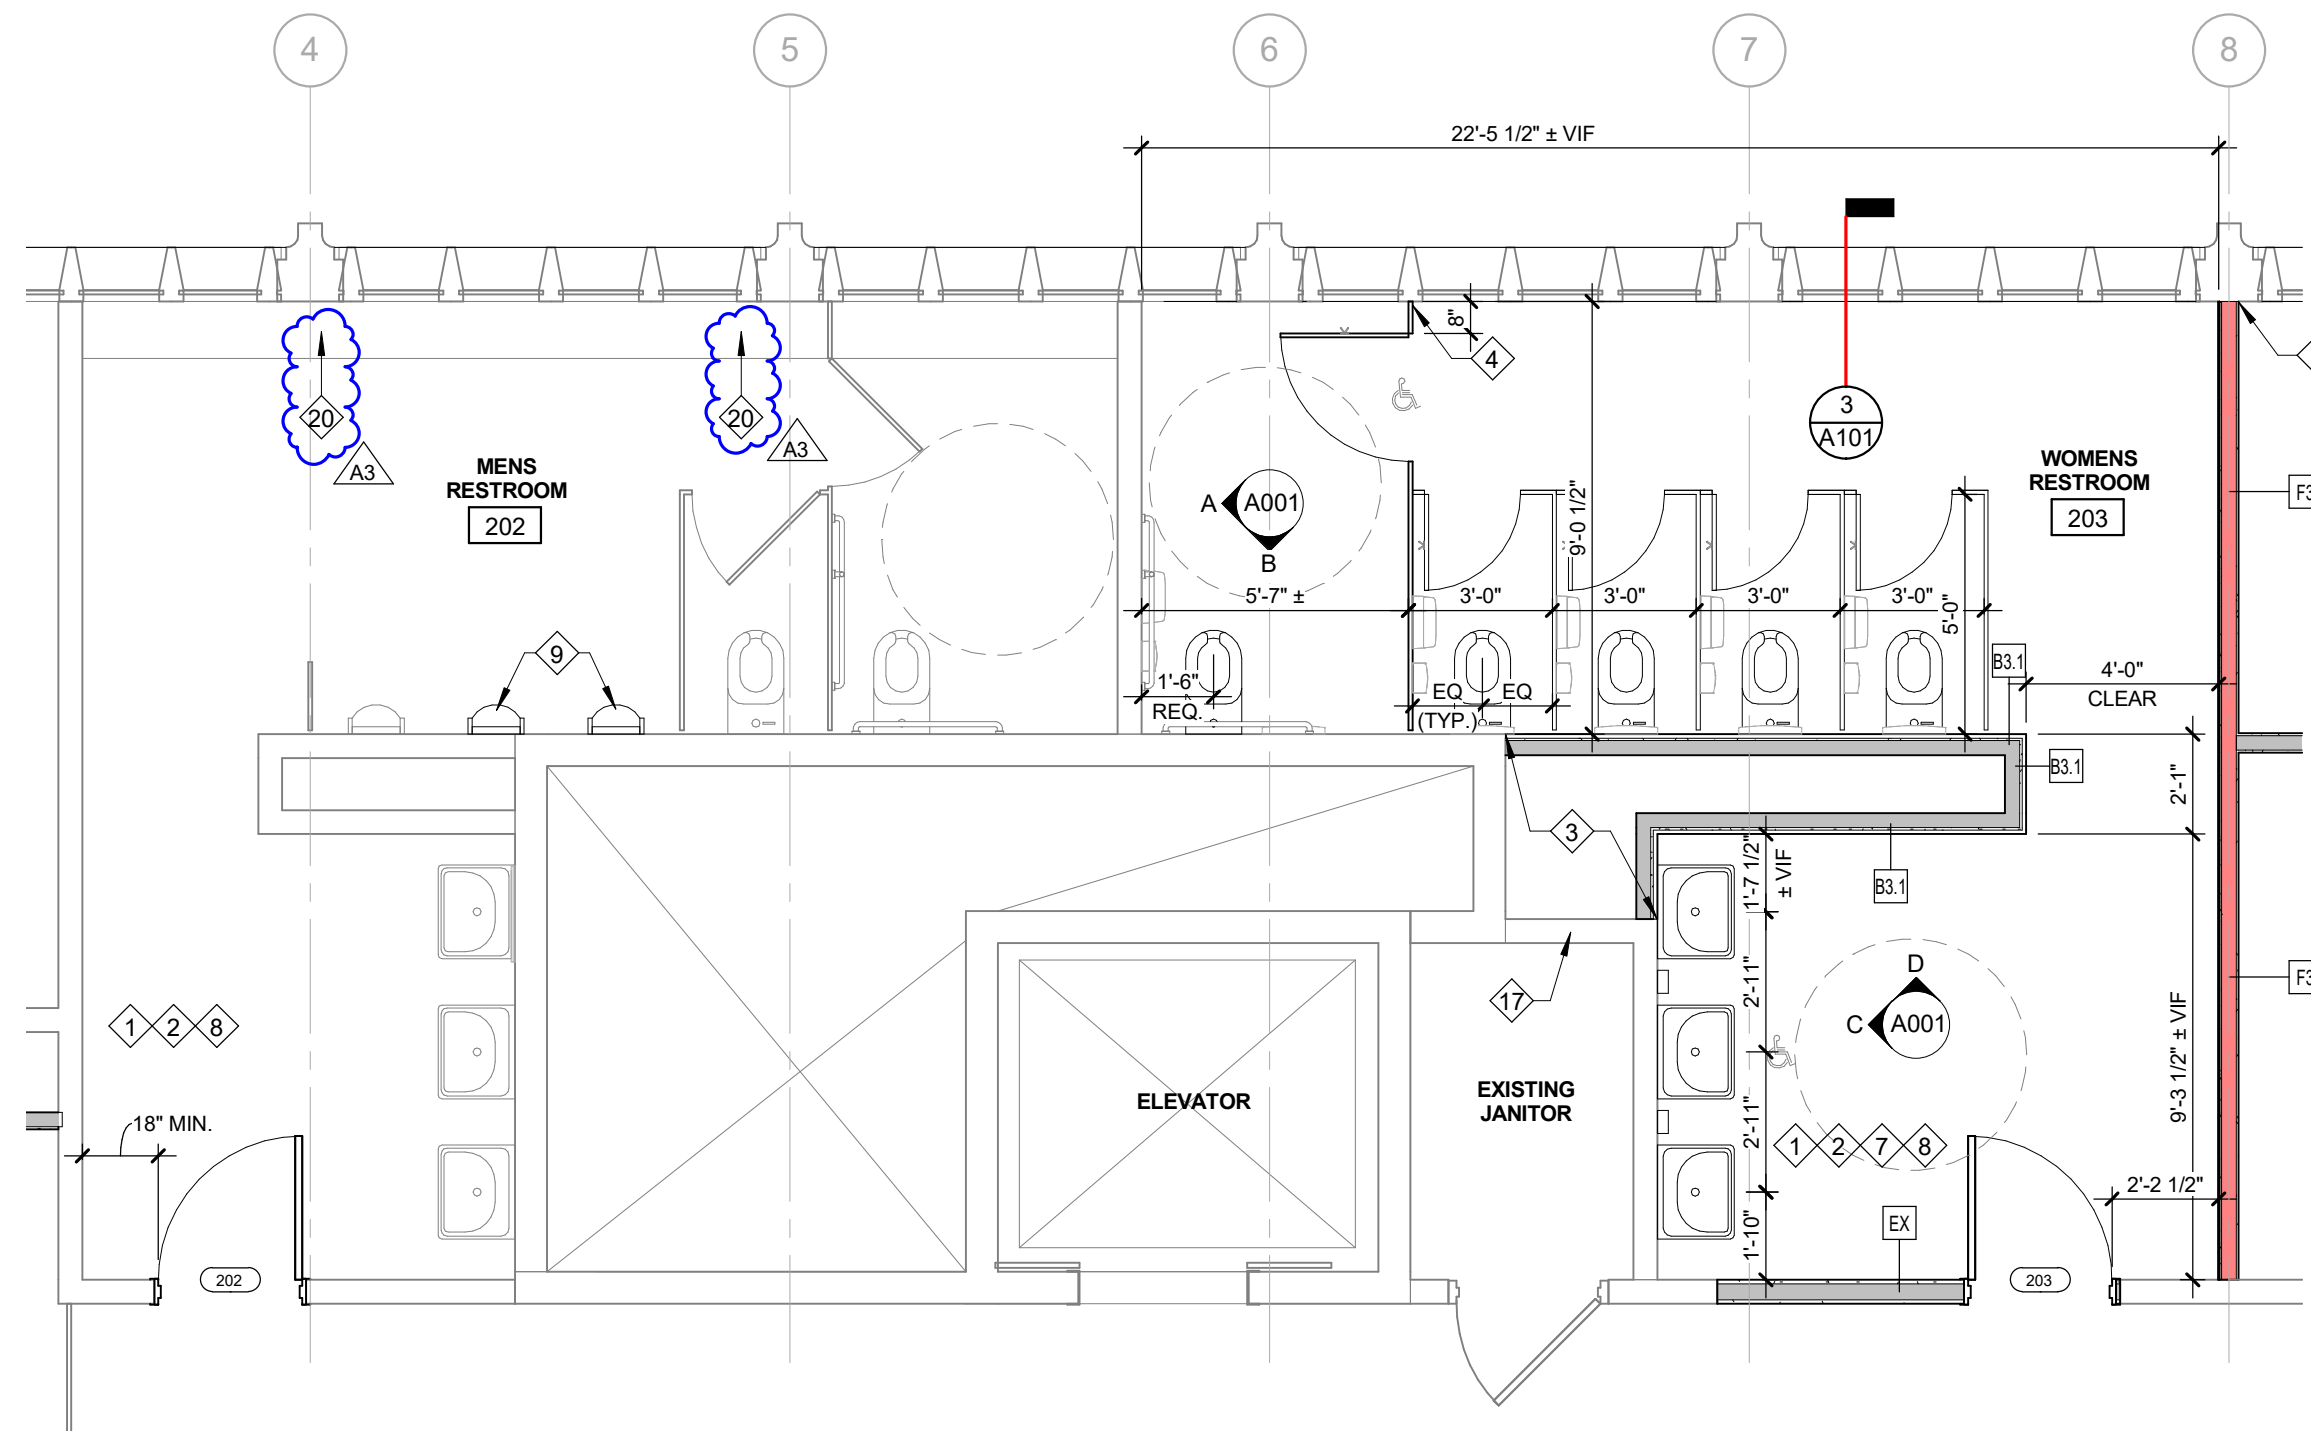


1 ENLARGED RESTROOM PLAN
SCALE: 1/4" = 1'-0"

FLOOR PLAN SYMBOL LEGEND

- INTERIOR WALL TYPE: SEE SHEET A201
- EXTERIOR WALL TYPE
- DOOR NUMBER
- BARRIER FREE/ADA ACCESSIBLE
- 1 HOUR FIRE RATING
- METAL STUD WALL
- CMU WALL
- CAST IN PLACE OR PRECAST CONCRETE
- EXISTING WALL
- EXISTING DOOR
- FLOOR DRAIN: SEE MECHANICAL

1 ARCHITECTURAL KEY NOTES

- PATCH AND REPAIR EXISTING WALLS AFFECTED BY DEMOLITION OR SCOPE OF WORK TO MATCH ADJACENT CONSTRUCTION AND FINISH. PREP WALLS TO RECEIVE NEW FINISHES AS INDICATED IN THE FINISH SCHEDULE.
- PATCH AND REPAIR ANY EXPOSED CONCRETE FLOOR AFFECTED BY DEMOLITION OR SCOPE OF WORK TO MATCH ADJACENT CONSTRUCTION AND FINISH. PATCH AND REPAIR ANY CRACKS IN CONCRETE SLAB WITH APPROPRIATE PATCHING MATERIAL. PREP FLOOR TO RECEIVE NEW FINISHES AS INDICATED IN THE FINISH SCHEDULE.
- ALIGN NEW PARTITION WITH EXISTING PARTITIONS TO REMAIN.
- CENTER NEW PARTITION ON EXISTING WINDOW MULLION.
- MATCH EXISTING WALL CONSTRUCTION TO PROVIDE FLUSH CONDITION AT ADJACENT PARTITIONS.
- ALL NEW FURNITURE AND ACCESSORIES PROVIDED AND INSTALLED BY OWNER. FURNITURE INDICATED ON PLAN IS FOR REFERENCE/SPACE PLANNING ONLY UNLESS OTHERWISE INDICATED. SEE ELECTRICAL PLANS FOR MORE INFORMATION ON FURNITURE POWER AND LOW VOLTAGE REQUIREMENTS.
- PROVIDE AND INSTALL TOILET AND SINK RESTROOM FIXTURES. SEE MECHANICAL AND PLUMBING PLANS.
- PROVIDE AND INSTALL RESTROOM ACCESSORIES PER ELEVATIONS AND BARRIER FREE DETAILS.
- REPLACE TWO EXISTING INTEGRATED FLOOR URINALS WITH WALL-MOUNTED URINALS TO MATCH EXISTING. PATCH WALL & FLOOR TO MATCH ADJACENT FINISHES.
- NEW FIRE RATED DOOR. SEE DOOR SCHEDULE.
- PROVIDE AND INSTALL NEW MAGNETIC GLASS MARKERBOARD. COORDINATE EXACT SIZE(S) AND LOCATION(S) WITH OWNER.
- EXISTING CAST CONCRETE WALL TO DECK. SEAL ALL PENETRATIONS WITH FIRE RATED CAULK APPROVED FOR CONCRETE MATERIAL.
- EXISTING METAL STUD AND GYP WALL TO DECK. SEAL ALL PENETRATIONS WITH FIRE RATED CAULK APPROVED FOR GYP MATERIAL.
- PROVIDE AND INSTALL BARRIER FREE DRINKING FOUNTAIN WITH BOTTLE FILLER. SEE PLUMBING AND ELECTRICAL DRAWINGS.
- NEW MINIMUM ENCLOSURE FOR DUCTWORK TO WOMEN'S RESTROOM CEILING. IF POSSIBLE, LOCATE ON WEST SIDE OF WALL INSIDE OFFICE. COORDINATE WITH MECHANICAL DRAWINGS AND EXISTING CONDITIONS.
- PROVIDE AND INSTALL NEW ACCESS PANEL INTO NEW CHASE.
- EXISTING CMU WALL TO DECK. SEAL ALL PENETRATIONS WITH FIRE RATED CAULK APPROVED FOR CONCRETE MATERIAL.
- INFILL EXISTING DOOR OPENING AND PROVIDE FURRING ON CLASSROOM-SIDE OF WALL TO PROVIDE FLUSH CONDITION.
- REMOVE EXISTING FLOOR REGISTERS. DUCTWORK TO BE ABANDONED. PROVIDE BLANKING PLATES TO MATCH EXISTING FLOOR REGISTER FINISH.

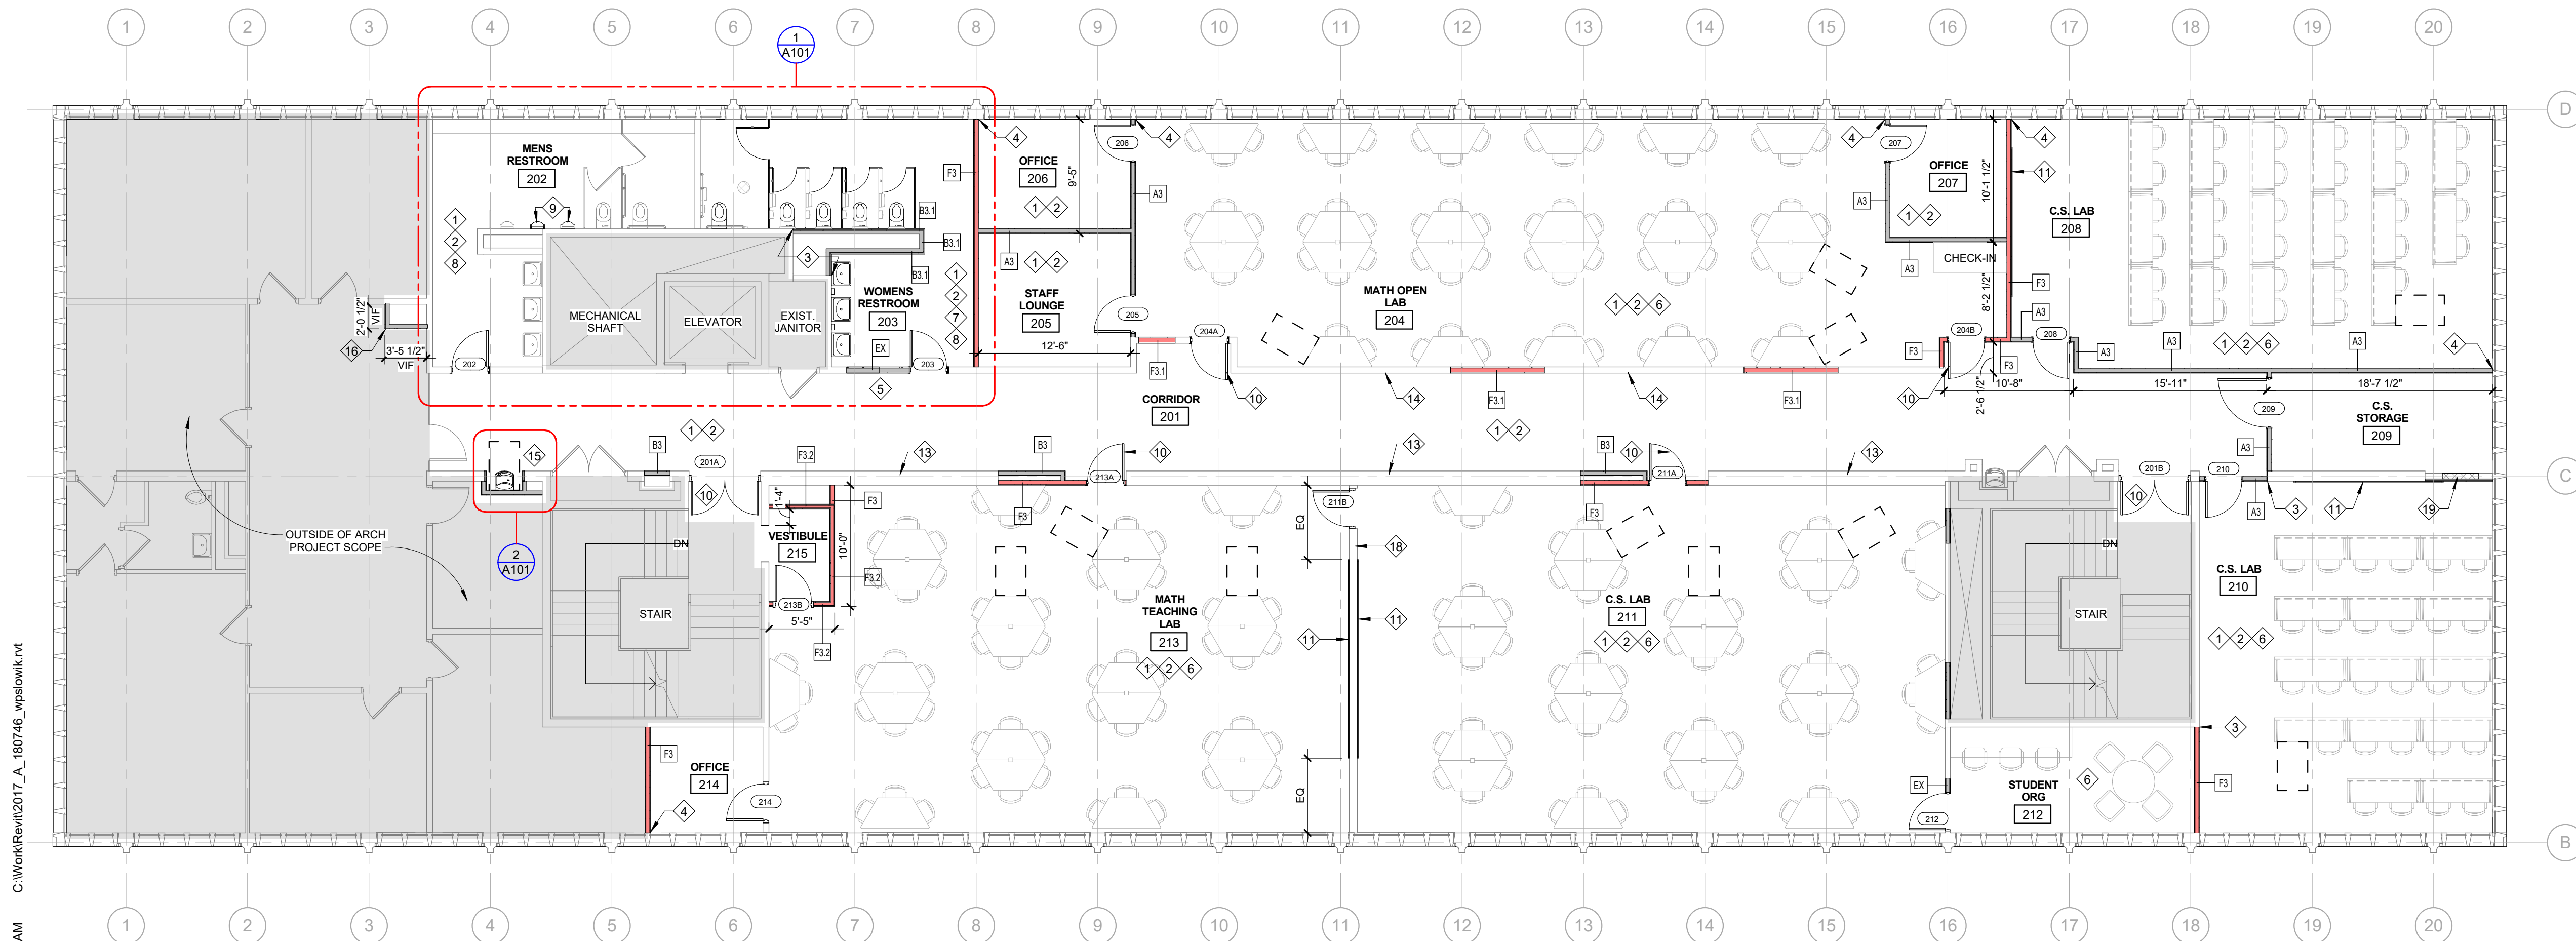

SECOND FLOOR PLAN
SCALE: 1/8" = 1'-0"



WAYNE STATE
UNIVERSITY

fitch

engineers
scientists
architects
constructors

fishbeck, thompson, carr & huber, inc.
www.fitch.com

Wayne State University

5201 Cass Ave, Detroit, MI 48202

Prentis Building Computer Lab Relocation
WSU Project: 022-313456

REVISIONS		
08/23/2018	A3	ADDENDUM 3

8/13/2018	BIDS
Drawn By	WPS / HNW
Designer	WPS
Reviewer	MDH
Manager	MM5

Hard copy is intended to be
24"x36" when plotted. Scale(s)
indicated and graphic quality may
not be accurate for any other size.

PROJECT NO.
180746

SECOND FLOOR PLAN


A101

©Copyright 2018
All Rights Reserved

PLOT INFO: 8/27/2018 8:53:18 AM C:\Work\Revit\2017_A_180746_wpslowk.rvt

8 HEAD DETAIL CMU

SCALE: 1 1/2" = 1'-0"

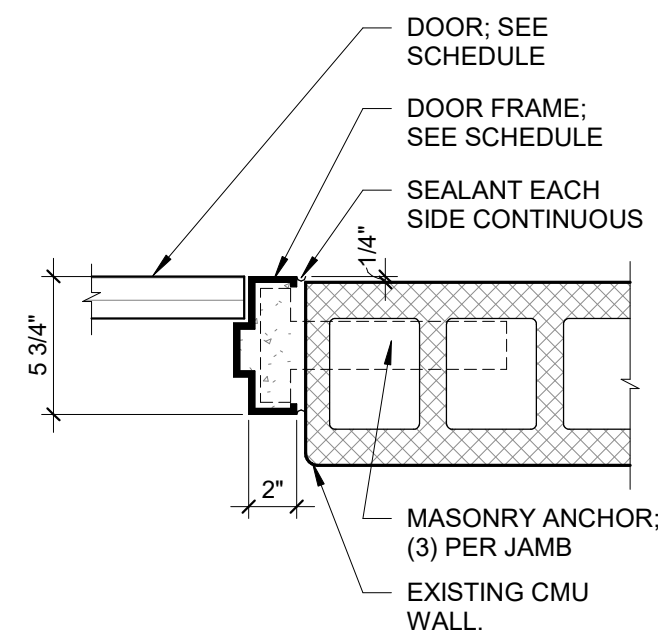


4 JAMB DETAIL CMU

SCALE: 1 1/2" = 1'-0"

7 HEAD DETAIL CONCRETE

SCALE: 1 1/2" = 1'-0"

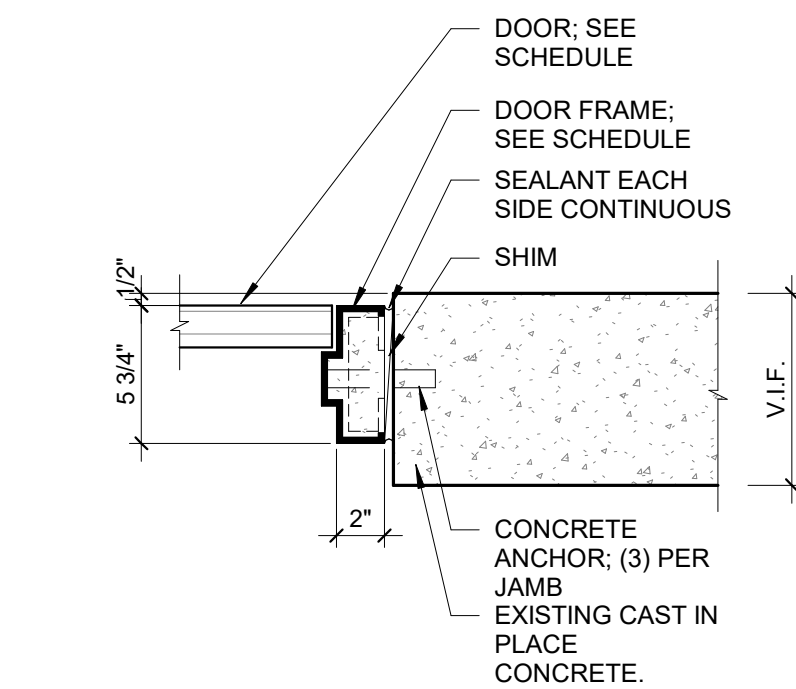


3 JAMB DETAIL CONCRETE

SCALE: 1 1/2" = 1'-0"

6 HEAD DETAIL 2HR FIRE RATED

SCALE: 1 1/2" = 1'-0"

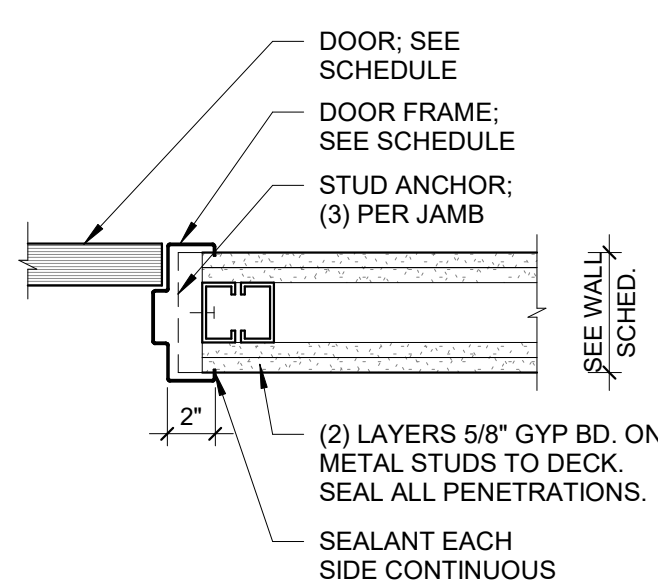


2 JAMB DETAIL 2HR FIRE RATED

SCALE: 1 1/2" = 1'-0"

5 HEAD DETAIL

SCALE: 1 1/2" = 1'-0"

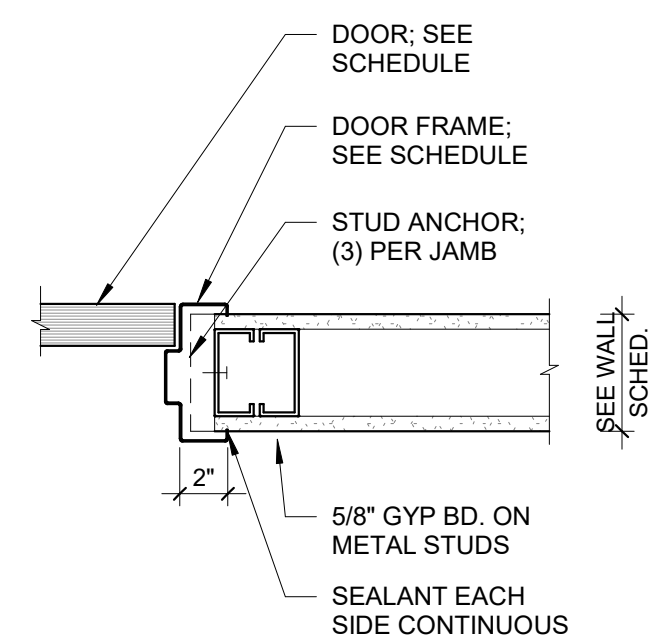


1 JAMB DETAIL

SCALE: 1 1/2" = 1'-0"


DOOR TYPES

SCALE: NOT TO SCALE

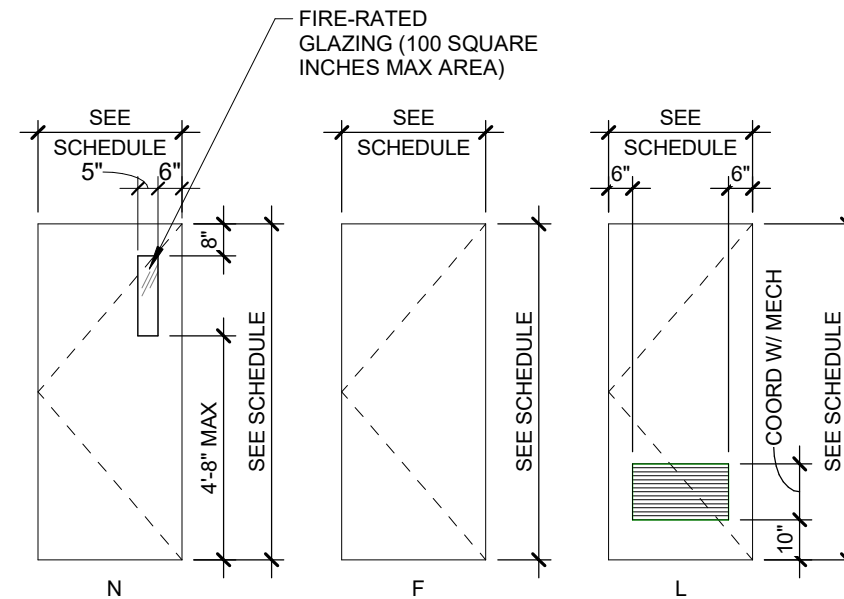


FRAME TYPES

SCALE: NOT TO SCALE

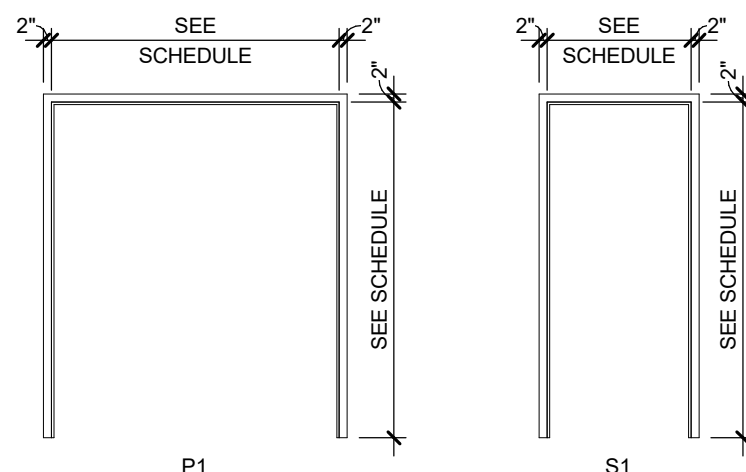


10 JAMB DETAIL MECH

SCALE: 1 1/2" = 1'-0"

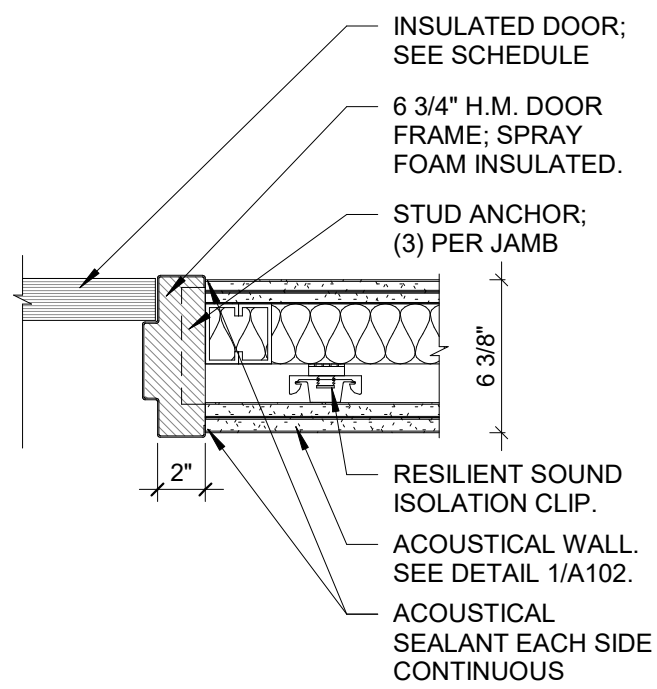

9 HEAD DETAIL MECH


SCALE: 1 1/2" = 1'-0"

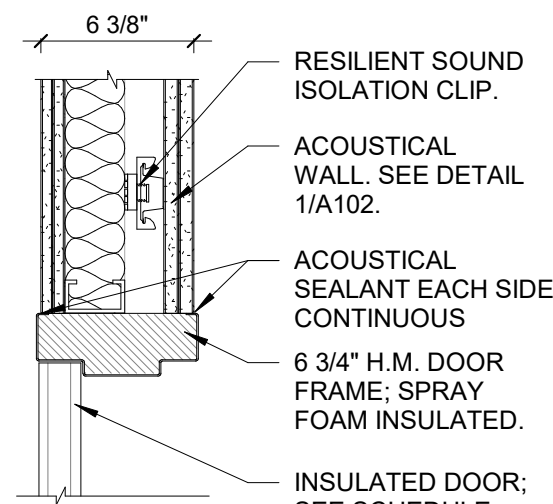

NO.	LOCATION	PANEL SIZE				DOOR					FRAME					LABEL	HDW	NOTES
		QTY	W	H	T	TYPE	MATERIAL	EXT FINISH	INT FINISH	GLASS	TYPE	MATERIAL	EXT FINISH	INT FINISH	HEAD			
SECOND FLOOR																		
201A	CORRIDOR	2	5'- 6.3/4"	7'- 6"	0'- 1.3/4"	F	HM	S	S	FRG	P1	HM	P	P	7	3	90 / B 04	
201B	CORRIDOR	2	5'- 6.3/4"	7'- 6"	0'- 1.3/4"	F	HM	S	S	FRG	P1	HM	P	P	7	3	90 / B 04	
202	MENS RESTROOM	1	3'- 0"	7'- 6"	0'- 1.3/4"	L	WD	S	S	--	S1	HM	P	P	5	1	05	
203	WOMENS RESTROOM	1	3'- 0"	7'- 6"	0'- 1.3/4"	L	WD	S	S	--	S1	HM	P	P	5	1	05	
204A	MATH OPEN LAB	1	3'- 0"	7'- 6"	0'- 1.3/4"	N	WD	S	S	FRG	S1	HM	P	P	5	1	45 / E 06	
204B	MATH OPEN LAB	1	3'- 0"	7'- 6"	0'- 1.3/4"	N	WD	S	S	FRG	S1	HM	P	P	5	1	45 / E 09	
205	STAFF LOUNGE	1	3'- 0"	7'- 0"	0'- 1.3/4"	F	WD	S	S	--	S1	HM	P	P	5	1	01	
206	OFFICE	1	3'- 0"	7'- 0"	0'- 1.3/4"	F	WD	S	S	--	S1	HM	P	P	5	1	01	
207	OFFICE	1	3'- 0"	7'- 0"	0'- 1.3/4"	F	WD	S	S	--	S1	HM	P	P	5	1	01	
208	C.S. LAB	1	3'- 0"	7'- 6"	0'- 1.3/4"	N	WD	S	S	FRG	S1	HM	P	P	5	1	20 / S 07	
209	C.S. STORAGE	1	4'- 0"	7'- 6"	0'- 1.3/4"	F	WD	S	S	--	S1	HM	P	P	5	1	20 / S 02	
210	C.S. LAB	1	3'- 0"	7'- 6"	0'- 1.3/4"	N	WD	S	S	FRG	S1	HM	P	P	5	1	20 / S 08	
211A	C.S. LAB	1	3'- 0"	7'- 6"	0'- 1.3/4"	N	WD	S	S	FRG	S1	HM	P	P	5	1	45 / E 09	
211B	C.S. LAB	1	3'- 0"	7'- 0"	0'- 1.3/4"	F	WD	S	S	--	S1	HM	P	P	8	4	45 / E 03	
212	STUDENT ORG	1	3'- 0"	7'- 0"	0'- 1.3/4"	F	WD	S	S	--	S1	HM	P	P	5	1	01	
213A	MATH TEACHING LAB	1	3'- 0"	7'- 6"	0'- 1.3/4"	N	WD	S	S	FRG	S1	HM	P	P	5	1	45 / E 09	
213B	MATH TEACHING LAB	1	3'- 0"	7'- 0"	0'- 1.3/4"	F	WD	S	S	--	S1	HM	P	P	6	2	90 / B 06	
214	OFFICE	1	3'- 0"	7'- 0"	0'- 1.3/4"	F	WD	S	S	--	S1	HM	P	P	5	1	01	
THIRD FLOOR																		
301	MECHANICAL EQUIPMENT	1	4'- 0"	7'- 6"	0'- 1.3/4"	F	HM	P	P	--	S1	HM	P	P	9	10	02	
ABBREVIATIONS																		
HM	HOLLOW METAL																	
L	LOUVERED																	
P	PAINT																	
S	STAIN																	
FRG	FIRE RATED GLAZING																	
WD	WOOD																	
GENERAL NOTES:																		
A. PAINT EXISTING TO REMAIN DOORS AND FRAMES TO MATCH ADJACENT WALL COLOR. REFER TO FINISH LEGEND FOR MORE INFORMATION.																		
B. STAIN WOOD DOORS TO MATCH EXISTING DOORS TO REMAIN IN AREAS NOT IN SCOPE.																		
DOOR SCHEDULE NOTES:																		
1. USE EXISTING OPENING FOR NEW CORRIDOR DOORS AND FRAMES.																		
2. INSULATED DOOR AND FRAME.																		
3. MATCH EXISTING HEIGHT AT DOORS ADJACENT TO CORRIDOR.																		

CONSTRUCTION	WALL TYPES			
	CLG	MTL STUDS	CLG	MTL STUDS
TYPICAL A3	CONTINUE GYP BOARD TO STRUCTURE ABOVE AT FIRE RATED AND ACOUSTICAL WALLS	6" MAX	CONTINUE GYP BOARD TO STRUCTURE ABOVE AT FIRE RATED AND ACOUSTICAL WALLS	6" MAX
	(1) LAYERS 5/8" GYP. BD. EA. SIDE		5/8" GYP. BD. ONE SIDE	
TYPICAL B3	CONTINUE GYP BOARD TO STRUCTURE ABOVE AT FIRE RATED AND ACOUSTICAL WALLS	6" MAX	CONTINUE GYP BOARD TO STRUCTURE ABOVE AT FIRE RATED AND ACOUSTICAL WALLS	6" MAX
	(1) LAYERS 5/8" GYP. BD. EA. SIDE		5/8" GYP. BD. ONE SIDE	
TYPICAL F3	CONTINUE GYP BOARD TO STRUCTURE ABOVE AT FIRE RATED AND ACOUSTICAL WALLS	6" MAX	CONTINUE GYP BOARD TO STRUCTURE ABOVE AT FIRE RATED AND ACOUSTICAL WALLS	6" MAX
	(1) LAYERS 5/8" GYP. BD. EA. SIDE		5/8" GYP. BD. ONE SIDE	
TYPICAL EX	CONTINUE GYP BOARD TO STRUCTURE ABOVE AT FIRE RATED AND ACOUSTICAL WALLS	6" MAX	CONTINUE GYP BOARD TO STRUCTURE ABOVE AT FIRE RATED AND ACOUSTICAL WALLS	6" MAX
	(1) LAYERS 5/8" GYP. BD. EA. SIDE		5/8" GYP. BD. ONE SIDE	
WALL TAG WITH "EX" SUFFIX INDICATES TO MATCH EXISTING CONSTRUCTION, VERIFY IN FIELD EXISTING CONSTRUCTION OF WALL				
AT RATED ASSEMBLY ONLY				
SEE LIFE SAFETY PLANS FOR LOCATIONS OF RATINGS AND DURATION REQUIREMENTS				
LEGEND	WALL TAG WITH "EX" SUFFIX INDICATES TO MATCH EXISTING CONSTRUCTION, VERIFY IN FIELD EXISTING CONSTRUCTION OF WALL			
	WALL TAG WITH "EX" SUFFIX INDICATES TO MATCH EXISTING CONSTRUCTION, VERIFY IN FIELD EXISTING CONSTRUCTION OF WALL			
A	WALL TAG WITH "EX" SUFFIX INDICATES TO MATCH EXISTING CONSTRUCTION, VERIFY IN FIELD EXISTING CONSTRUCTION OF WALL			
	WALL TAG WITH "EX" SUFFIX INDICATES TO MATCH EXISTING CONSTRUCTION, VERIFY IN FIELD EXISTING CONSTRUCTION OF WALL			
B	WALL TAG WITH "EX" SUFFIX INDICATES TO MATCH EXISTING CONSTRUCTION, VERIFY IN FIELD EXISTING CONSTRUCTION OF WALL			
	WALL TAG WITH "EX" SUFFIX INDICATES TO MATCH EXISTING CONSTRUCTION, VERIFY IN FIELD EXISTING CONSTRUCTION OF WALL			
F	WALL TAG WITH "EX" SUFFIX INDICATES TO MATCH EXISTING CONSTRUCTION, VERIFY IN FIELD EXISTING CONSTRUCTION OF WALL			
	WALL TAG WITH "EX" SUFFIX INDICATES TO MATCH EXISTING CONSTRUCTION, VERIFY IN FIELD EXISTING CONSTRUCTION OF WALL			

WALL TYPE NOTES

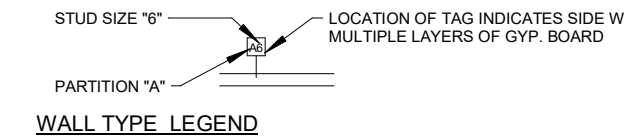

1. PROVIDE DEFLECTION TRACKS OR CLIPS FOR ALL PARTITIONS ABUTTING STRUCTURE ABOVE.
2. EXTEND RATED PARTITIONS THROUGH THE INTERIOR FACE OF EXTERIOR WALL GYPSUM BOARD AND SEAL TO THE INSIDE FACE OF THE EXTERIOR BUILDING WALL SHEATHING.
3. INTERIOR METAL STUD PARTITIONS ARE DIMENSIONED FROM FACE OF GYPSUM BOARD OR TILE BACKER BOARD.
4. MAINTAIN THE FIRE-PROTECTION RATINGS FOR ALL OPENINGS IN RATED PARTITIONS.
5. CONSTRUCT ALL CORRIDOR WALLS TO RESIST THE PASSAGE OF SMOKE. I.E., TO BE SMOKE TIGHT.
6. WHERE THICKNESS VARIES BETWEEN TWO PARTITIONS IN AN UNINTERRUPTED CONTINUOUS WALL PLANE - OFFSET STUDS AND ALIGN FACE OF PARTITIONS.
7. METAL STUD FRAMING: MIN. 24 GAGE @ 16" O.C., U.N.O.
8. UL DESIGN NUMBERS REFER TO THE UNDERWRITERS LABORATORIES FIRE RESISTANCE DIRECTORY-LATEST EDITION.
9. FIRE RATED PARTITIONS SHALL HAVE FIRESTOP SEALANT AT THE HEAD, SILL, THROUGH PENETRATIONS, OPENINGS AND JUNCTURES WITH DISSIMILAR MATERIALS.
10. BEHIND WALL TILE PROVIDE 5/8" CEMENT BOARD IN LIEU OF GYP. BOARD. HOLD TOP OF CEMENT BOARD 1/2" BELOW TOP OF TILE AS DETAILED.
11. EXTEND ALL WALLS TIGHT TO DECK ABOVE UNLESS NOTED OR DETAILED OTHERWISE.
12. ALL RECESSED DEVICES SHALL BE OFF-SET BY MINIMUM OF ONE STUD CAVITY. DO NOT INSTALL BACK TO BACK OR WITHIN SAME STUD CAVITY.
13. PROVIDE BLOCKING IN WALL REQ'D TO SUPPORT BUILT-IN ITEMS, FIXTURES, MILLWORK, AND OTHER WALL SUPPORTED ITEMS.
14. SEE LIFE SAFETY PLANS FOR LOCATION AND DURATION OF RATED ASSEMBLIES.

FIRE AND SMOKE RATED WALL IDENTIFICATION

1. ALL RATED FIRE WALLS, FIRE BARRIERS, FIRE PARTITIONS, SMOKE BARRIERS AND SMOKE PARTITIONS OR ANY OTHER WALL REQUIRED TO HAVE PROTECTED OPENINGS OR PENETRATIONS SHALL HAVE RED PAINTED STENCIL LETTERS (3" TALL MIN. WITH 3/8" WIDE STROKE) READING SPECIFIC RATING (I.E. 1-HOUR FIRE BARRIER) APPLIED TO WALL AROUND INTERIOR PERIMETER OF THE ROOM, EACH SIDE OF WALL, AND LOCATED ABOVE ACCESSIBLE CEILINGS. STENCIL TO BE SPACED A MAX. OF 12'-0" APART, BUT NO LESS THAN TWICE PER WALL FOR WALLS LONGER THAN 8'-0" IN LENGTH, AT LEAST ONCE FOR WALLS LESS THAN 8'-0" LONG, AND NO MORE THAN 8'-0" FROM WALL BEGINNING AND END; EXCEPT WHERE TOP OF WALL EXPOSED TO VIEW.



WAYNE STATE UNIVERSITY

fitch

engineers
scientists
architects
constructors

fishbeck, thompson, carr & huber, inc.
www.fitch.com

Wayne State University

5201 Cass Ave, Detroit, MI 48202

Prentis Building Computer Lab Relocation

WSU Project: 022-313456

REVISIONS

08/23/2018 A3 ADDendum 3

8/13/2018 BIDS

Drawn By WPS /HWW

Designer WPS

Reviewer MMH

Manager MMS

Hard copy is intended to be 24"x36" when plotted. Scale(s) indicated and graphic quality may not be accurate for any other size.



PROJECT NO.

180746


WALL TYPES & DOOR SCHEDULE

A201


©Copyright 2018
All Rights Reserved

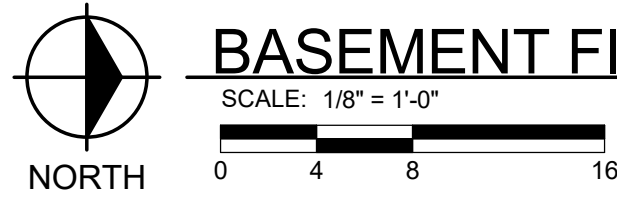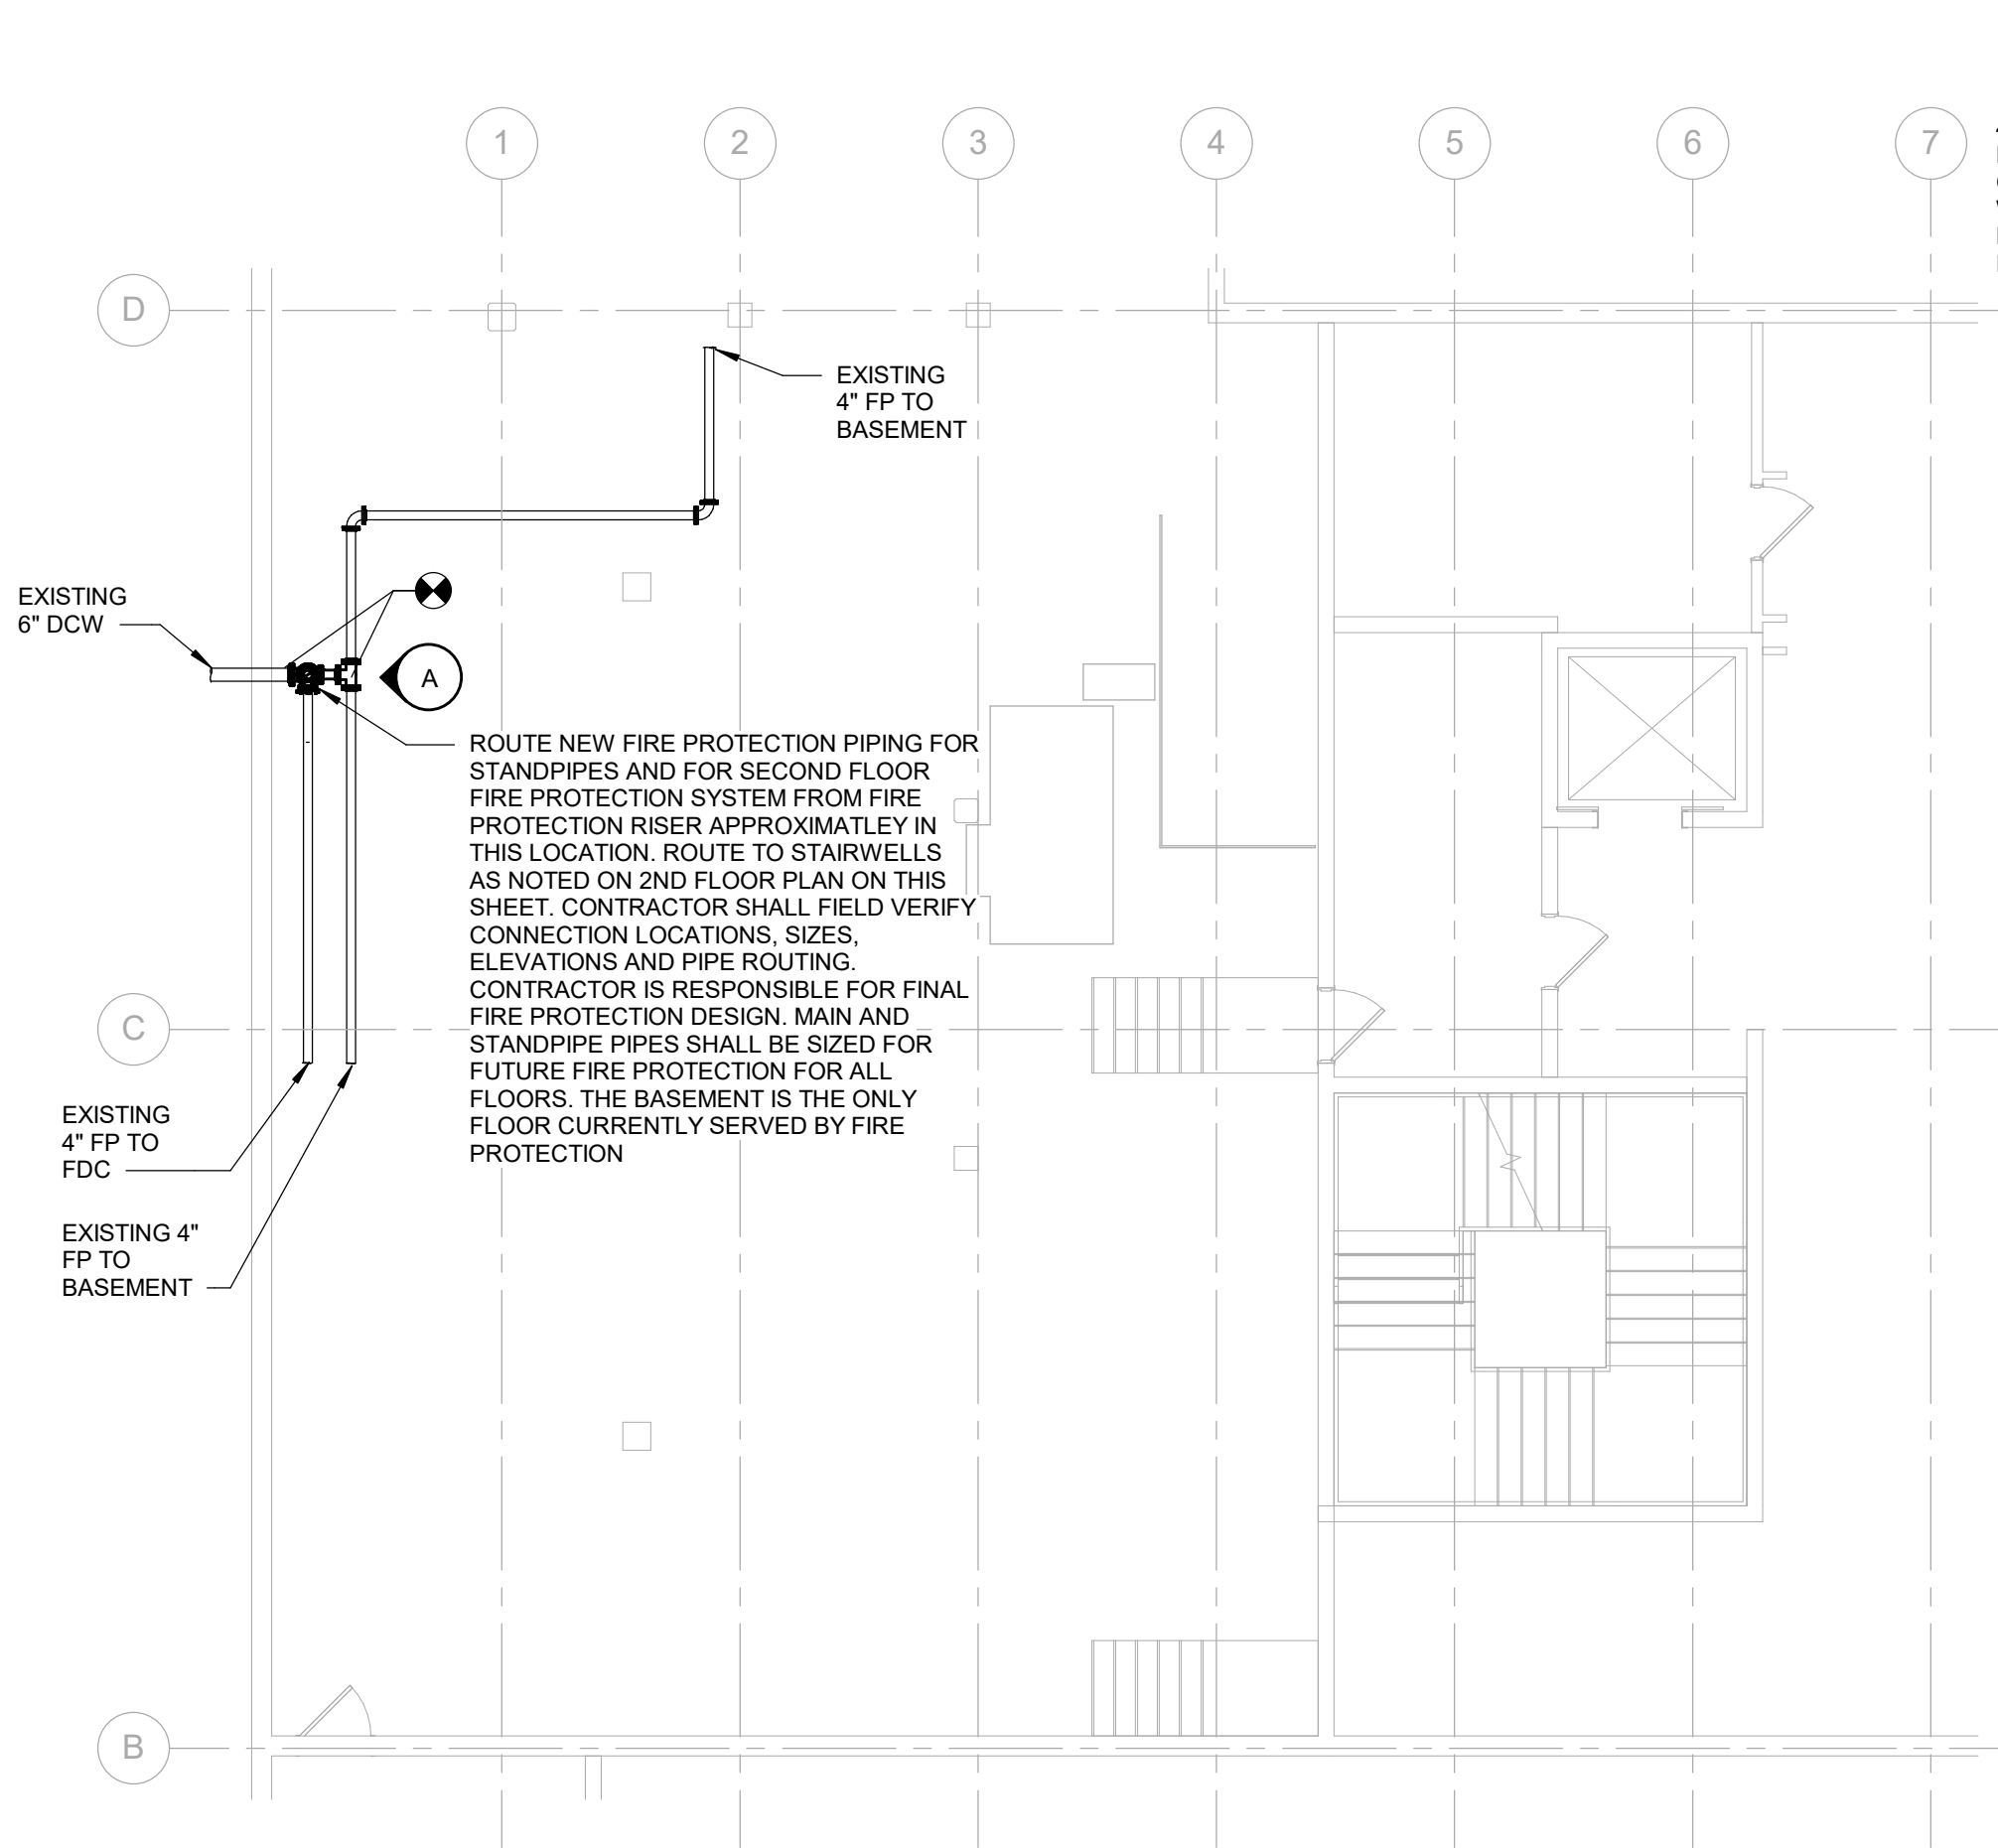

BASEMENT FIRE PROTECTION PLAN - PARTIAL

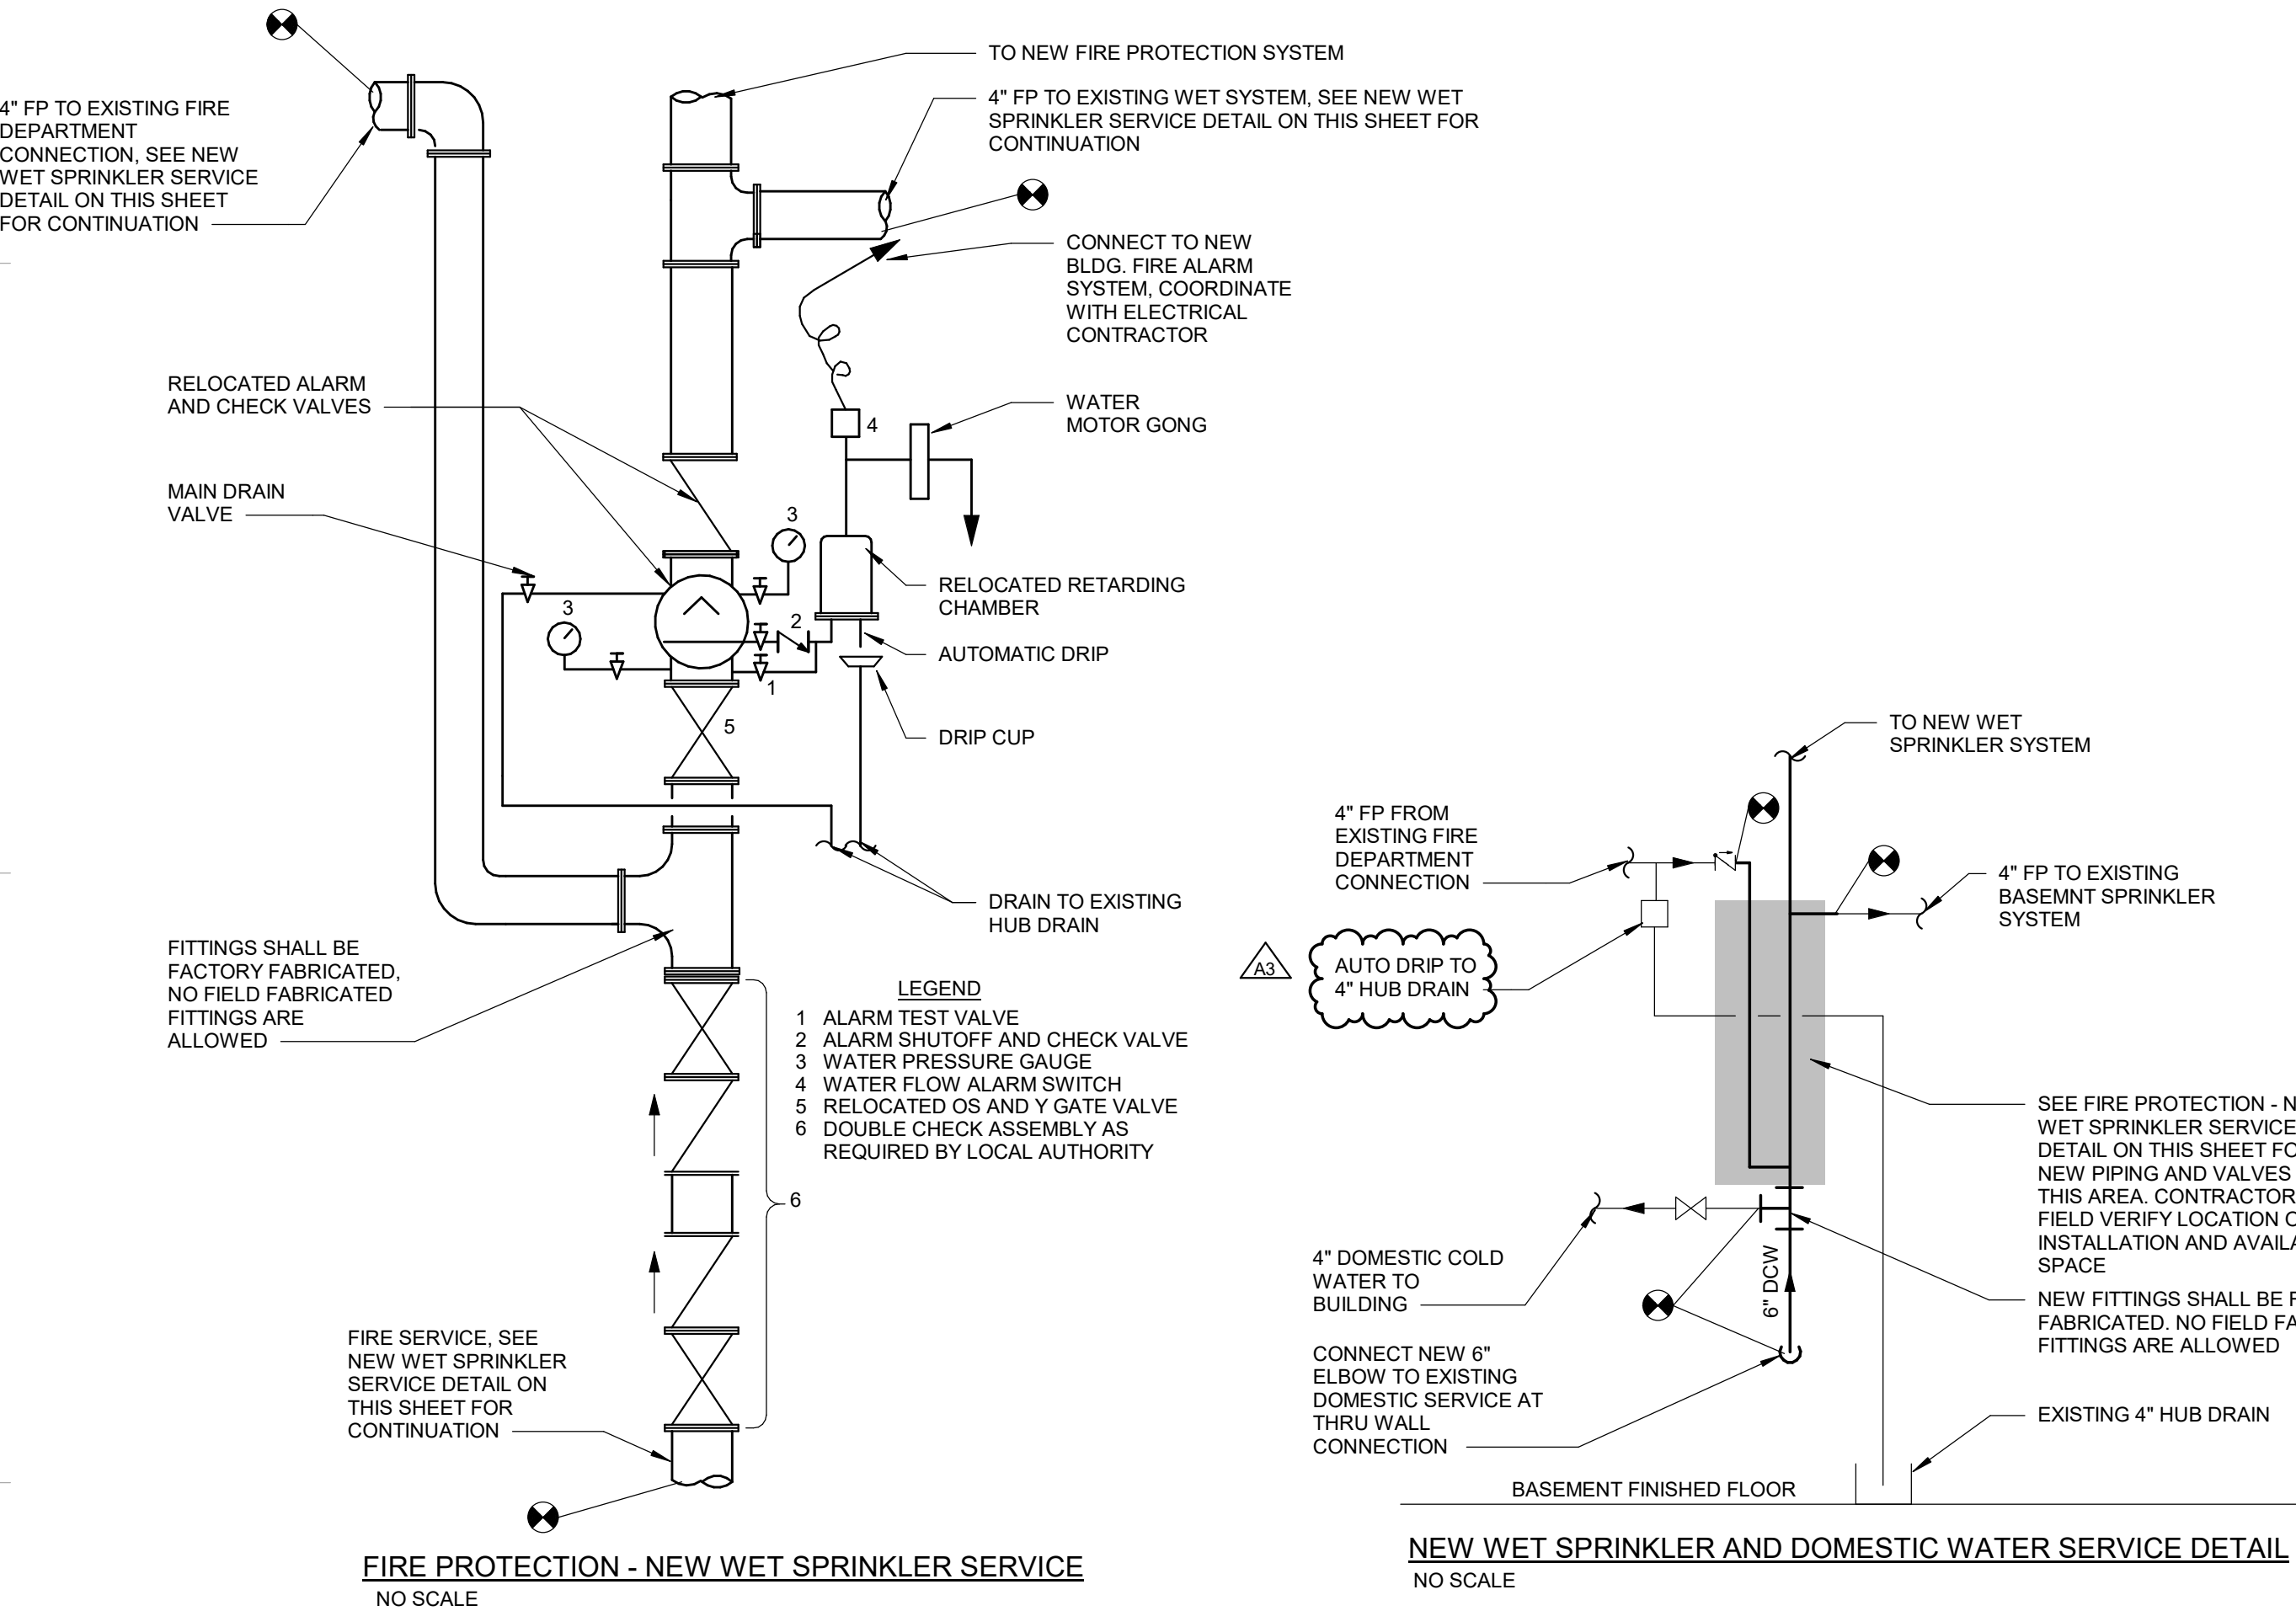



NEW WET SPRINKLER AND DOMESTIC WATER SERVICE DETAIL
NO SCALE

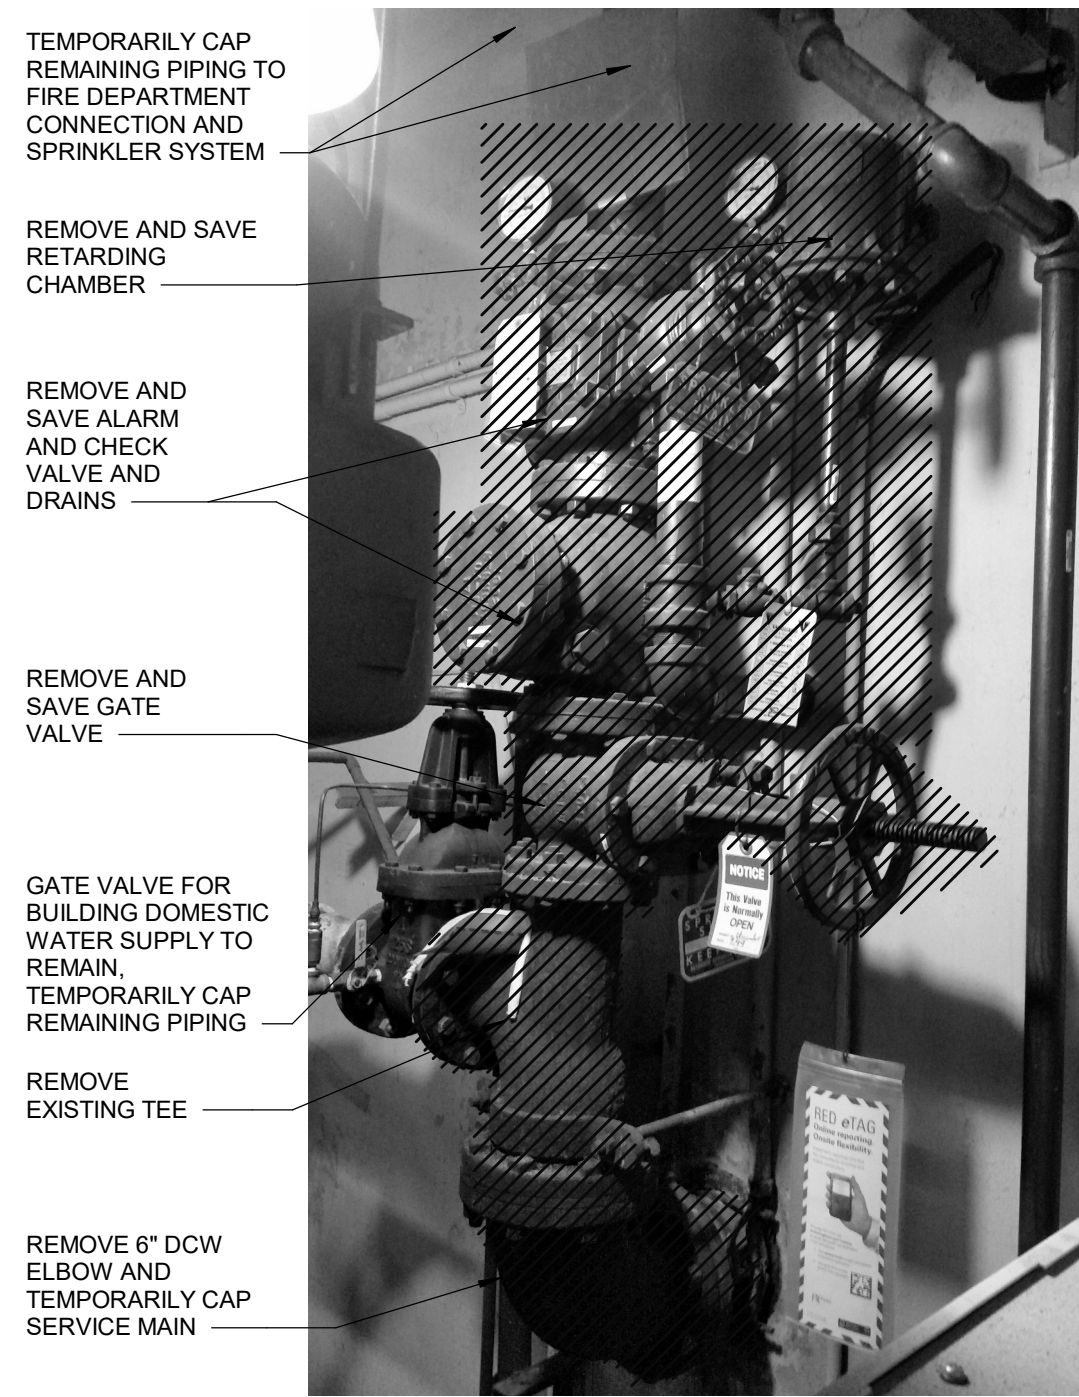

EXISTING AUTOMATIC SPRINKLER RISER AND DOMESTIC WATER SERVICE MAIN CONNECTION

NOTES

1. REMOVE ALL PORTIONS OF WORK IDENTIFIED BY CROSS HATCHING UNLESS NOTED OTHERWISE.
 2. FIELD DETERMINE EXACT LOCATIONS AND REMOVE PORTIONS OF PIPING AND EQUIPMENT SHOWN BY CROSS-HATCHING. SCHEDULE SHUT-DOWNS WITH OWNER. CAP ALL OPEN PIPE ENDS AT END OF WORK DAY. REFER TO OTHER DRAWINGS FOR COORDINATION OF EXTENT OF DEMOLITION WITH NEW WORK.
 3. UTILITIES PASSING FROM ONE PHASE TO ANOTHER THAT ARE ACTIVELY SERVING OCCUPIED AREAS SHALL REMAIN IN SERVICE IN THEIR PRESENT POSITION, OR SHALL BE REROUTED AND RECONNECTED TO THE EXTENT NECESSARY TO INSTALL THE NEW WORK OF THE CURRENT CONSTRUCTION PHASE.
 4. OPENINGS LEFT BY DEMOLITION IN WALLS AND FLOORS SHALL BE PATCHED TO MATCH SURROUNDING SURFACES.
 5. WHERE DEMOLITION REQUIRES THE REMOVAL OF CEILINGS, PROVIDE REMOVAL AND REINSTALLATION OF CEILINGS, DAMAGED CEILING TILES AND GRID SHALL BE REPLACED.
 6. FIRESTOP SHALL BE PROVIDED IN NEW AND EXISTING HOLES AND PENETRATIONS IN RATED WALLS IN AREAS OF NEW AND DEMOLITION WORK.
 7. PROVIDE ISOLATION, DRAIN AND FILLING OF PIPING SYSTEMS AS REQUIRED TO PERFORM THE WORK OF DEMOLITION.
 8. REMOVE ALL POWER AND CONTROL WIRING AND DEVICES ASSOCIATED WITH EQUIPMENT BEING REMOVED.
 9. ALL EXISTING CONDITIONS NOT SHOWN, CONTRACTOR SHALL FIELD VERIFY EXISTING CONDITIONS.
 10. EXISTING CONDITIONS SHOWN ARE BASED ON MINORU YAMASAKI AND ASSOCIATES DRAWINGS (PROJECT 6015), DATED 5-7-1962.
 11. CONTRACTOR SHALL BE RESPONSIBLE FOR SYSTEM DESIGN CALCULATIONS AND FINAL PIPE SIZES AND FOR COMPLIANCE WITH ALL STATE AND LOCAL CODES.
 12. CEILING GRID AND TILES SHALL BE REMOVED AND REPLACED AS REQUIRED TO ACCESS THE WORK. DAMAGED GRID AND TILE SHALL BE REPLACED TO MATCH EXISTING.
 13. ABOVE CEILING AREAS OF WOOD CONSTRUCTION AND OTHER COMBUSTIBLES ARE SHOWN AS REQUIRED BY NFPA, LATEST EDITIONS.
 14. FINAL FIRE PROTECTION PIPING ROUTING, AS DESIGNED BY FIRE PROTECTION CONTRACTOR, SHALL BE COORDINATED WITH OTHER TRADES BEFORE PROCEEDING. DUCTWORK AND STORM, SANITARY AND VENT PIPING LOCATION SHALL TAKE PRECEDENCE OVER FIRE PROTECTION PIPING.
 15. A WET PIPE SPRINKLER SYSTEM SHALL BE PROVIDED TO COVER THE ENTIRE 2ND FLOOR AREA SHOWN. SPRINKLER FOR A LIGHT HAZARD OCCUPANCY AT A DENSITY OF 0.1 GPM/SQ.FT. OVER THE MOST REMOTE 1500 SQ.FT. AS REQUIRED BY NFPA, LATEST EDITIONS.
 16. CITY WATER FLOW TEST RESULTS ON 07-27-2016 AT WATERMAIN HYDRANT AT S.W. CORNER OF CASS AND VACATED MERRICK INDICATED 50 PSI STATIC, 41 PSI RESIDUAL WITH 1190 GPM FLOW.
 17. OPENINGS IN WALLS AND SLABS SHALL BE CORE DRILLED AS REQUIRED FOR NEW PIPING. LOCATION OF REINFORCING STEEL SHALL BE COORDINATED TO AVOID DAMAGE. PENETRATING RADAR SHALL BE USED TO LOCATE REINFORCING STEEL WITHIN CONCRETE.
 18. ADEQUATE ACCESS TO VALVES AND SPRINKLER HEADS SHALL BE PROVIDED. REQUIREMENTS SHALL BE COORDINATED.
 19. ALL WORK NECESSARY TO ENSURE THAT NO PIPING OR SPRINKLER HEADS WILL FREEZE SHALL BE PROVIDED. DRY PENDENT TYPE HEADS, WARM AIR VENTILATION PATHWAYS OR OTHER APPROVED MEANS SHALL BE USED TO ACHIEVE A FREEZE PROOF INSTALLATION.
 20. WHERE NEW CONNECTIONS TO EXISTING PIPE ARE INDICATED, SYSTEM SERVICE INTERRUPTION IS TO BE MINIMIZED AND COORDINATED WITH OWNER. THIS INCLUDES SHUTDOWNS FOR THE FIRE PROTECTION SYSTEM AND BUILDING DOMESTIC WATER SYSTEM. OWNER REQUIRES A MINIMUM OF SEVEN DAYS NOTICE PRIOR TO SHUTDOWNS.
- REFER TO SPECIFICATION FOR ACCEPTABLE VALVE TYPES PER APPLICATION.

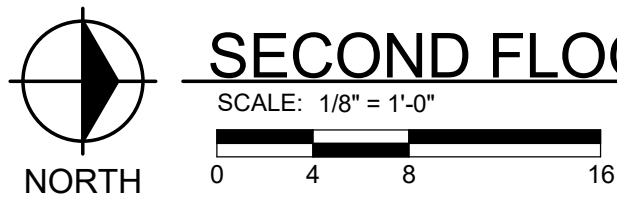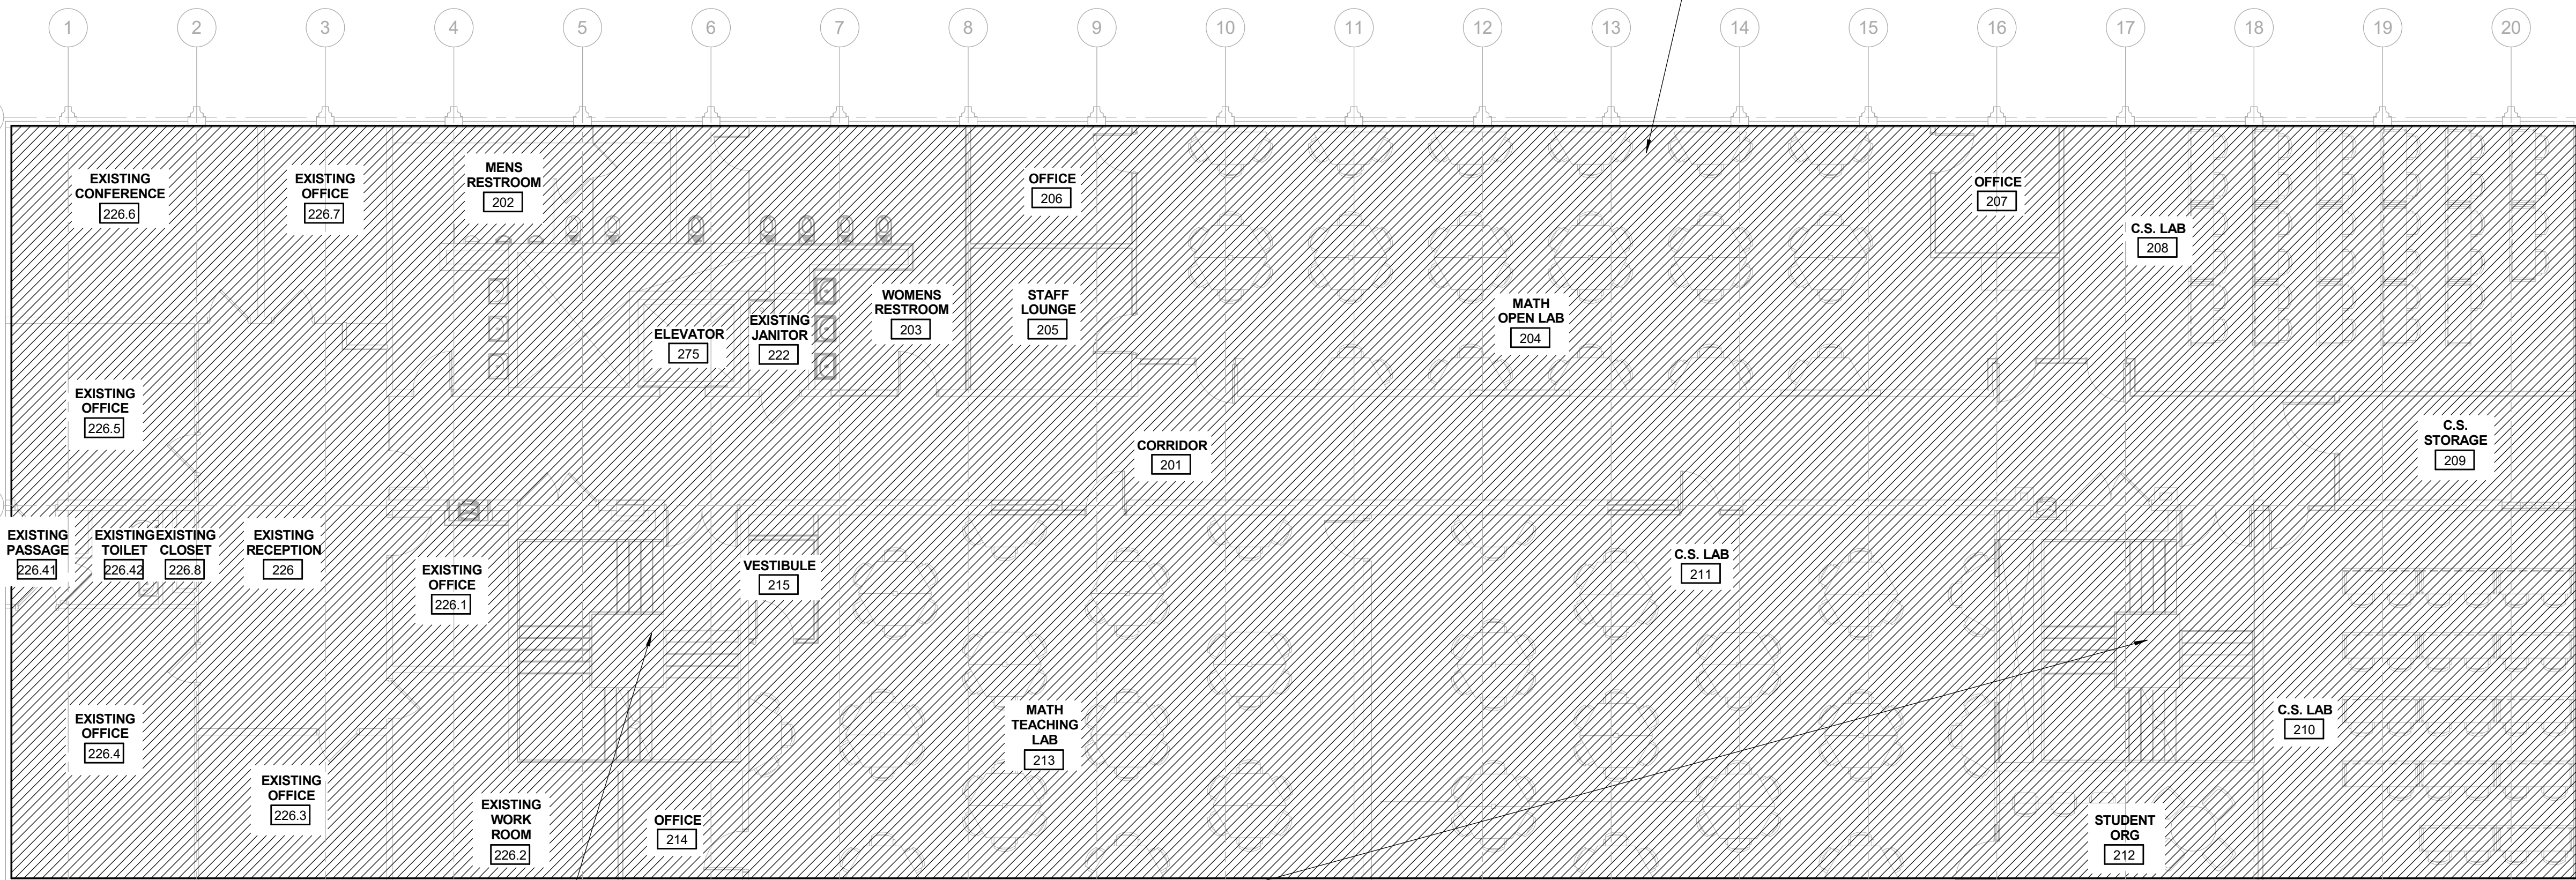

SECOND FLOOR FIRE PROTECTION PLAN

PROVIDE CLASS I STANDPIPE WITH 2-1/2" HOSE CONNECTION IN EACH STAIRWELL AND ON EACH LEVEL ACCORDING TO NFPA, LATEST EDITIONS. PROVIDE CAPPED BLIND FLANGES FOR FUTURE FIRE PROTECTION CONNECTIONS FOR ALL FLOORS ABOVE AND BELOW SECOND FLOOR. CONTRACTOR SHALL DETERMINE STANDPIPE LOCATION ACCORDING TO NFPA, LATEST EDITIONS

REVISIONS		
8/23/2018	A3	ADDENDUM NO. 3



8/13/2018	BIDS
Drawn By	JKB
Designer	JKB
Reviewer	PMS
Manager	MMS

Hard copy is intended to be 24"x36" when plotted. Scale(s) indicated and graphic quality may not be accurate for any other size.

PROJECT NO.
180746

FIRE PROTECTION PLANS
AND DETAILS

PLOT INFO: 8/27/2018 8:43:03 AM C:\Work\Revit\2017_M_180746_wpslowik.rvt

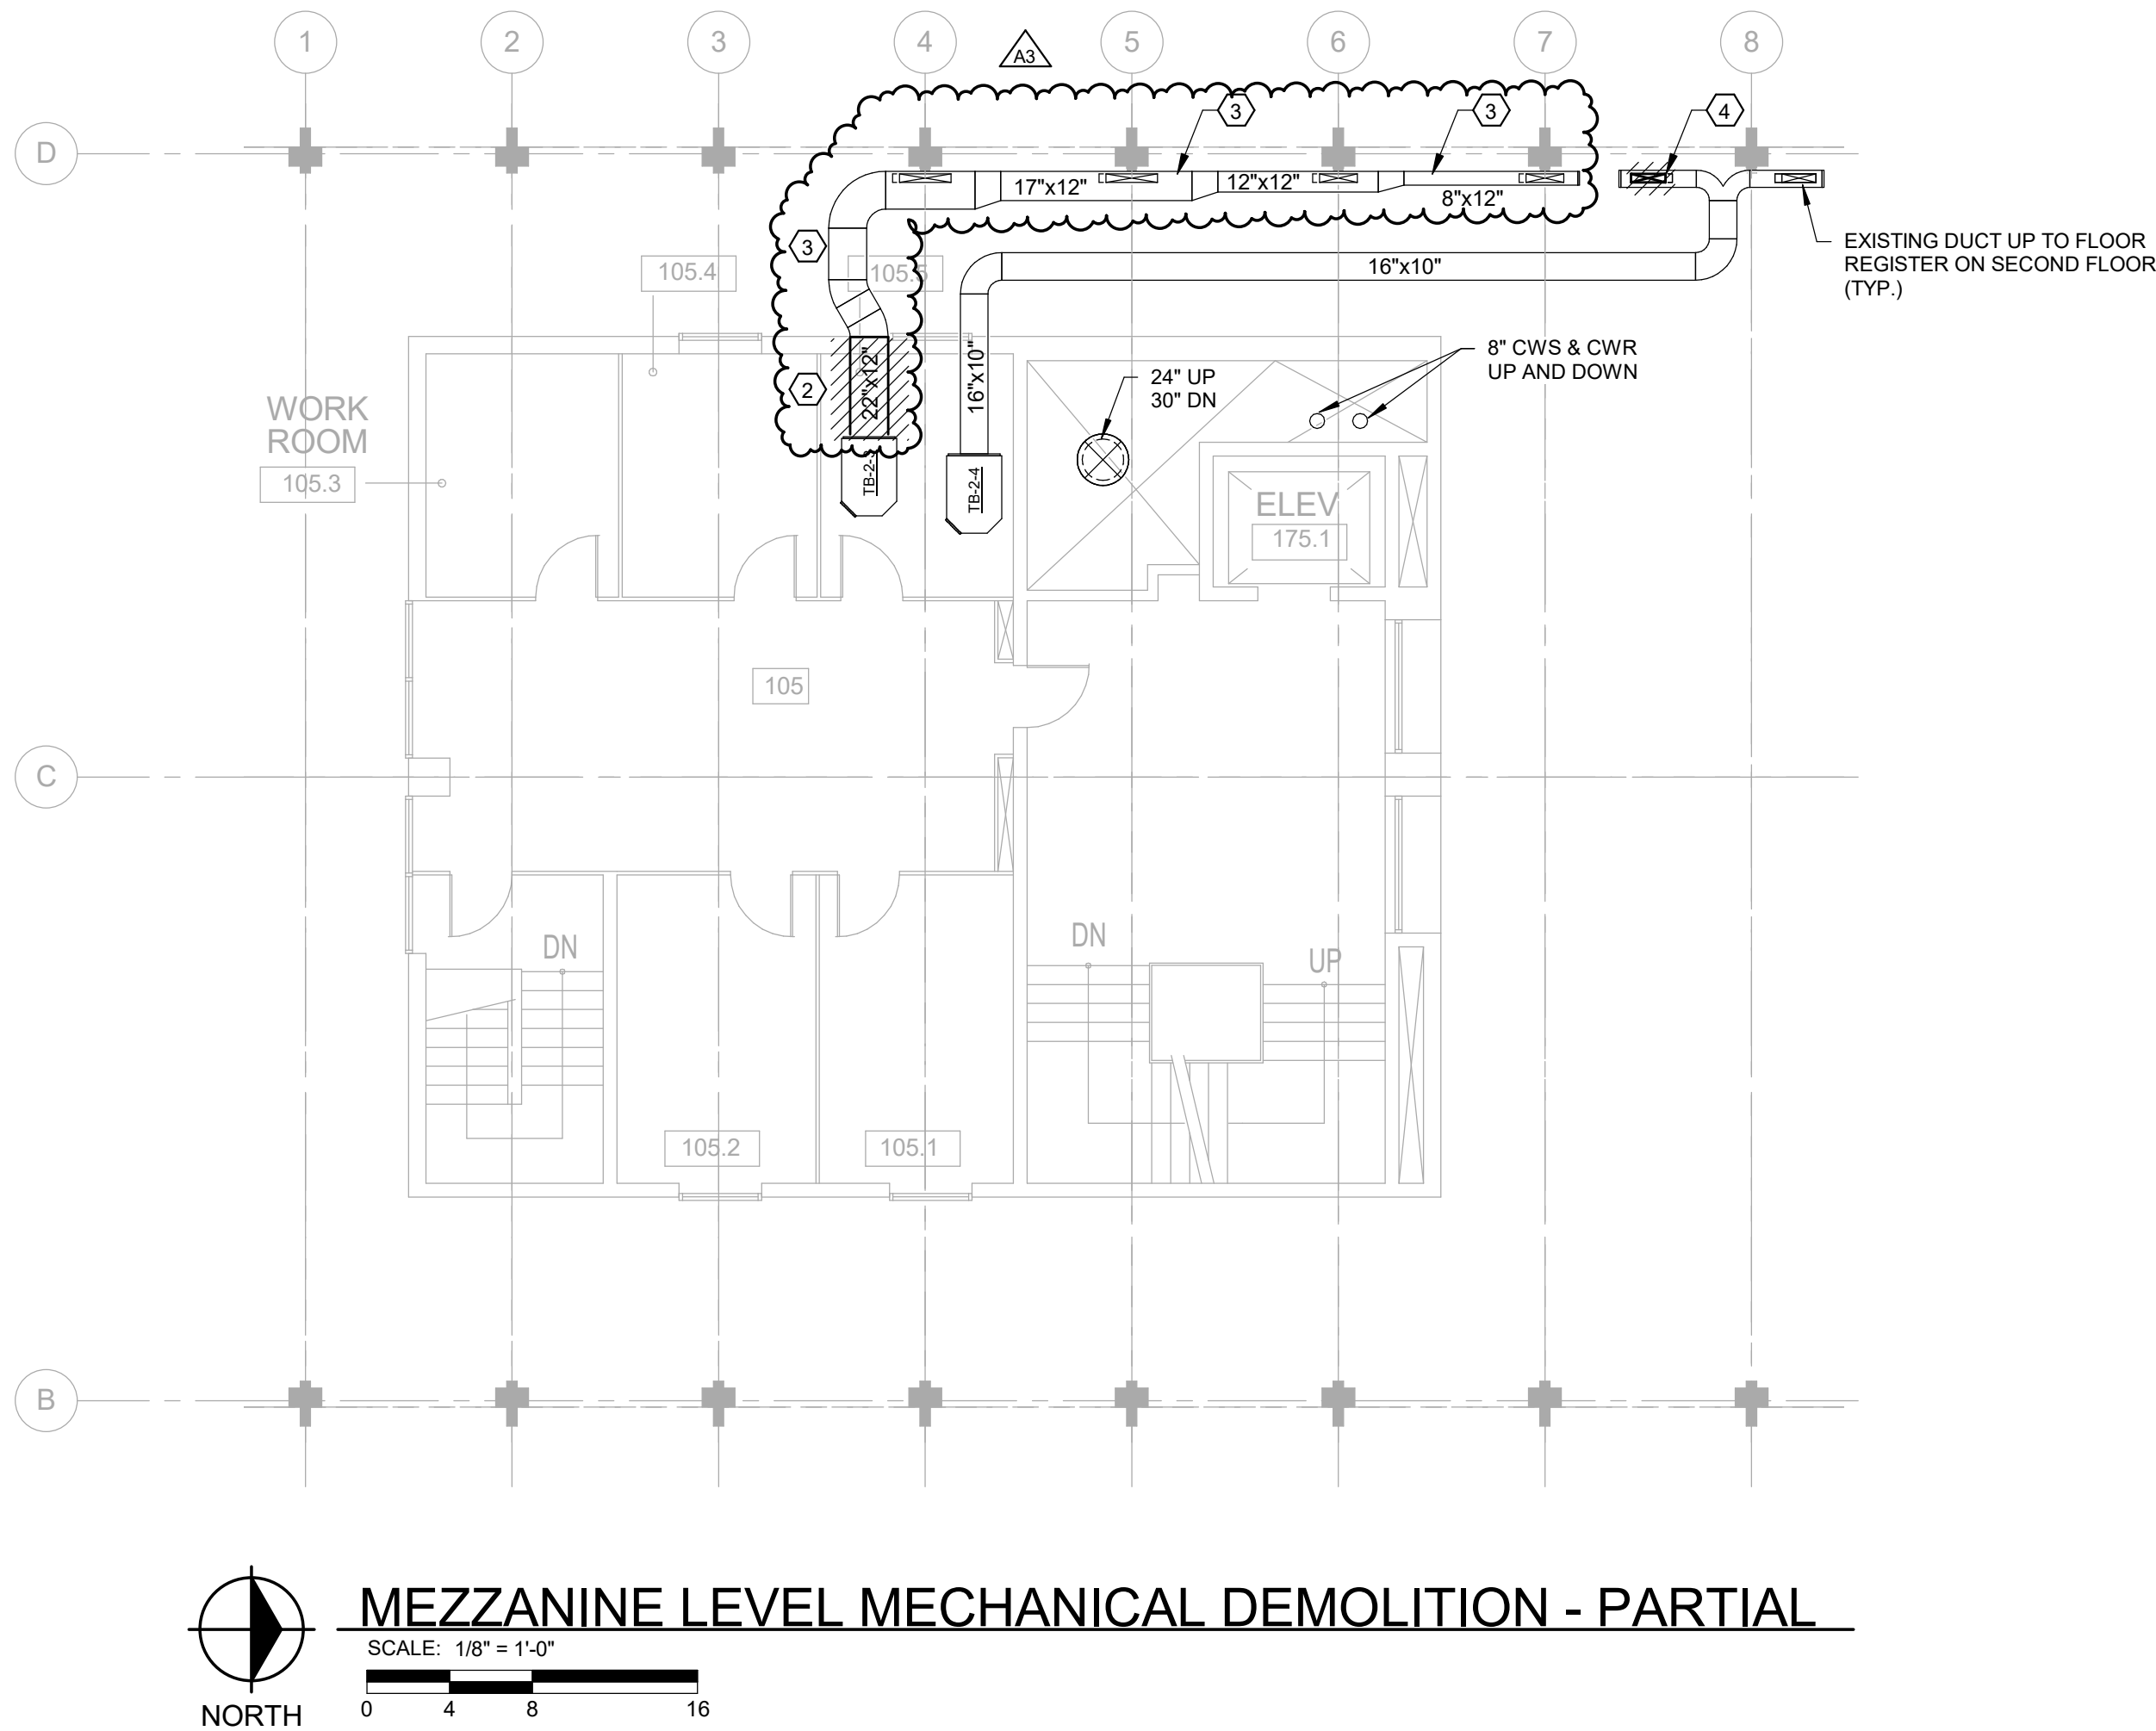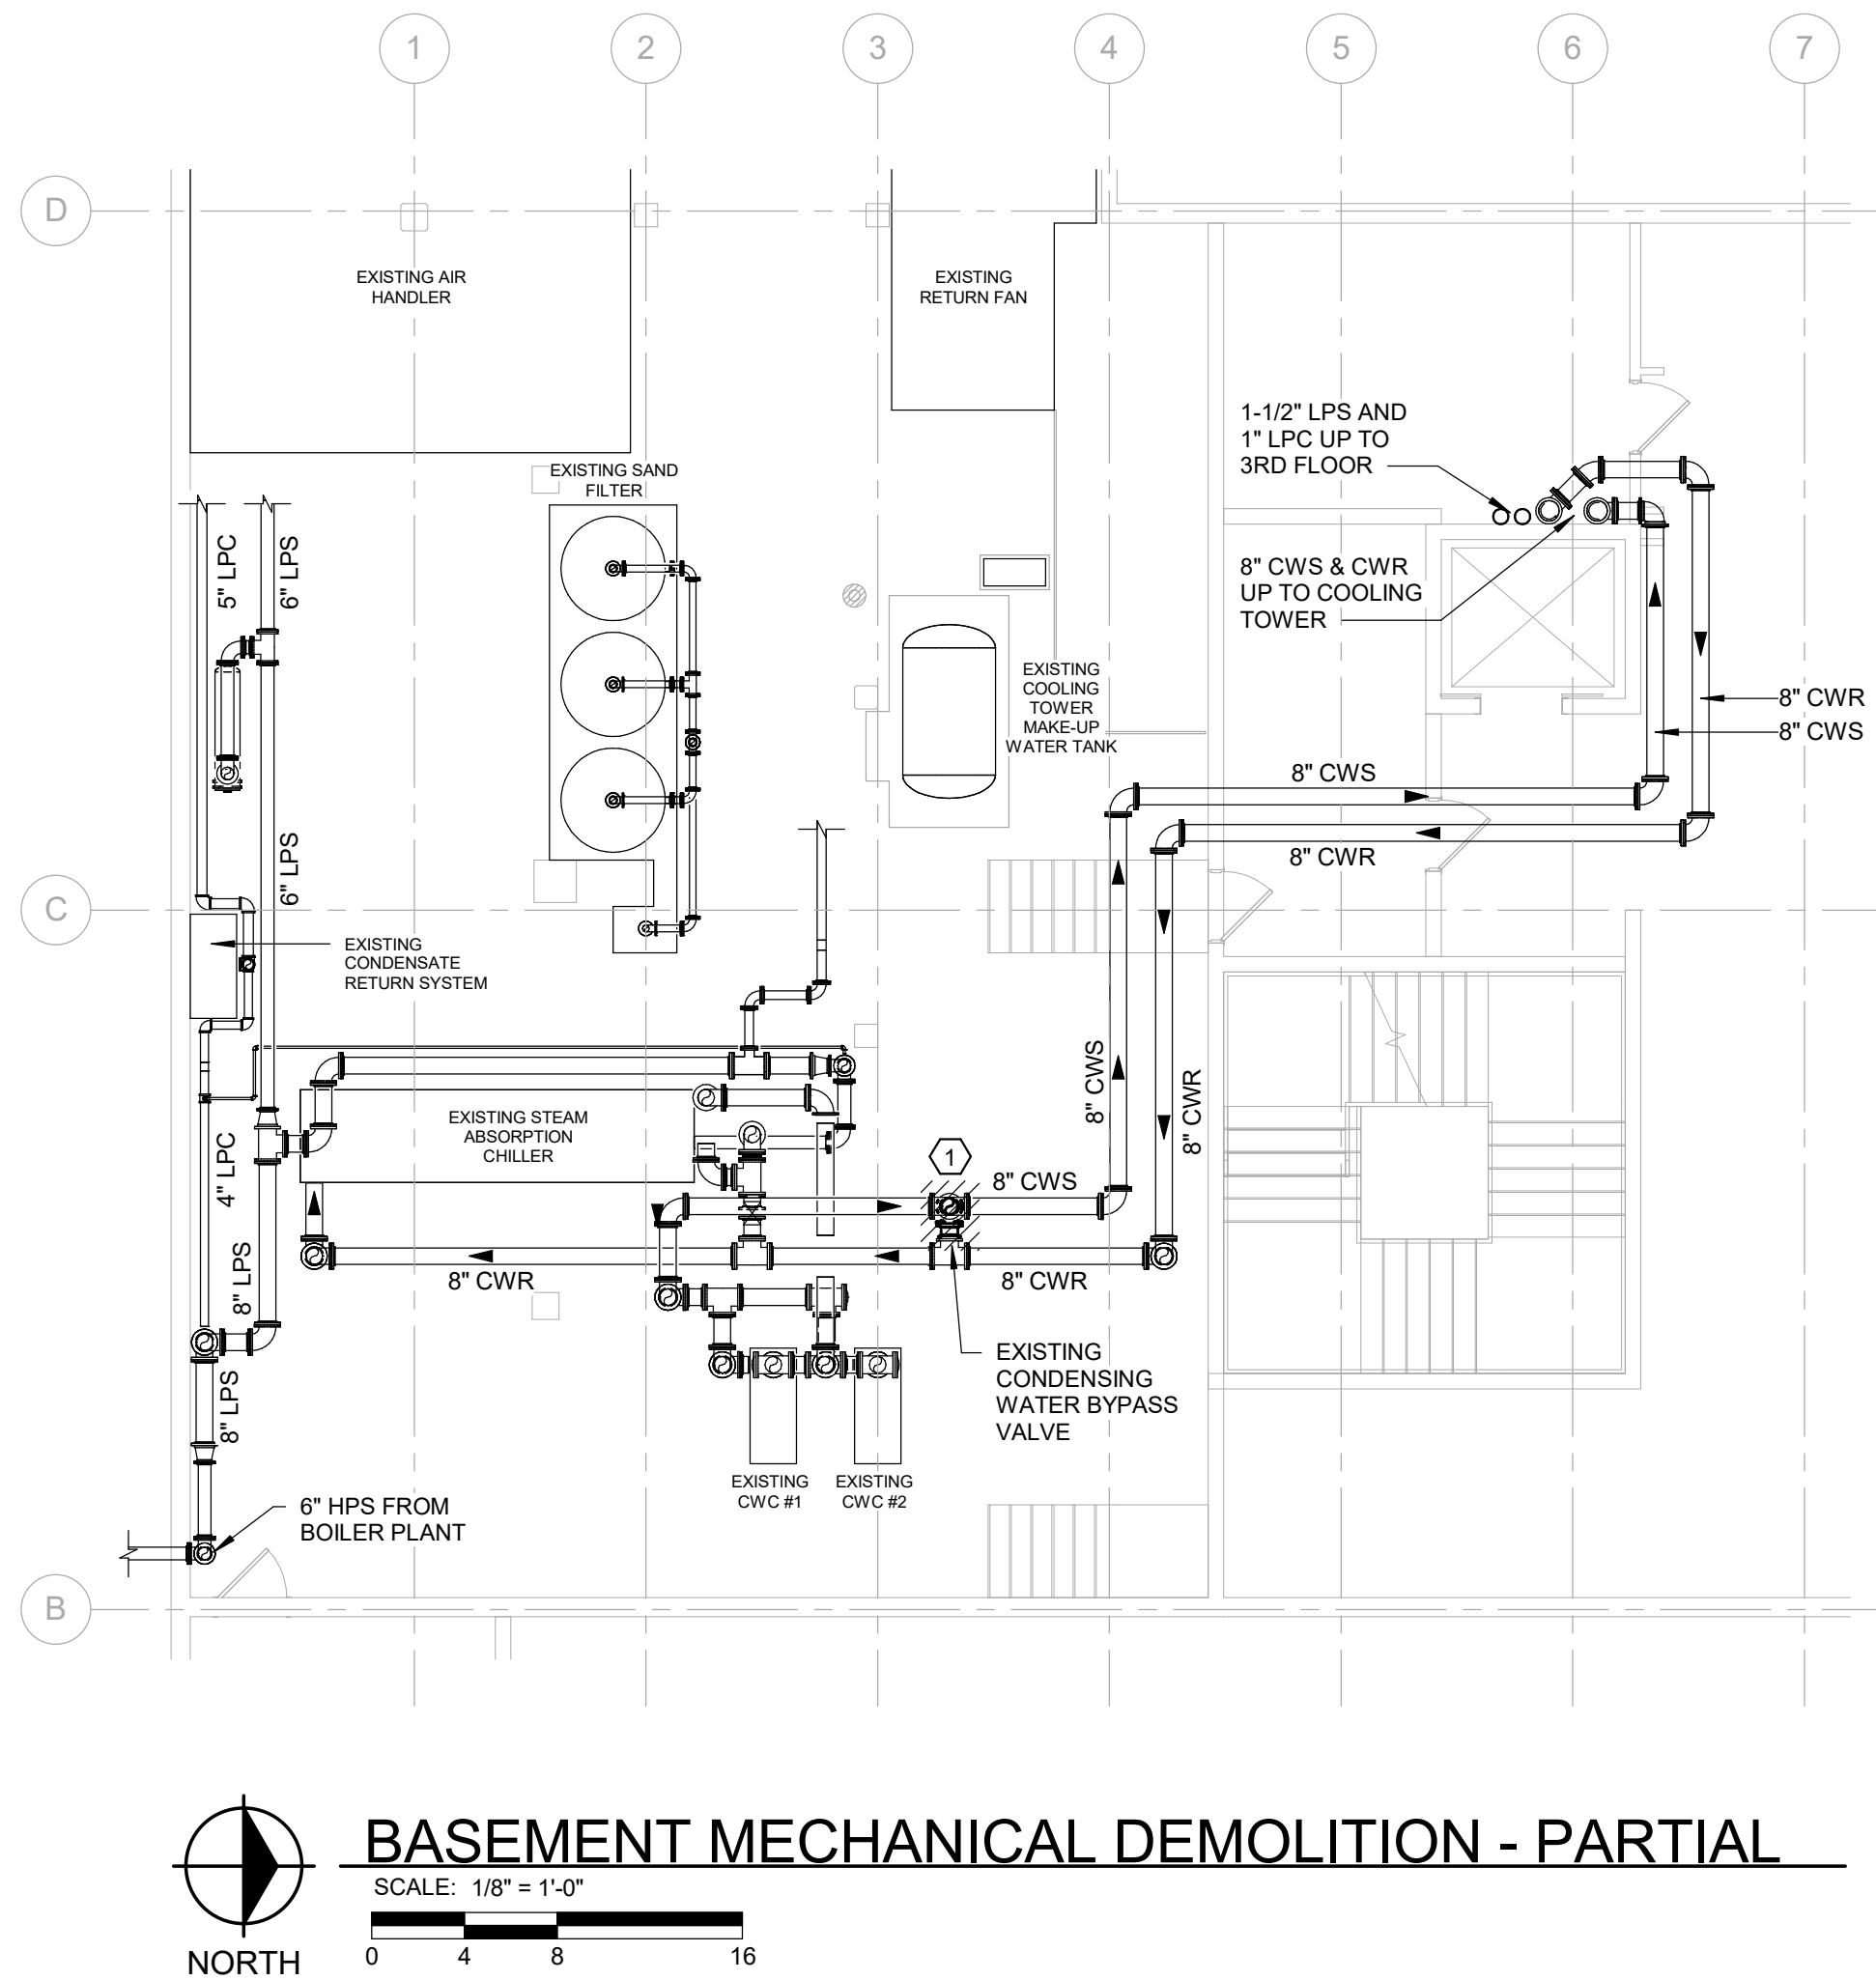

NOTES

1. ALL EXISTING CONDITIONS NOT SHOWN, CONTRACTOR SHALL FIELD VERIFY EXISTING CONDITIONS.
2. EXISTING CONDITIONS SHOWN ARE BASED ON MINORU YAMASAKI AND ASSOCIATES DRAWINGS (PROJECT 6015), DATED 5-7-1962.
3. DUCTWORK AND EQUIPMENT SHOWN LIGHTLY IS EXISTING AND SHALL REMAIN.

DEMOLITION NOTES

1. REMOVE EXISTING CONDENSING WATER BYPASS VALVE AND CAP OPENINGS AT TEES.
2. REMOVE EXISTING DUCTWORK FROM EXISTING TERMINAL BOX AS SHOWN. TERMINAL BOX SHALL REMAIN TO BE REUSED. PATCH AND SEAL WALL PENETRATION.
3. REMOVE EXISTING DUCTWORK UP THROUGH FLOOR TO 2ND FLOOR LEVEL.
4. REMOVE FLOOR GRILLE LOCATED ON 2ND FLOOR AND CAP DUCTWORK. FILL AND PATCH FLOOR, REFER TO ARCHITECTURAL DRAWINGS FOR ADDITIONAL INFORMATION.



WAYNE STATE
UNIVERSITY

ftc&h

engineers
scientists
architects
constructors

fishbeck, thompson, carr & huber, inc.
www.ftch.com

Wayne State University

5201 Cass Ave, Detroit, MI 48202

Prentis Building Computer Lab Relocation

WSU Project: 022-313456

REVISIONS

8/23/2018	A3	ADDENDUM NO. 3
-----------	----	----------------

8/13/2018 BIDS

Drawn By sku

Designer sku

Reviewer PMO

Manager MMS

Hard copy is intended to be 24"x36" when plotted. Scale(s) indicated and graphic quality may not be accurate for any other size.

PROJECT NO.


180746

BASEMENT AND MEZZANINE
FLOOR MECHANICAL
DEMOLITION PLANS

MD101

©Copyright 2018
All Rights Reserved

C:\Work\Revit\2017_M_180746_wpslowik.rvt
PLOT INFO: 8/27/2018 8:42:27 AM

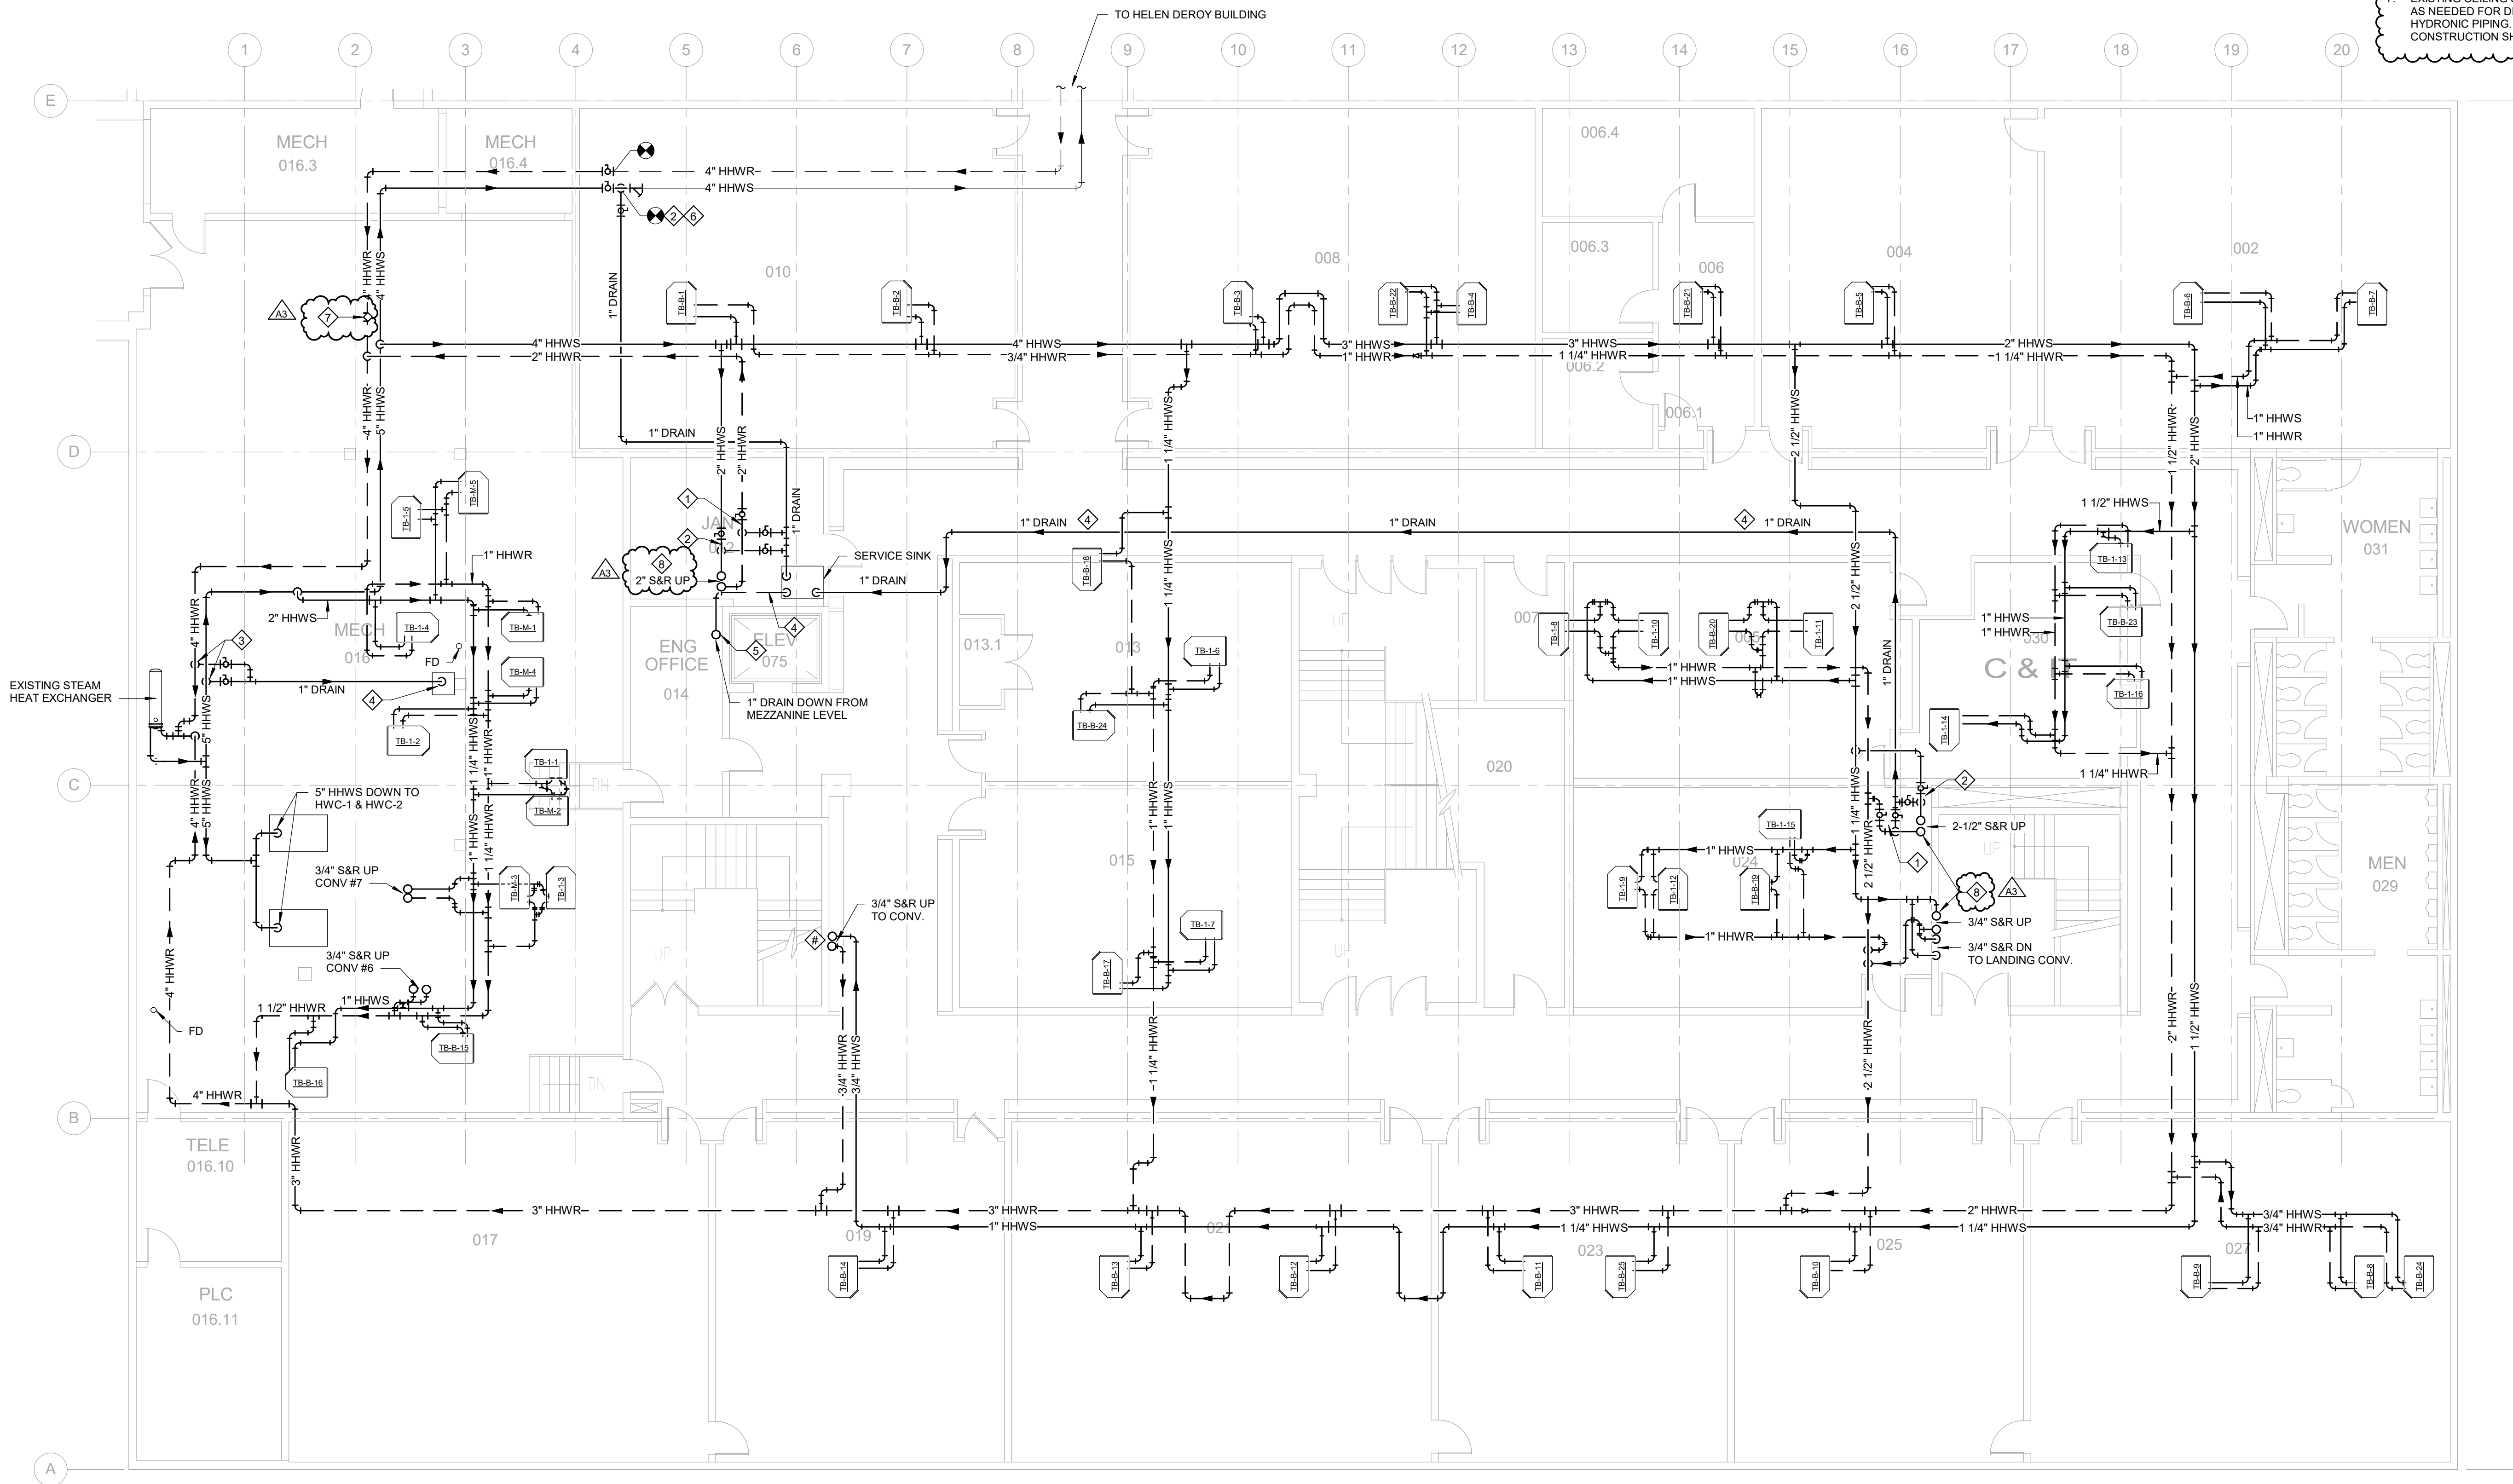

KEY NOTES

1. INSTALL ISOLATION VALVE ON HEATING HOT WATER RETURN (HHWR) PIPING. CONNECT 1" DRAIN INTO HHWR PIPING DOWNSTREAM OF ISOLATION VALVE. INSTALL ISOLATION VALVE ON DRAIN.
2. INSTALL ISOLATION VALVE ON HEATING HOT WATER SUPPLY (HHWS) PIPING. CONNECT 1" DRAIN INTO HHWS PIPING DOWNSTREAM OF ISOLATION VALVE. INSTALL ISOLATION VALVE ON DRAIN.
3. CONNECT 1" DRAIN INTO HHWR AND 1" DRAIN INTO HHWS PIPING. INSTALL ISOLATION VALVE ON EACH DRAIN. ROUTE OVERHEAD TO EXISTING SERVICE SINK.
4. ROUTE 1" DRAIN TO EXISTING SERVICE SINK AND TERMINATE 1" ABOVE RIM.
5. 1" DRAIN DOWN THROUGH PLUMBING CHASE FROM MEZZANINE LEVEL.
6. INSTALL WYE STRAINER ON HEATING HOT WATER SUPPLY (HHWS) PIPING.

7. INSTALL HYDRONIC BALANCING VALVE.
8. HYDRONIC RISER PIPING SHALL BE REPLACED FROM BASEMENT LEVEL TO 6" ABOVE 1ST FLOOR SLAB. PATCH AND REPAIR WALLS AS NECESSARY TO ACCESS PIPING ON OTHER FLOORS, FINISH TO MATCH ADJACENT.

NOTES

1. ALL EXISTING CONDITIONS NOT SHOWN. CONTRACTOR SHALL FIELD VERIFY EXISTING CONDITIONS.
2. NEW PIPING SHOWN IS REPLACING EXISTING PIPING THAT IS TO BE DEMOLISHED AS PART OF PROJECT.
3. PIPING TO TERMINAL BOXES AND CONVECTORS SHALL BE REPLACED UP TO THE EXISTING ISOLATION VALVES.
4. EXISTING CONDITIONS SHOWN ARE BASED ON MINORU YAMASAKI AND ASSOCIATES DRAWINGS (PROJECT 0015), DATED 5-7-1962.
5. EXISTING TERMINAL BOX LOCATIONS, PIPE SIZES AND LOCATIONS, AND VALVE LOCATIONS ARE TAKEN DIRECTLY FROM EXISTING DRAWINGS.
6. REMOVAL OF NORTH MECHANICAL CHASE IS NEEDED FOR PROPER INSTALLATION OF NEW MECHANICAL PIPING. WALL OF CHASE SHOULD BE PROPERLY REPAIRED, PATCHED, AND PAINTED TO MATCH EXISTING WALL AFTER DEMOLITION. REFER TO ARCHITECTURAL DRAWINGS FOR MORE INFORMATION.
7. EXISTING CEILING SHALL BE REMOVED AND REINSTALLED AS NEEDED FOR DEMOLITION AND INSTALLATION OF HYDRONIC PIPING. CEILING TILES DAMAGED DURING CONSTRUCTION SHALL BE REPLACED TO MATCH EXISTING.



BASEMENT HYDRONIC HEATING PIPING REPLACEMENT PLAN - ALTERNATE 1

SCALE: 1/8" = 1'-0"



WAYNE STATE
UNIVERSITY

ftc&h

engineers
scientists
architects
constructors

fishbeck, thompson, carr & huber, inc.
www.ftch.com

Wayne State University

5201 Cass Ave, Detroit, MI 48202

Prentis Building Computer Lab Relocation

WSU Project: 022-313456

REVISIONS

8/23/2018	A3	ADDENDUM NO. 3
-----------	----	----------------

8/13/2018 BIDS

Drawn By sku

Designer sku

Reviewer PMO

Manager MMS

Hard copy is intended to be 24"x36" when plotted. Scale(s) indicated and graphic quality may not be accurate for any other size.


PROJECT NO.

180746

BASEMENT HYDRONIC
HEATING PIPING
REPLACEMENT PLAN


M101

©Copyright 2018
All Rights Reserved

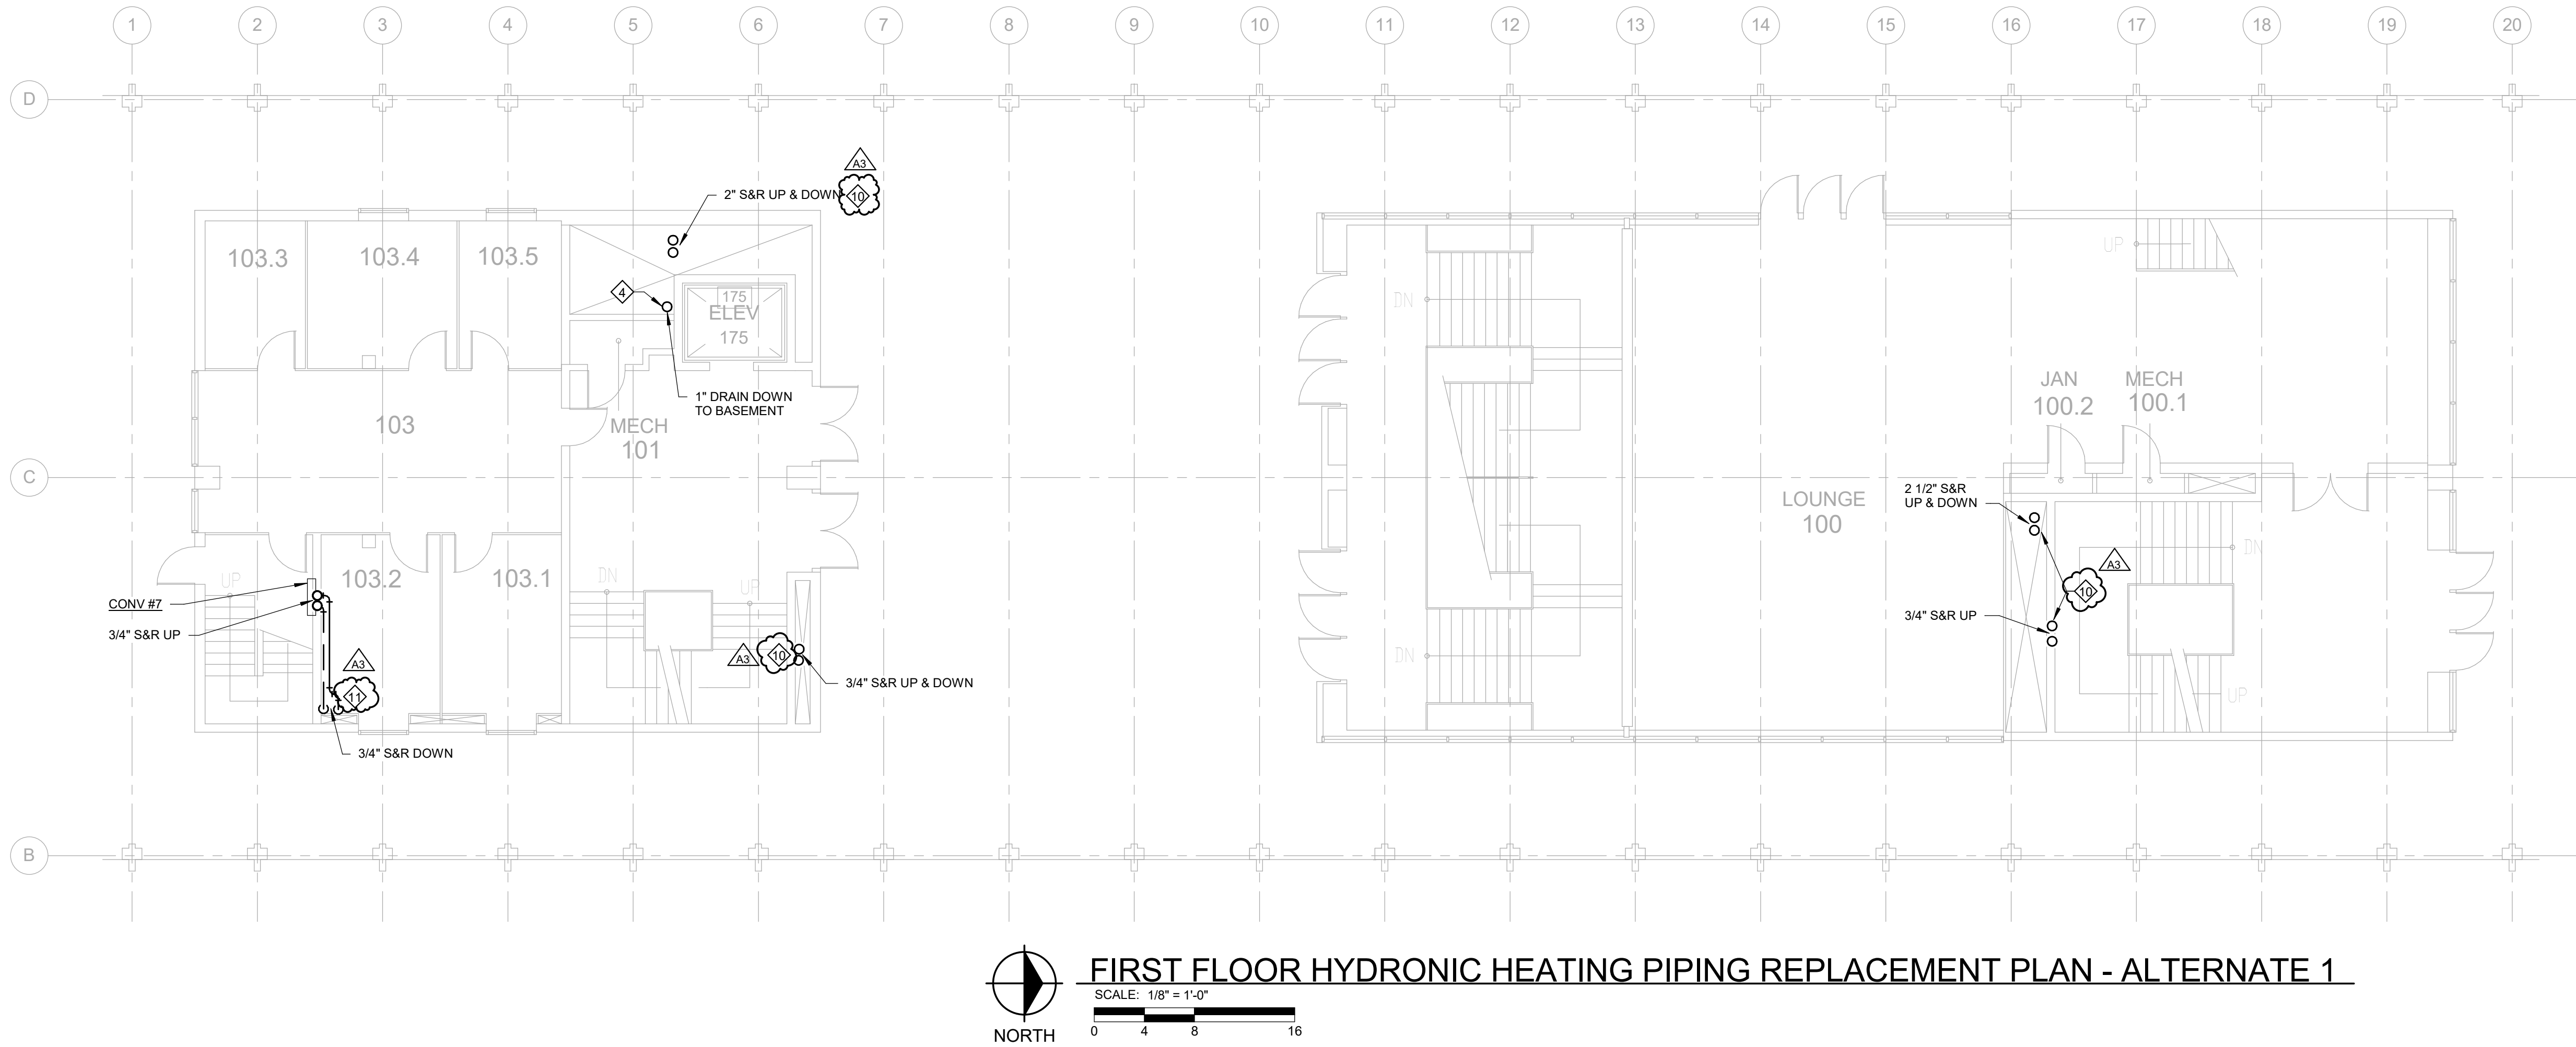

- NOTES**
- ALL EXISTING CONDITIONS NOT SHOWN. CONTRACTOR SHALL FIELD VERIFY EXISTING CONDITIONS.
 - NEW PIPING SHOWN IS REPLACING EXISTING PIPING THAT IS TO BE DEMOLISHED AS PART OF PROJECT.
 - PIPING TO TERMINAL BOXES AND CONVECTORS SHALL BE REPLACED UP TO THE EXISTING ISOLATION VALVES.
 - EXISTING CONDITIONS SHOWN ARE BASED ON MINORU YAMASAKI AND ASSOCIATES DRAWINGS (PROJECT 6015), DATED 5-7-1962.
 - EXISTING TERMINAL BOX LOCATIONS, PIPE SIZES AND LOCATIONS, AND VALVE LOCATIONS ARE TAKEN DIRECTLY FROM EXISTING DRAWINGS.
 - REMOVAL OF NORTH MECHANICAL CHASE IS NEEDED FOR PROPER INSTALLATION OF NEW MECHANICAL PIPING. WALL OF CHASE SHOULD BE PROPERLY REPAIRED, PATCHED, AND PAINTED TO MATCH EXISTING WALL AFTER DEMOLITION. REFER TO ARCHITECTURAL DRAWINGS FOR MORE INFORMATION.
 - EXISTING CEILING SHALL BE REMOVED AND REINSTALLED AS NEEDED FOR DEMOLITION AND INSTALLATION OF HYDRONIC PIPING. CEILING TILES DAMAGED DURING CONSTRUCTION SHALL BE REPLACED TO MATCH EXISTING.

- KEY NOTES**
- INSTALL WYE STRAINER ON HEATING HOT WATER SUPPLY (HHWS) PIPING.
 - INSTALL ISOLATION VALVE ON HEATING HOT WATER RETURN (HHWR) PIPING. CONNECT 1\"/>

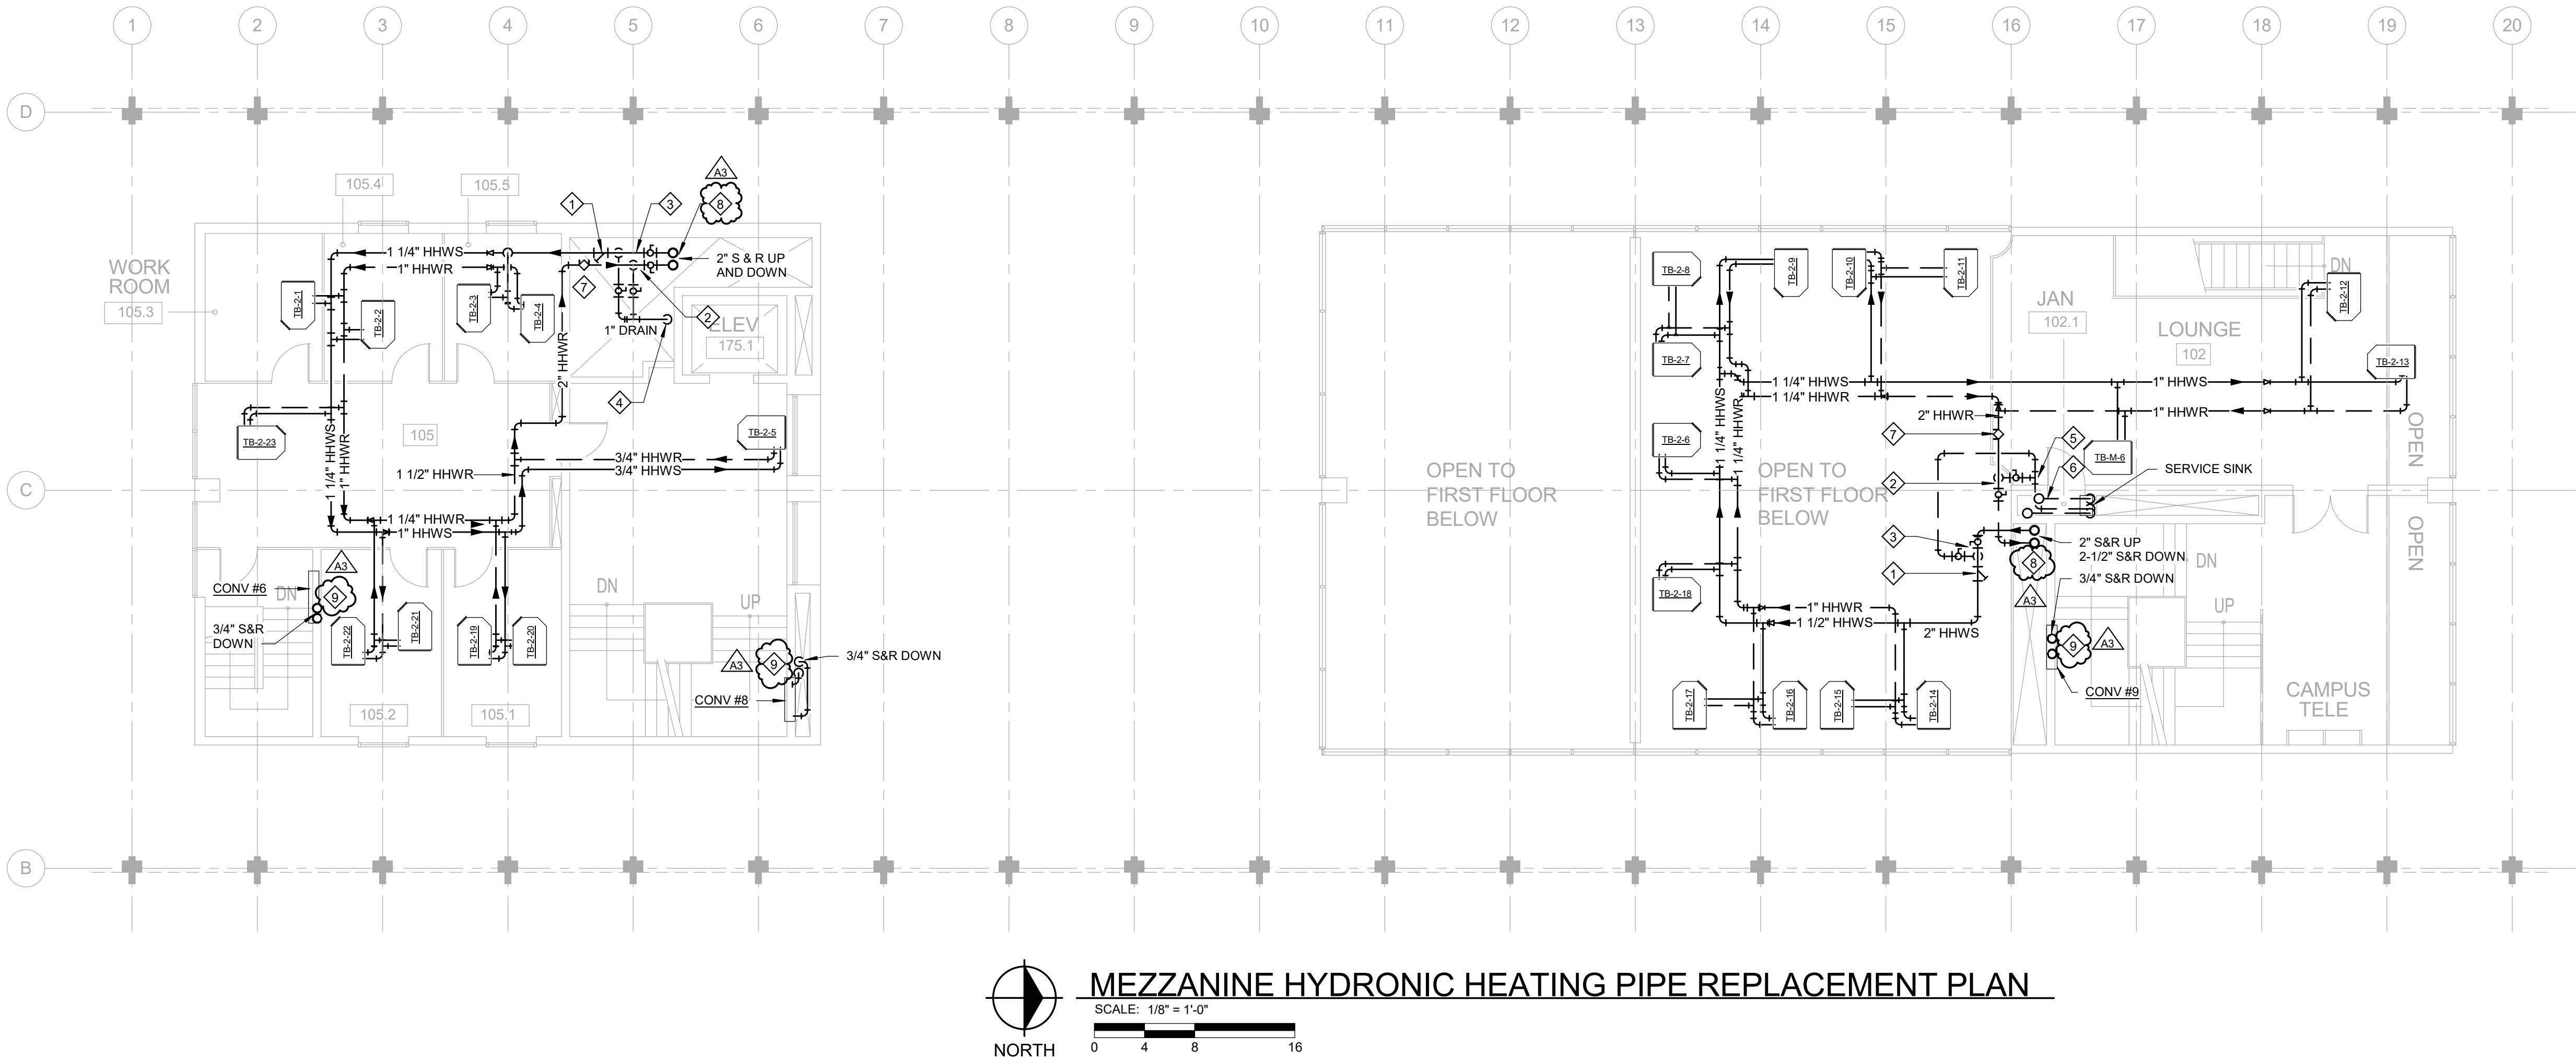

REVISIONS	
8/23/2018	A3 ADDENDUM NO. 3



8/13/2018	BIDS
Drawn By	sku
Designer	sku
Reviewer	PMO
Manager	MM5

Hard copy is intended to be 24"x36" when plotted. Scale(s) indicated and graphic quality may not be accurate for any other size.

PROJECT NO.
180746

FIRST FLOOR AND
MEZZANINE HYDRONIC
HEATING PIPING
REPLACEMENT PLANS

M102
©Copyright 2018
All Rights Reserved

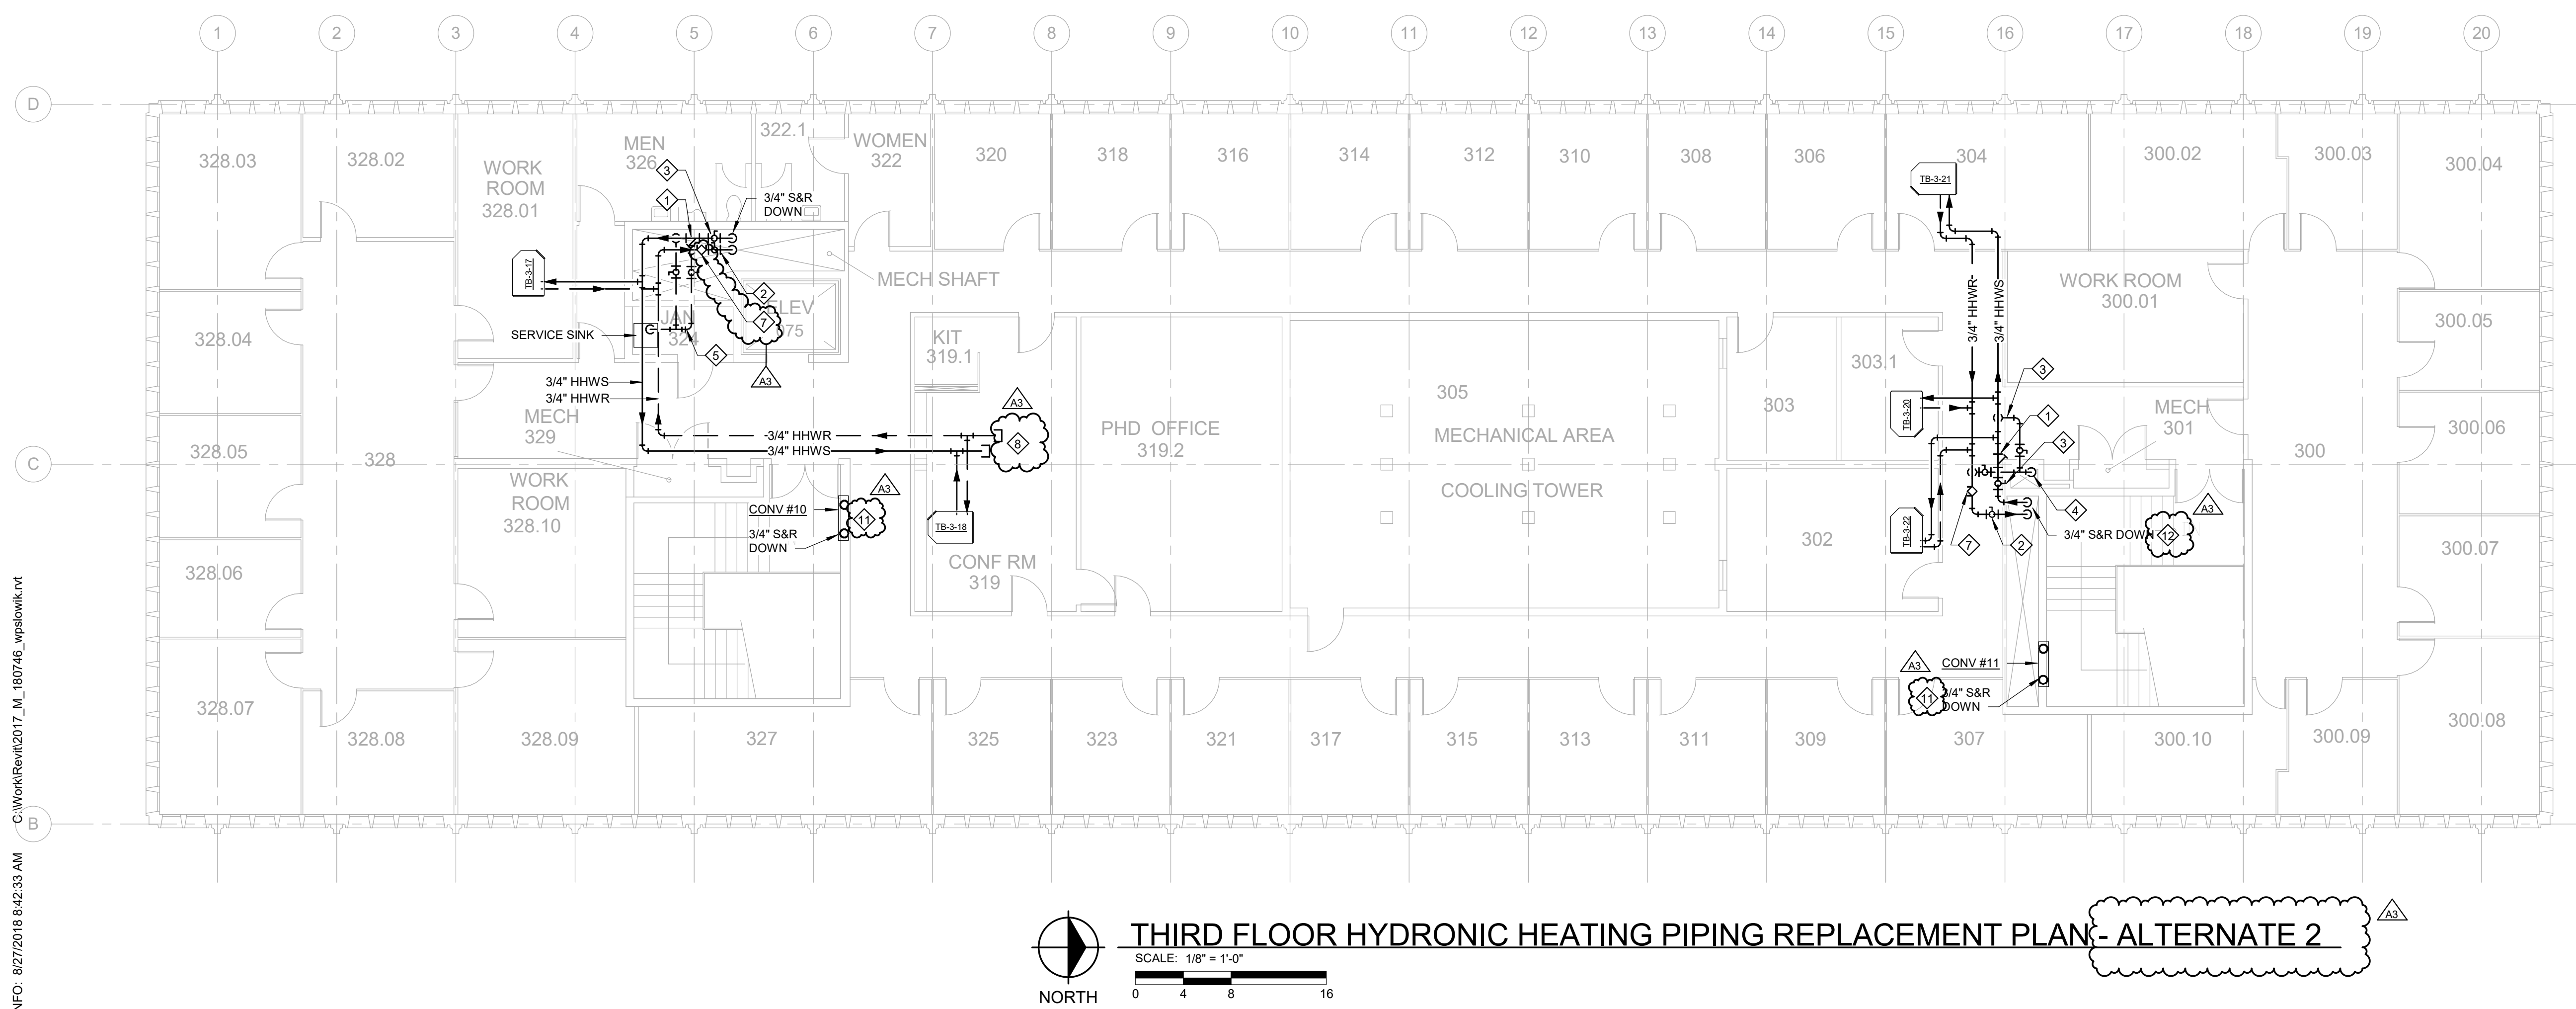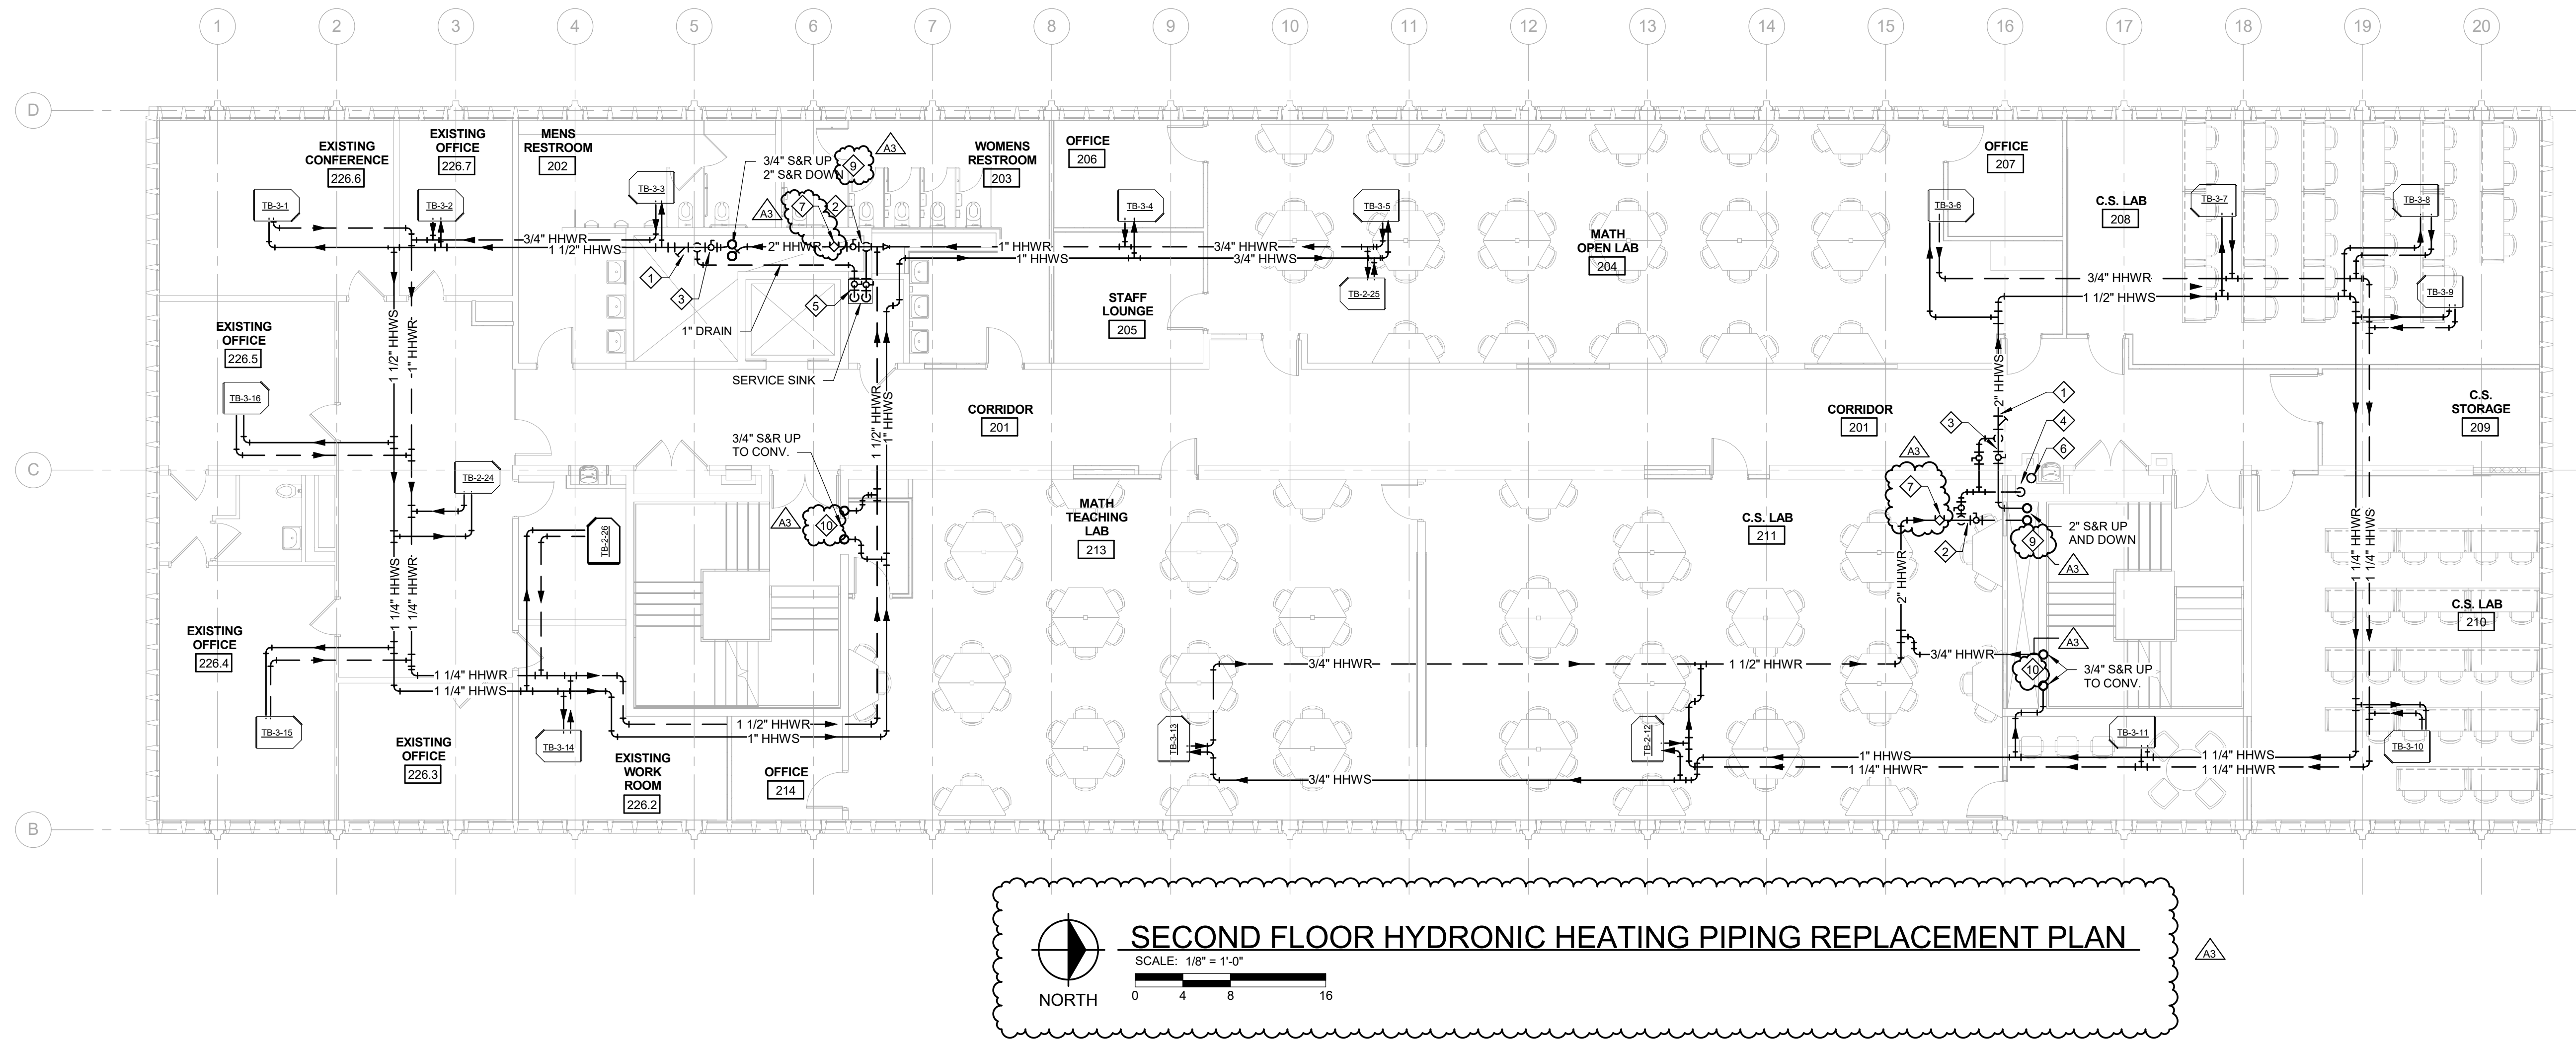

- NOTES**
- ALL EXISTING CONDITIONS NOT SHOWN. CONTRACTOR SHALL FIELD VERIFY EXISTING CONDITIONS.
 - NEW PIPING SHOWN IS REPLACING EXISTING PIPING THAT IS TO BE DEMOLISHED AS PART OF PROJECT.
 - PIPING TO TERMINAL BOXES AND CONVECTORS SHALL BE REPLACED UP TO THE EXISTING ISOLATION VALVES.
 - EXISTING CONDITIONS SHOWN ARE BASED ON MINORU YAMASAKI AND ASSOCIATES DRAWINGS (PROJECT 6015), DATED 5-7-1962.
 - EXISTING TERMINAL BOX LOCATIONS, PIPE SIZES AND LOCATIONS, AND VALVE LOCATIONS ARE TAKEN DIRECTLY FROM EXISTING DRAWINGS.
 - REMOVAL OF NORTH MECHANICAL CHASE IS NEEDED FOR PROPER INSTALLATION OF NEW MECHANICAL PIPING. WALL OF CHASE SHOULD BE PROPERLY REPAIRED, PATCHED, AND PAINTED TO MATCH EXISTING WALL AFTER DEMOLITION. REFER TO ARCHITECTURAL DRAWINGS FOR MORE INFORMATION.
 - EXISTING CEILING SHALL BE REMOVED AND REINSTALLED AS NEEDED FOR DEMOLITION AND INSTALLATION OF HYDRONIC PIPING. CEILING TILES DAMAGED DURING CONSTRUCTION SHALL BE REPLACED TO MATCH EXISTING.

- KEY NOTES**
- INSTALL WYE STRAINER ON HEATING HOT WATER SUPPLY (HHWS) PIPING.
 - INSTALL ISOLATION VALVE ON HEATING HOT WATER RETURN (HHWR) PIPING. CONNECT 1" DRAIN INTO HHWR PIPING UPSTREAM OF ISOLATION VALVE. INSTALL ISOLATION VALVE ON DRAIN.
 - INSTALL ISOLATION VALVE ON HEATING HOT WATER SUPPLY (HHWS) PIPING. CONNECT 1" DRAIN INTO HHWS PIPING UPSTREAM OF ISOLATION VALVE. INSTALL ISOLATION VALVE ON DRAIN.
 - ROUTE 1" DRAIN DOWN THROUGH PLUMBING CHASE TO MEZZANINE LEVEL SERVICE SINK.
 - ROUTE 1" DRAINS TO EXISTING SERVICE SINK AND TERMINATE 1" ABOVE RIM.
 - 1" DRAIN DOWN FROM THIRD FLOOR CONTINUED DOWN TO MEZZANINE LEVEL SERVICE SINK AND TERMINATE 1" ABOVE RIM.
 - INSTALL HYDRONIC BALANCING VALVE.
 - TERMINAL BOX (TB-3-19) SHALL BE REMOVED (REFER TO MD102). REMOVE ASSOCIATED HYDRONIC PIPING AND CAP. TERMINAL BOX (TB-3-18) PIPING SHALL REMAIN IN SERVICE.
 - HYDRONIC RISER PIPING SHALL BE REPLACED FROM 6" BELOW 2ND FLOOR SLAB TO 6" ABOVE 3RD FLOOR SLAB. PATCH AND REPAIR WALLS AS NECESSARY TO ACCESS PIPING ON OTHER FLOORS, FINISH TO MATCH ADJACENT.
 - HYDRONIC RISER PIPING SHALL BE REPLACED FROM 2ND FLOOR TO 6" ABOVE 3RD FLOOR SLAB. PATCH AND REPAIR WALLS AS NECESSARY TO ACCESS PIPING ON OTHER FLOORS, FINISH TO MATCH ADJACENT.
 - HYDRONIC RISER PIPING SHALL BE REPLACED FROM 6" ABOVE 3RD FLOOR SLAB TO CONVECTOR ISOLATION VALVE.
 - HYDRONIC RISER PIPING SHALL BE REPLACED FROM 6" ABOVE 3RD FLOOR SLAB.

WAYNE STATE UNIVERSITY

fishc&h

engineers
scientists
architects
constructors

fishbeck, thompson, carr & huber, inc.
www.fishc.com

Wayne State University

5201 Cass Ave, Detroit, MI 48202

Prentiss Building Computer Lab Relocation

WSU Project: 022-313456

REVISIONS	
8/23/2018	A3 ADDENDUM NO. 3

8/13/2018 BIDS

Drawn By sku

Designer sku

Reviewer PMO

Manager MMS

Hard copy is intended to be 24"x36" when plotted. Scale(s) indicated and graphic quality may not be accurate for any other size.

PROJECT NO.



180746

SECOND AND THIRD FLOOR
HYDRONIC HEATING PIPING
REPLACEMENT PLANS

M103

©Copyright 2018
All Rights Reserved

PLOT INFO: 8/27/2018 8:42:33 AM C:\Work\Revit\2017_M_180746_wpslowik.rvt

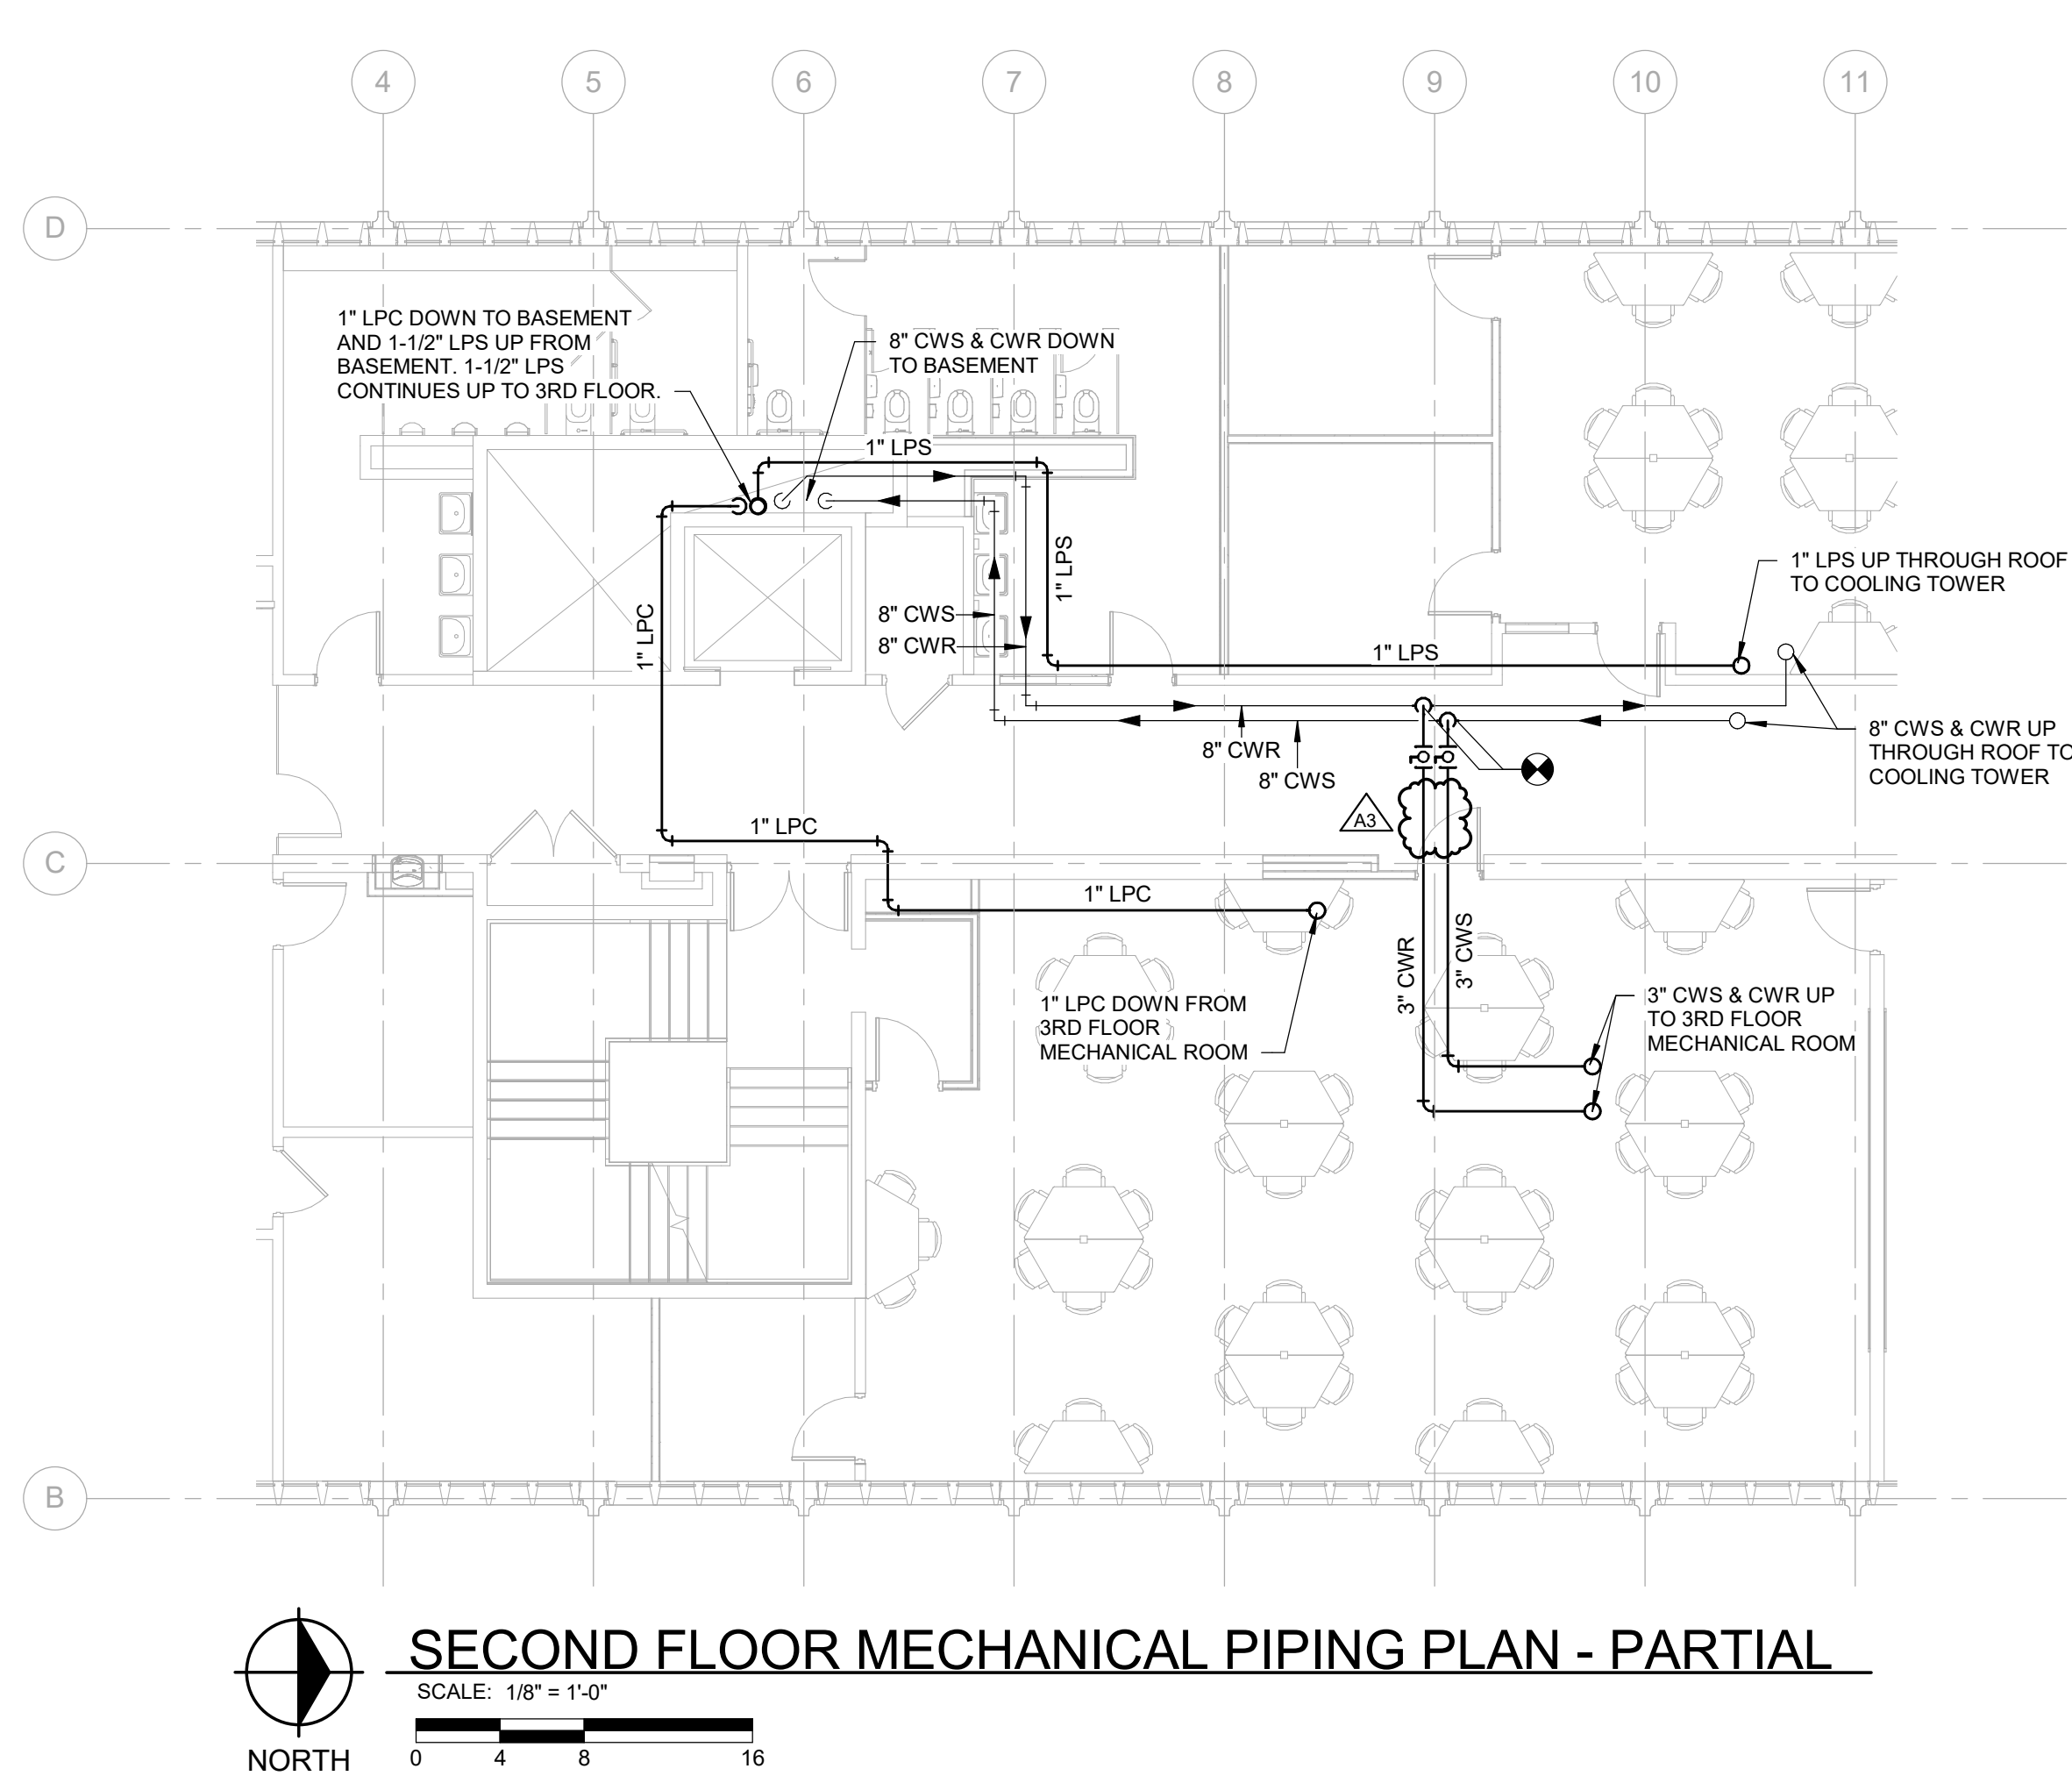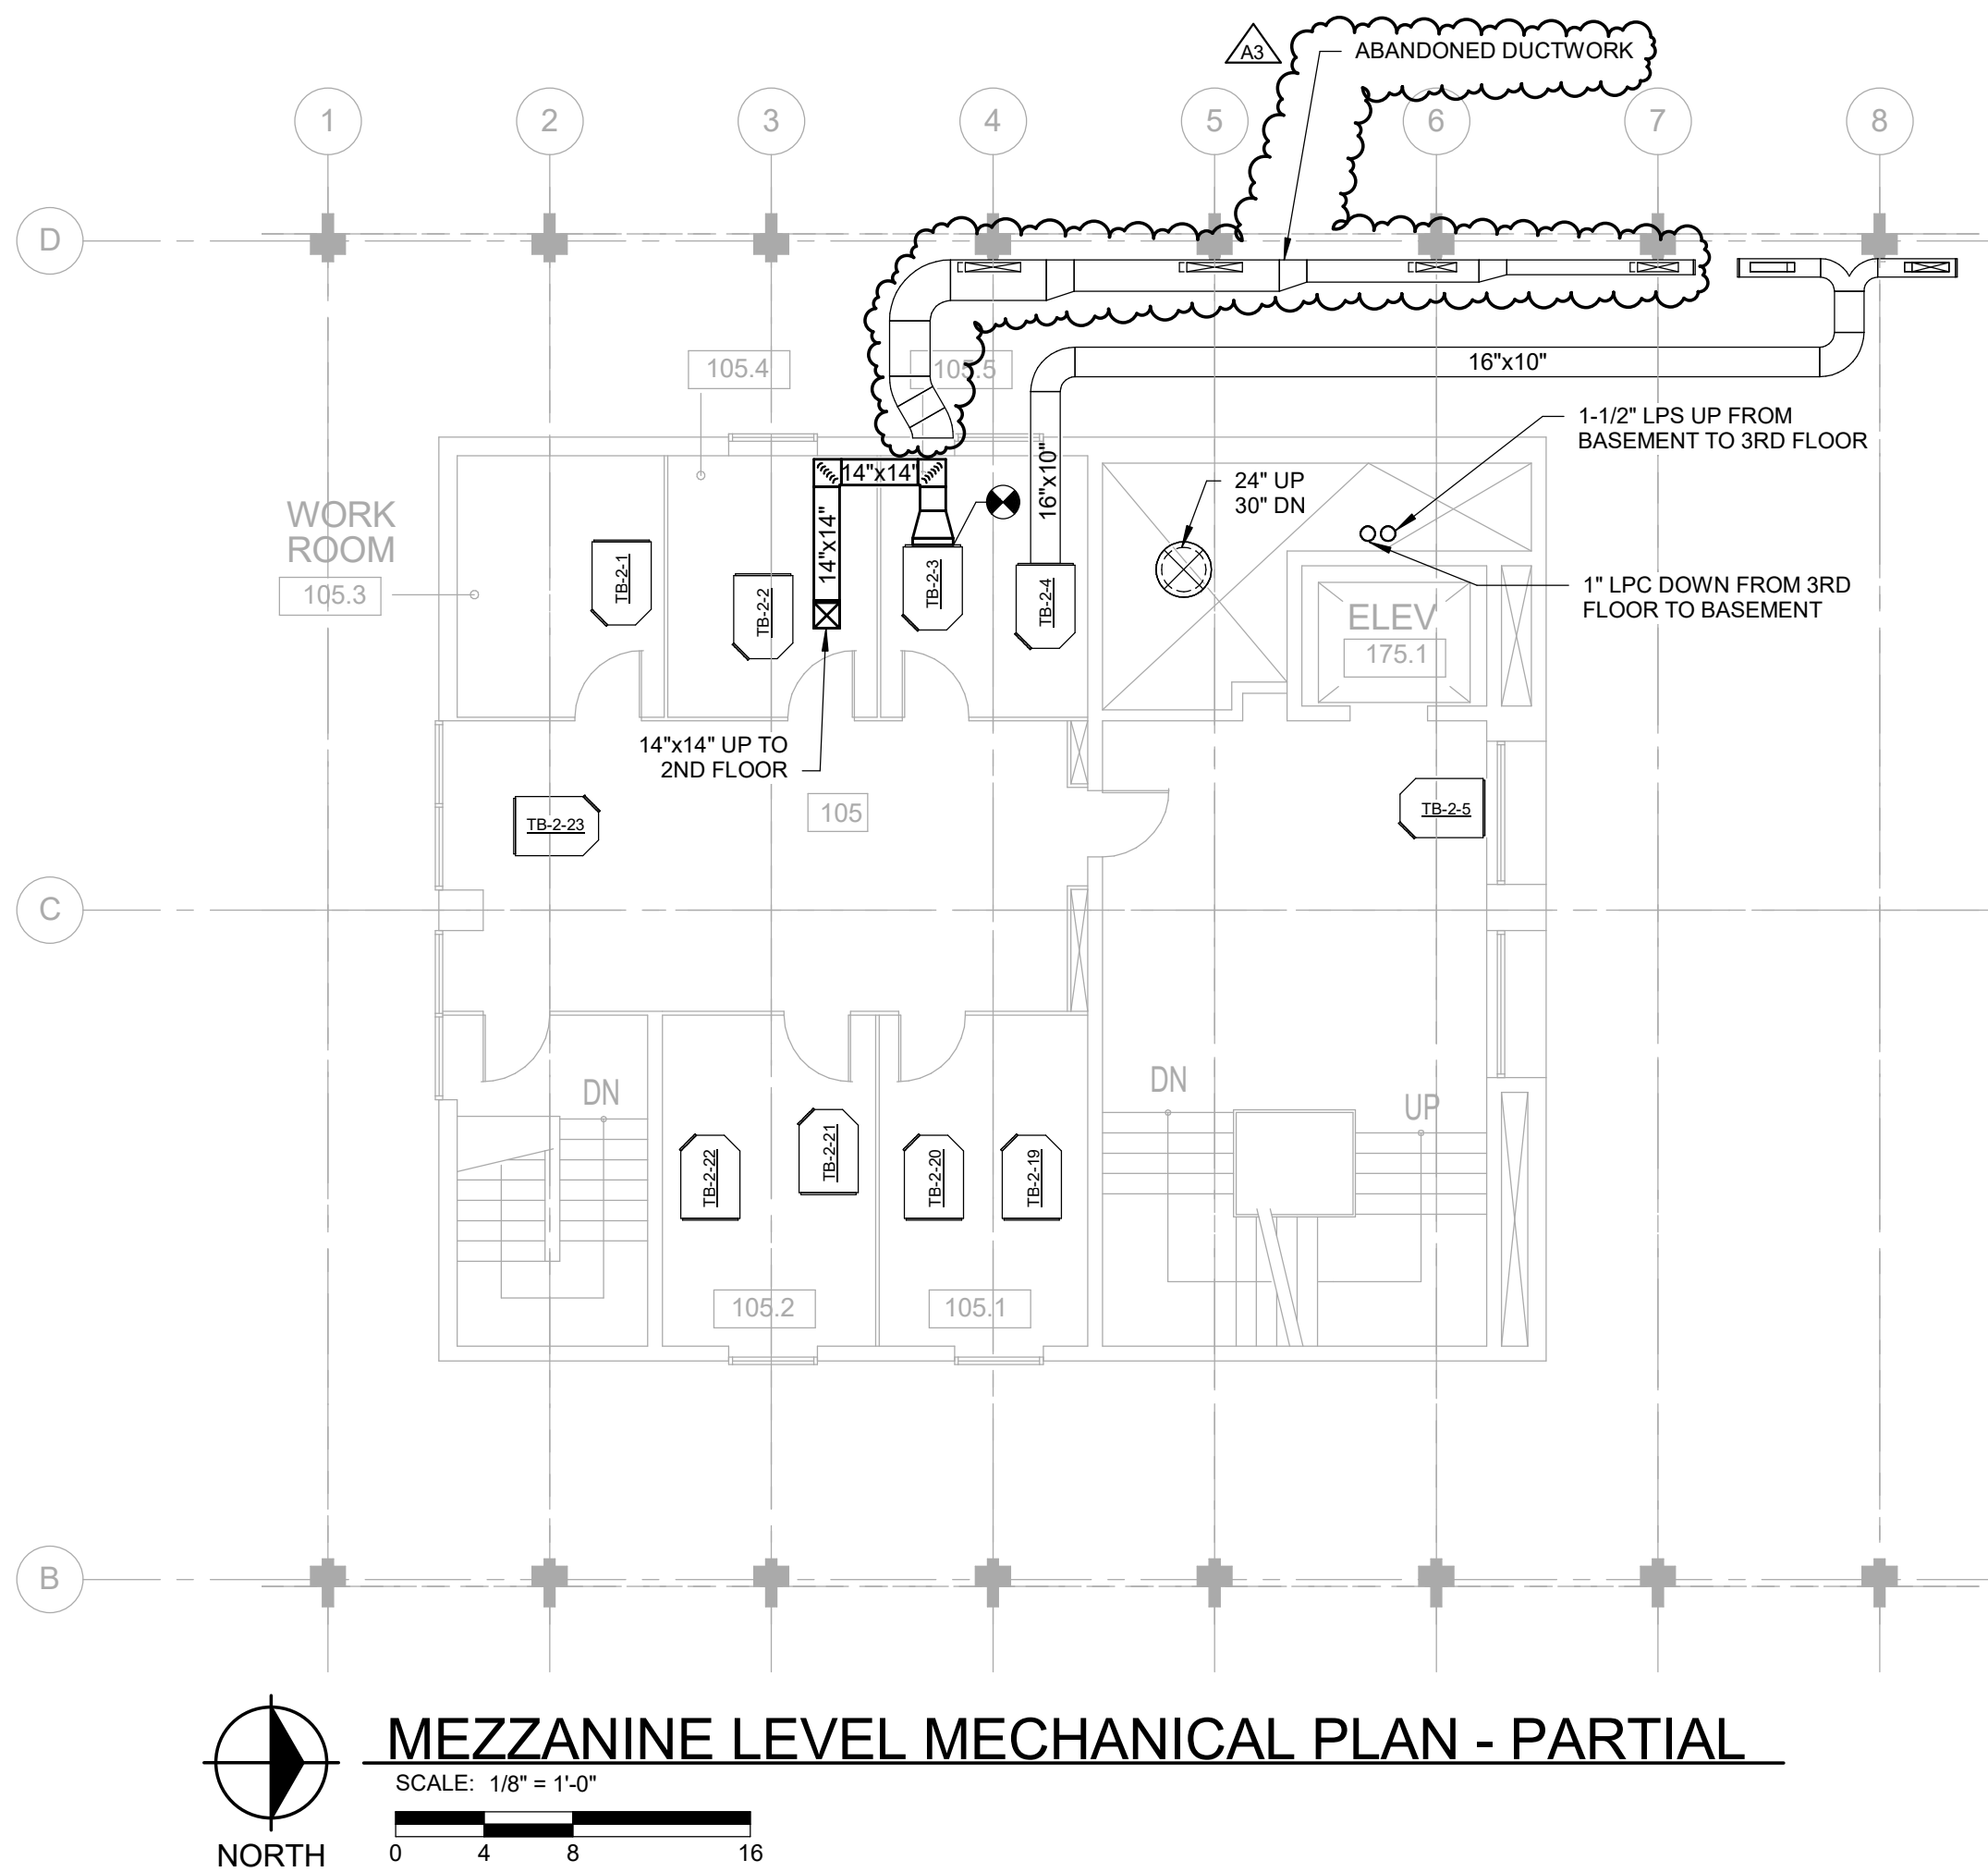


NOTES

- ALL EXISTING CONDITIONS NOT SHOWN. CONTRACTOR SHALL FIELD VERIFY EXISTING CONDITIONS.
- EXISTING CONDITIONS SHOWN ARE BASED ON MINORU YAMASAKI AND ASSOCIATES DRAWINGS (PROJECT 6015), DATED 5-7-1962.

KEY NOTES

- 10" DUCT THROUGH WALL WITH FIRE DAMPER. DUCTWORK SHALL BE RUN TIGHT TO CEILING INSIDE ANNULAR SPACE BETWEEN CONCRETE JOISTS.
- 12" DUCT THROUGH WALL WITH FIRE DAMPER. DUCTWORK SHALL BE RUN TIGHT TO CEILING INSIDE ANNULAR SPACE BETWEEN CONCRETE JOISTS.
- 14"x16" DUCT THROUGH WALL WITH FIRE DAMPER. DUCTWORK SHALL BE RUN TIGHT TO CEILING INSIDE ANNULAR SPACE BETWEEN CONCRETE JOISTS.
- RELOCATE AND REINSTALL EXISTING CEILING DIFFUSER AS NEEDED FOR INSTALLATION OF NEW DUCTWORK. DIFFUSERS SHALL BE THOROUGHLY CLEANED BEFORE REINSTALLATION.
- RELOCATE AND REINSTALL EXISTING TERMINAL BOX AS NEEDED FOR INSTALLATION OF NEW WALL. EXISTING PIPING, DUCTWORK, AND WIRING SHALL BE RELOCATED AND RECONNECTED.
- 14"x14" SUPPLY DUCT UP FROM FLOOR BELOW. DUCTWORK SHALL BE ROUTED UP THROUGH NEW CHASE TO ABOVE CEILING AS SHOWN.
- 32"x24" RETURN AIR TEE WITH 40"x24" FLARED INLETS. 32"x18" RETURN AIR UP TO 3RD FLOOR MECHANICAL ROOM.
- WHERE NEW DUCTWORK CROSSES EXISTING DUCTWORK, ROUTE NEW DUCT ABOVE EXISTING DUCTWORK INSIDE ANNULAR SPACE BETWEEN CONCRETE JOISTS.
- TAP OFF OF MAIN DUCT USING RECTANGULAR 10"x10" DUCTWORK, MITERED ELBOW WITH TURNING VANES. TRANSITION TO 10" ROUND DUCT FOR WALL PENETRATION.
- TAP OFF OF MAIN DUCT USING RECTANGULAR 12"x12" DUCTWORK, MITERED ELBOW WITH TURNING VANES. TRANSITION TO 12" ROUND DUCT FOR WALL PENETRATION.
- 48"x18" TRANSFER AIR DUCT THROUGH WALL WITH FIRE DAMPER. DUCTWORK SHALL BE ACOUSTICALLY LINED WITH CLOSED CELL INSULATION, REFER TO SPECIFICATIONS.
- 32"x18" TRANSFER AIR DUCT, WITH FIRE DAMPER. DUCTWORK SHALL BE ACOUSTICALLY LINED WITH CLOSED CELL INSULATION, REFER TO SPECIFICATIONS.
- 32"x18" SUPPLY AIR DOWN FROM 3RD FLOOR MECHANICAL ROOM.

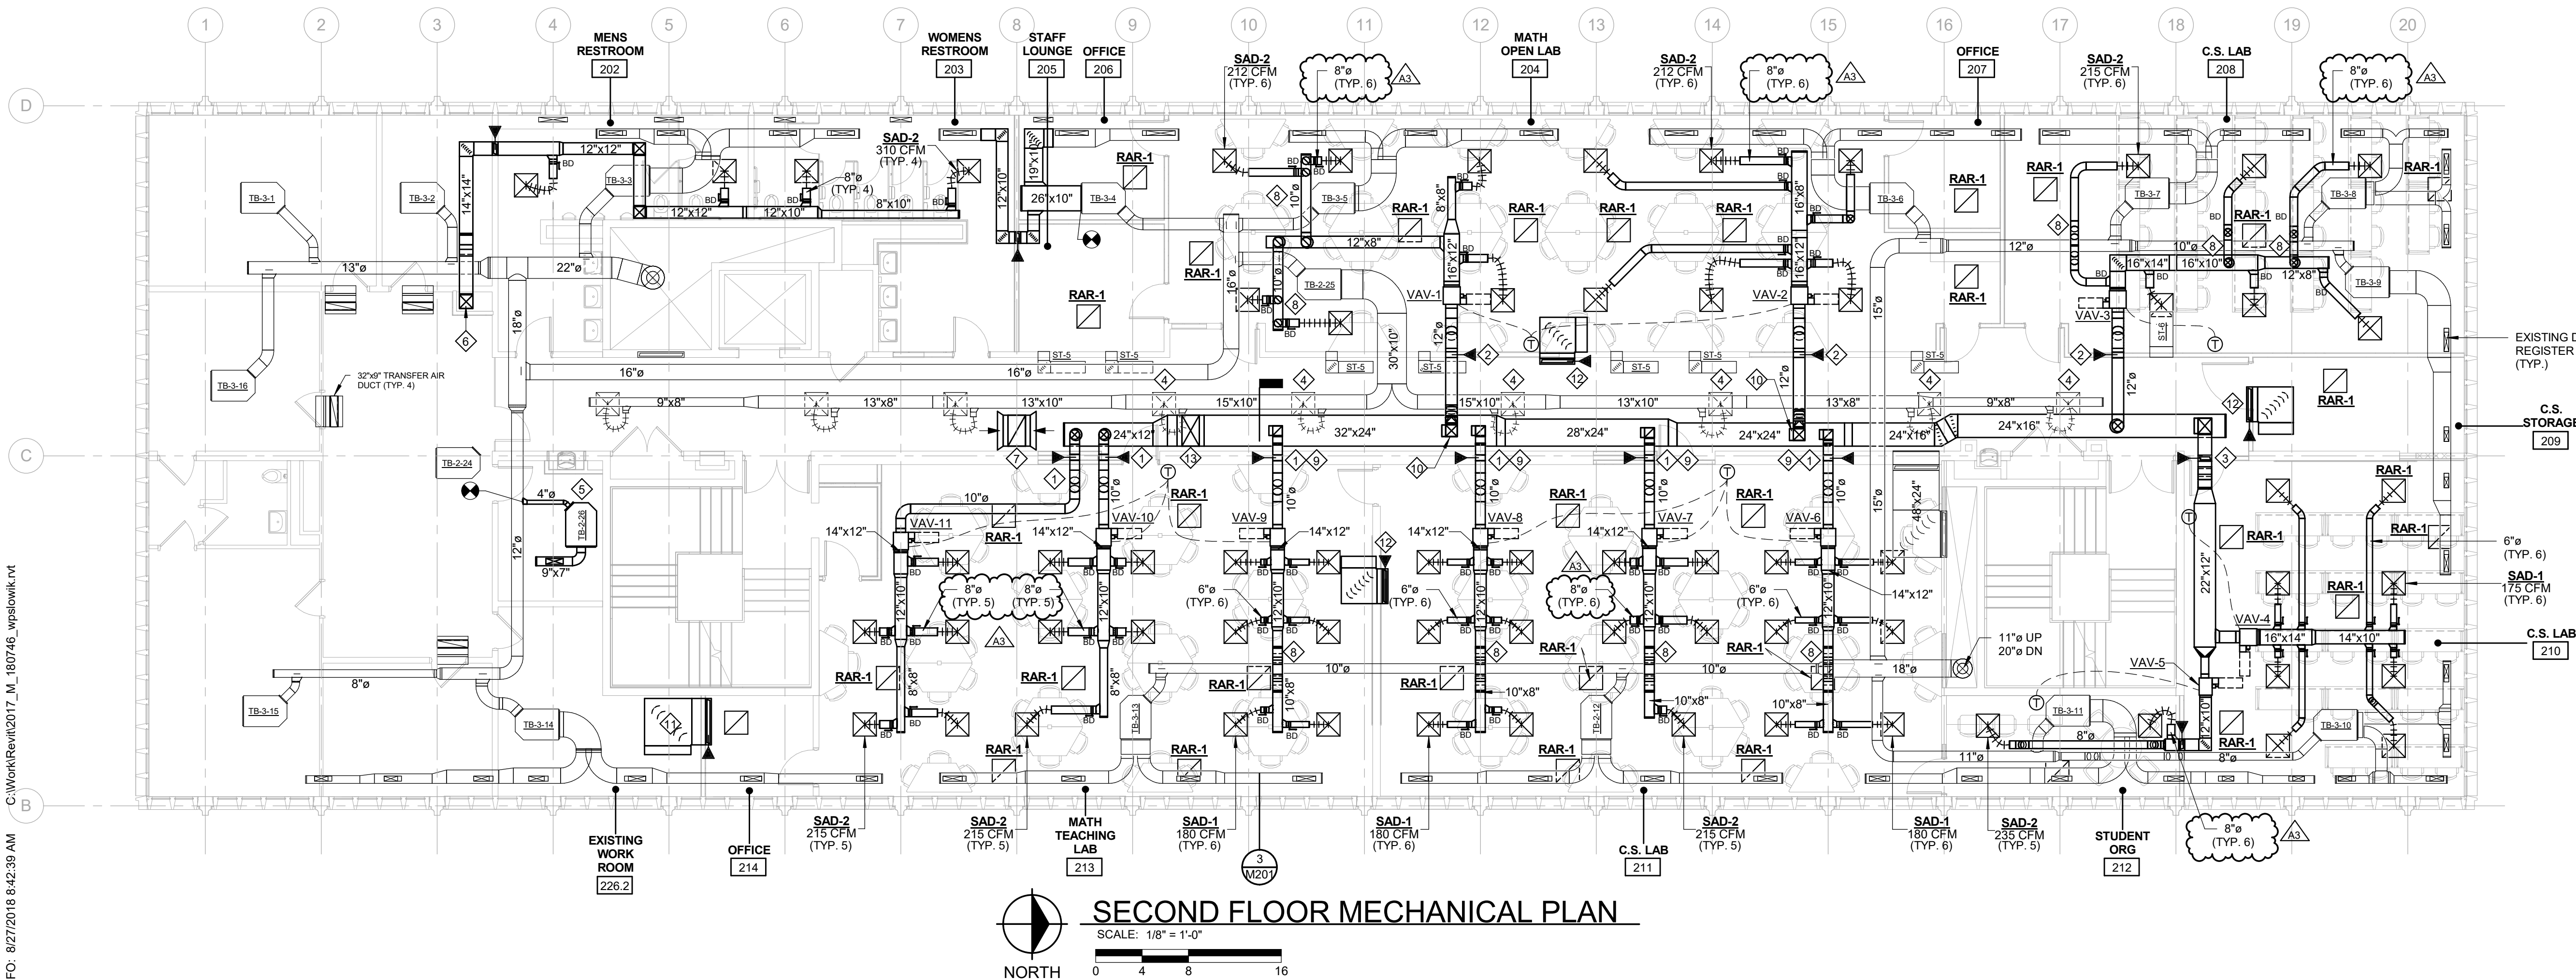

WAYNE STATE
UNIVERSITY

ftc&h

engineers
scientists
architects
constructors

fishbeck, thompson, carr & huber, inc.
www.ftc&h.com

Wayne State University

5201 Cass Ave, Detroit, MI 48202

Prentis Building Computer Lab Relocation
WSU Project: 022-313456

REVISIONS

8/23/2018 A3 ADDENDUM NO. 3

8/13/2018 BIDS

Drawn By sku

Designer sku

Reviewer PMO

Manager MMS

Hard copy is intended to be 24"x36" when plotted. Scale(s) indicated and graphic quality may not be accurate for any other size.


PROJECT NO.

180746

MEZZANINE AND SECOND
FLOOR MECHANICAL PLANS


M105

©Copyright 2018
All Rights Reserved

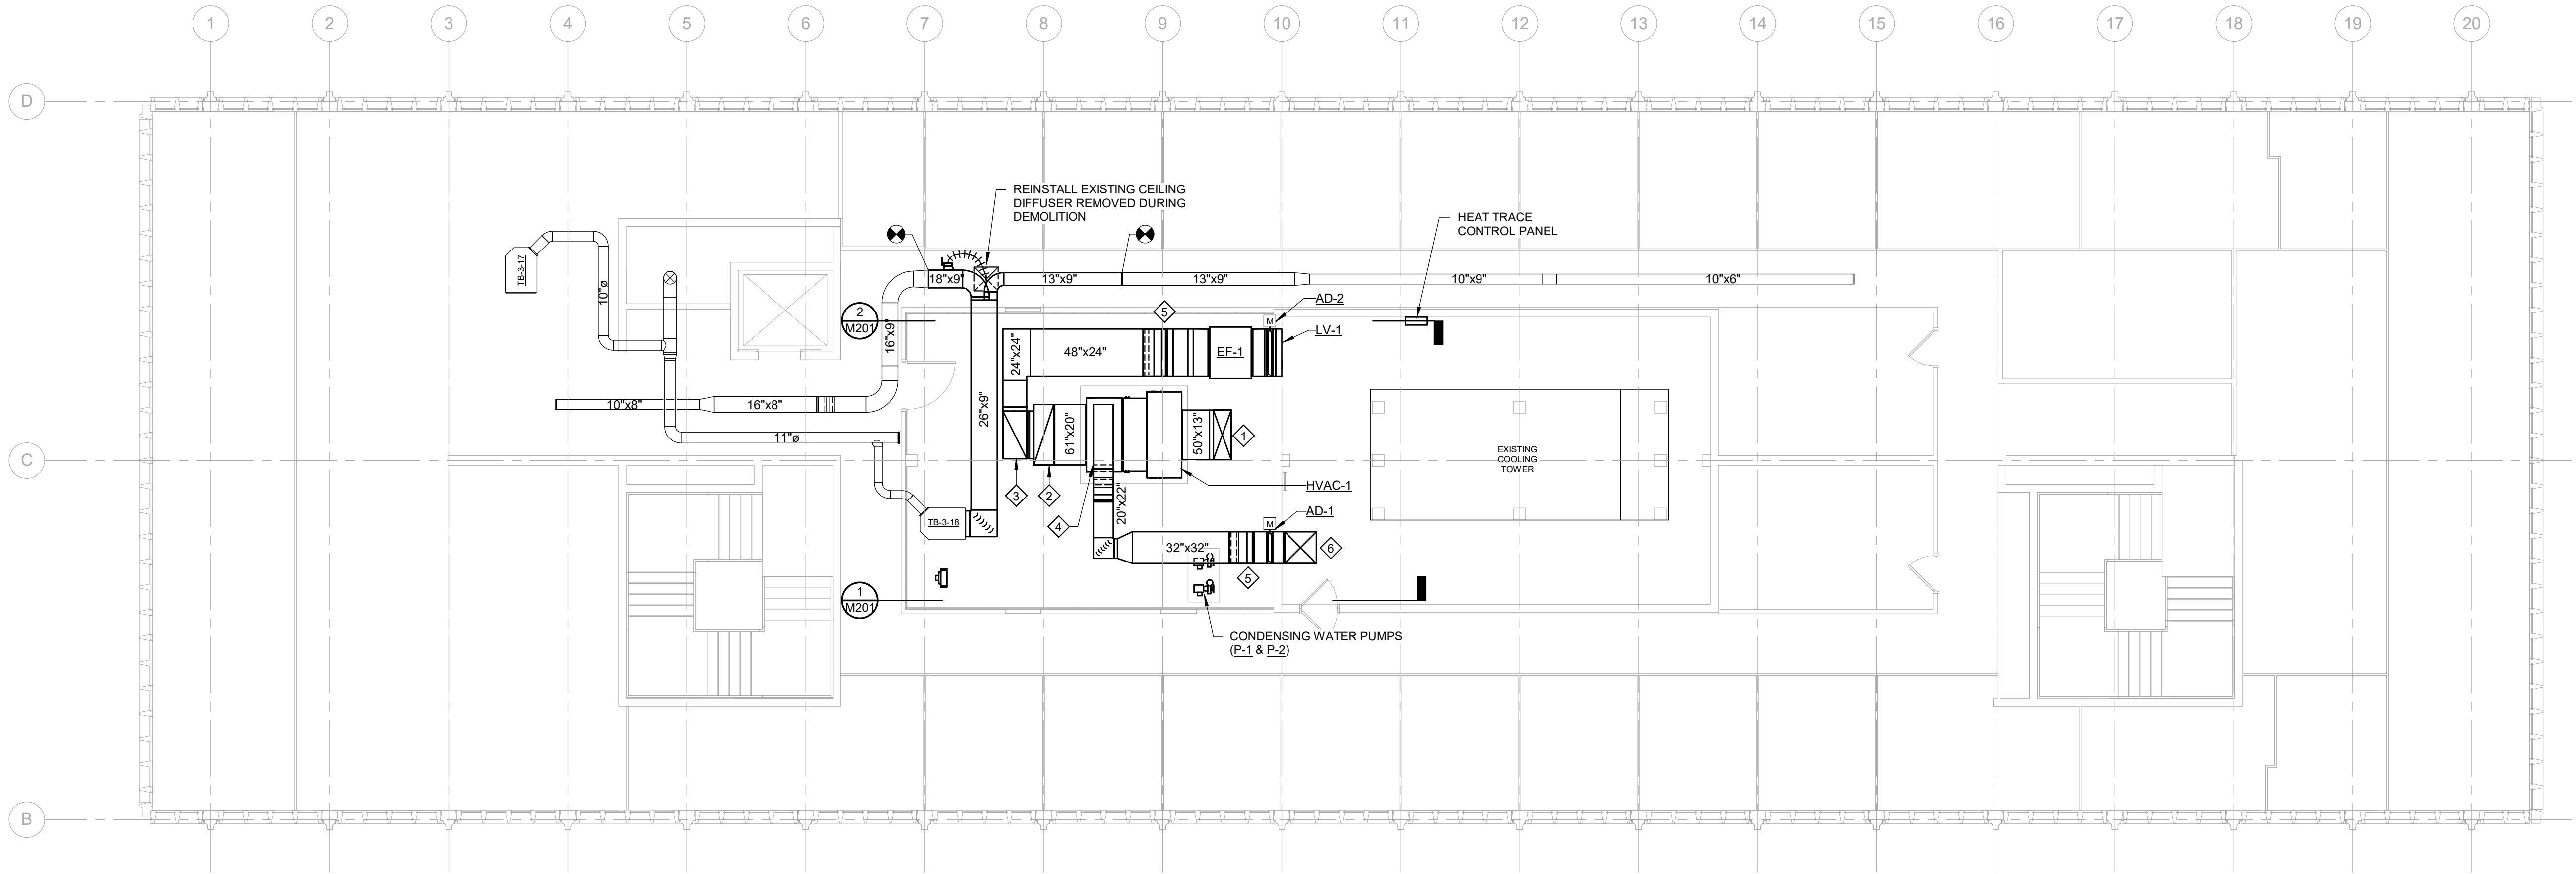

THIRD FLOOR MECHANICAL PLAN

SCALE: 1/8" = 1'-0"

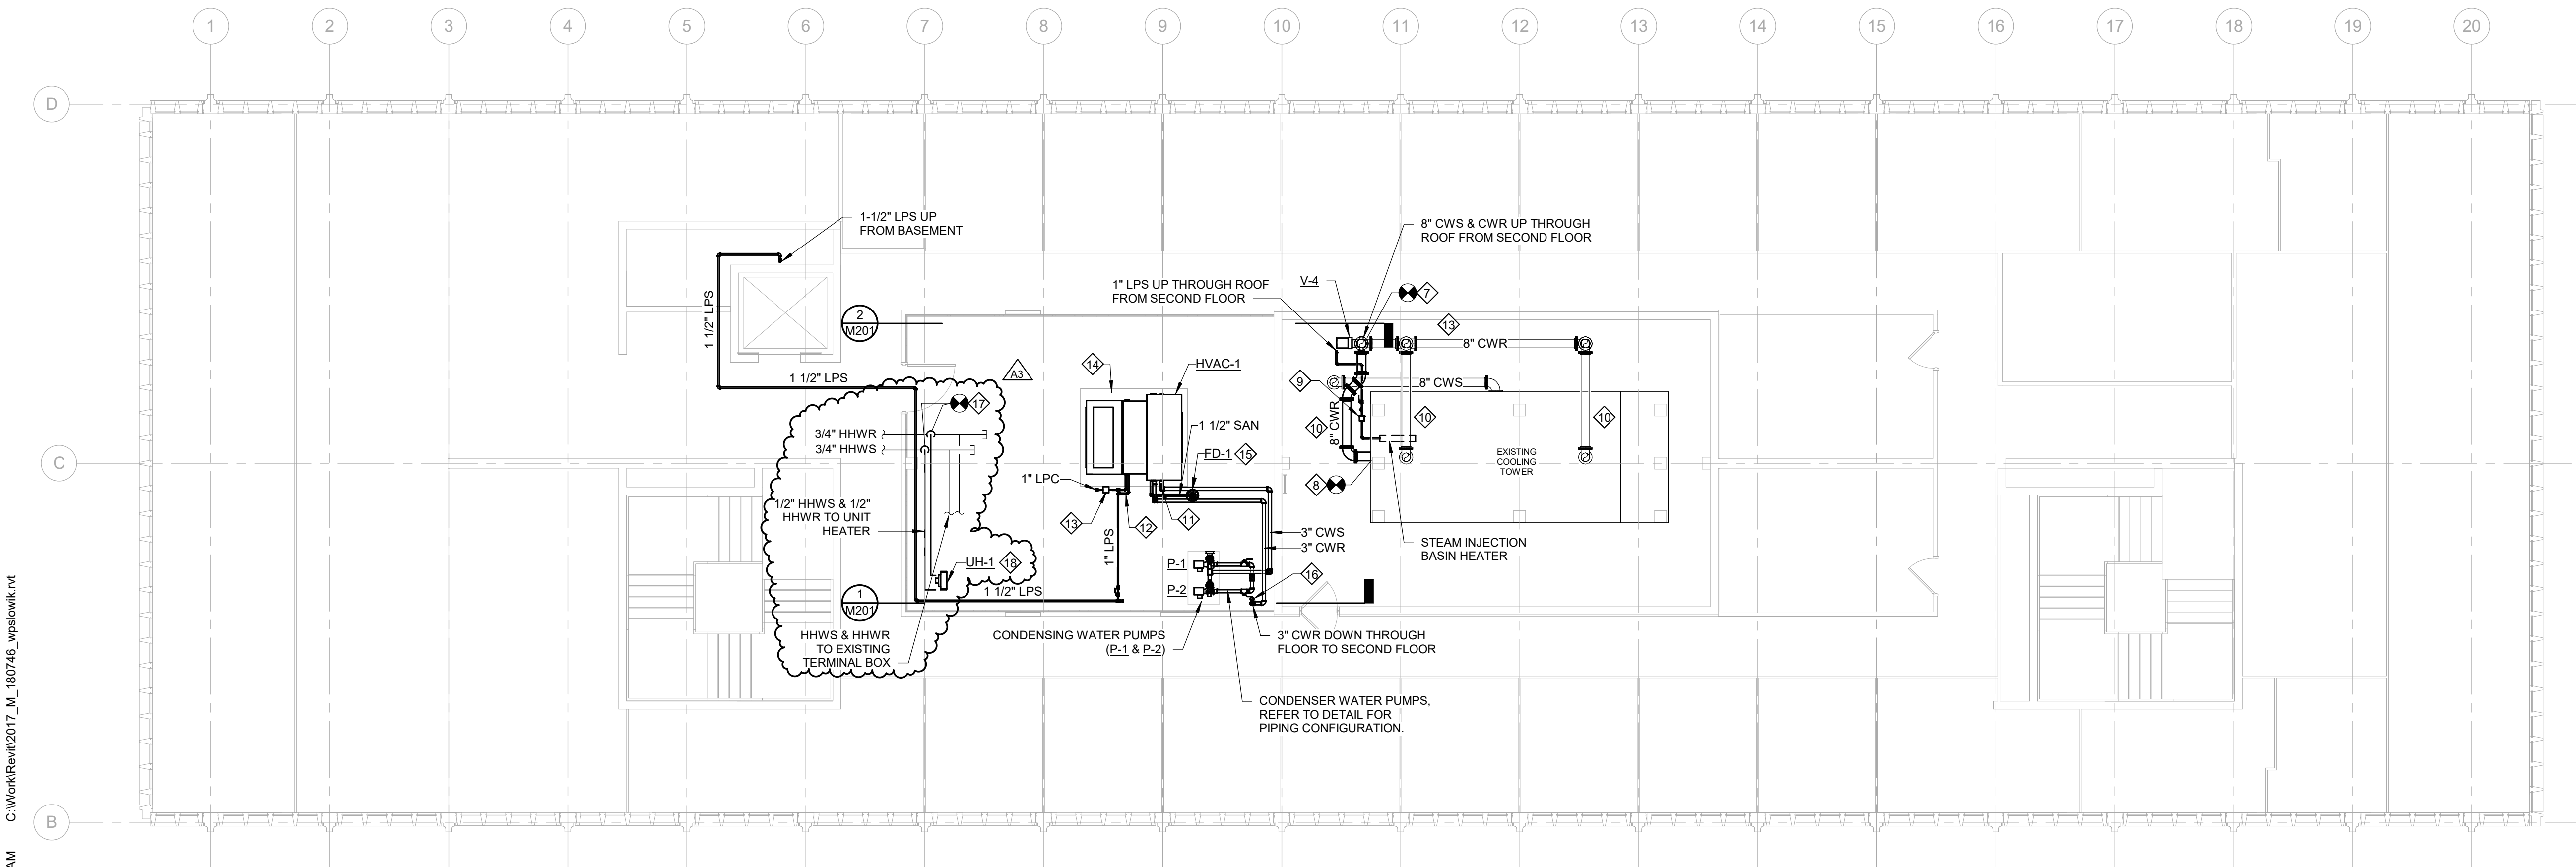

THIRD FLOOR MECHANICAL ROOM PIPING PLAN

SCALE: 1/8" = 1'-0"

NOTES

- ALL EXISTING CONDITIONS NOT SHOWN. CONTRACTOR SHALL FIELD VERIFY EXISTING CONDITIONS.
- EXISTING CONDITIONS SHOWN ARE BASED ON MINORU YAMASAKI AND ASSOCIATES DRAWINGS (PROJECT 6015), DATED 5-7-1962.
- ALL EXISTING AND NEW EXTERIOR CONDENSING WATER PIPING (CWS & CWR) SHALL BE HEAT TRACED AND INSULATED.
- ALL EXTERIOR STEAM PIPING SHALL BE HEAT TRACED AND INSULATED. ALL INTERIOR STEAM PIPING SHALL BE INSULATED.

KEY NOTES

- 50"x13" SUPPLY AIR DISCHARGE FROM HVAC-1. TRANSITION TO 18"x32" TO PENETRATE FLOOR DOWN TO FLOOR BELOW.
- 60"x20" RETURN AIR TO HVAC-1. TRANSITION TO 18"x32" TO PENETRATE FLOOR DOWN TO FLOOR BELOW.
- 48"x24" RELIEF AIR CONNECTED INTO 60"x20" RETURN AIR DUCT. TRANSITION TO 24"x24" AND ROUTE UP TO CEILING. THEN TRANSITION BACK TO 48"x24" AT MECHANICAL ROOM WALL.
- 20"x22" OUTSIDE AIR TO HVAC-1. DUCTWORK SHALL BE ROUTED TIGHT TO CEILING INSIDE ANNULAR SPACE BETWEEN CONCRETE JOISTS.
- DUCTWORK SHALL BE ROUTED TIGHT CEILING. TRANSITION DOWN TO MAKE EQUIPMENT CONNECTION AND WALL PENETRATION TO THE EXTERIOR.
- 32"x32" OUTSIDE AIR THROUGH WALL AND UP TO ROOF LEVEL. REFER TO ROOF LEVEL PLAN FOR CONTINUATION.
- INSTALL NEW 3-WAY COOLING TOWER BYPASS VALVE ON EXISTING 8" CONDENSING WATER RETURN.
- CONNECT 8" CONDENSING WATER RETURN FROM BYPASS VALVE INTO EXISTING COOLING TOWER COLD WATER BASIN. INSTALL NEW 8" FLANGED CONNECTION TO COLD WATER BASIN.
- 1" LPS TO CONTROL VALVE AND STEAM INJECTION BASIN HEATER. INSTALL NEW STEAM INJECTION HEATER IN COOLING TOWER BASIN PER DETAIL 8 / M501. INSULATE AND HEAT TRACE 1" LPS PIPING.
- INSULATE AND HEAT TRACE ALL EXISTING AND NEW EXTERIOR CWS AND CWR PIPING.
- 3" CWS AND CWR CONNECTED INTO HVAC-1. REFER TO COOLING TOWER AND CONDENSING WATER PIPING DIAGRAM ON M602 FOR ADDITIONAL DETAILS.
- 1" LPS TO HVAC-1 STEAM HEATING COIL CONTROL VALVE (CONTROL VALVE INTEGRAL TO HVAC-1).
- 1" LPC FROM HVAC-1 STEAM HEATING COIL. INSTALL STEAM TRAP PER DETAIL 2 / M502. 1" LPC DOWN THROUGH FLOOR TO SECOND FLOOR.
- CONCRETE EQUIPMENT PAD, 9'-0" L x 9'-0" W x 4" T.
- INSTALL NEW FLOOR DRAIN FD-1. 1-1/2" CONDENSATE DRAIN FROM HVAC-1 TO FLOOR DRAIN. TERMINATE PIPE 1" ABOVE RIM OF DRAIN. HVAC UNIT HAS INTERNAL P-TRAP. DO NOT INSTALL P-TRAP EXTERNAL FROM UNIT.
- 2" SANITARY VENT UP FROM FLOOR BELOW CONTINUES UP TO ROOF. TRANSITION TO 3" AND VENT THROUGH ROOF.
- CONNECT NEW 1/2" HHWS & 1/2" HHWR PIPING INTO EXISTING 3/4" HHWS & HHWR PIPING.
- INSTALL NEW HYDRONIC UNIT HEATER (UH-1). MOUNT BOTTOM OF HEATER 8'-0" ABOVE FINISHED FLOOR. REFER TO DETAIL 10 / M502 FOR PIPING DETAIL.



WAYNE STATE
UNIVERSITY

fitch

engineers
scientists
architects
constructors

fishbeck, thompson, carr & huber, inc.
www.fitch.com

Wayne State University

5201 Cass Ave, Detroit, MI 48202

Prentis Building Computer Lab Relocation

WSU Project: 022-313456

REVISIONS

8/23/2018 A3 ADDENDUM NO. 3

8/13/2018 BIDS

Drawn By sku

Designer sku

Reviewer PMO

Manager MMS

Hard copy is intended to be 24"x36" when plotted. Scale(s) indicated and graphic quality may not be accurate for any other size.

PROJECT NO.


180746

THIRD FLOOR MECHANICAL
PLANS

M106

©Copyright 2018
All Rights Reserved

PLOT INFO: 8/27/2018 8:42:45 AM C:\Work\Revit\2017_M_180746_wpslowik.rvt

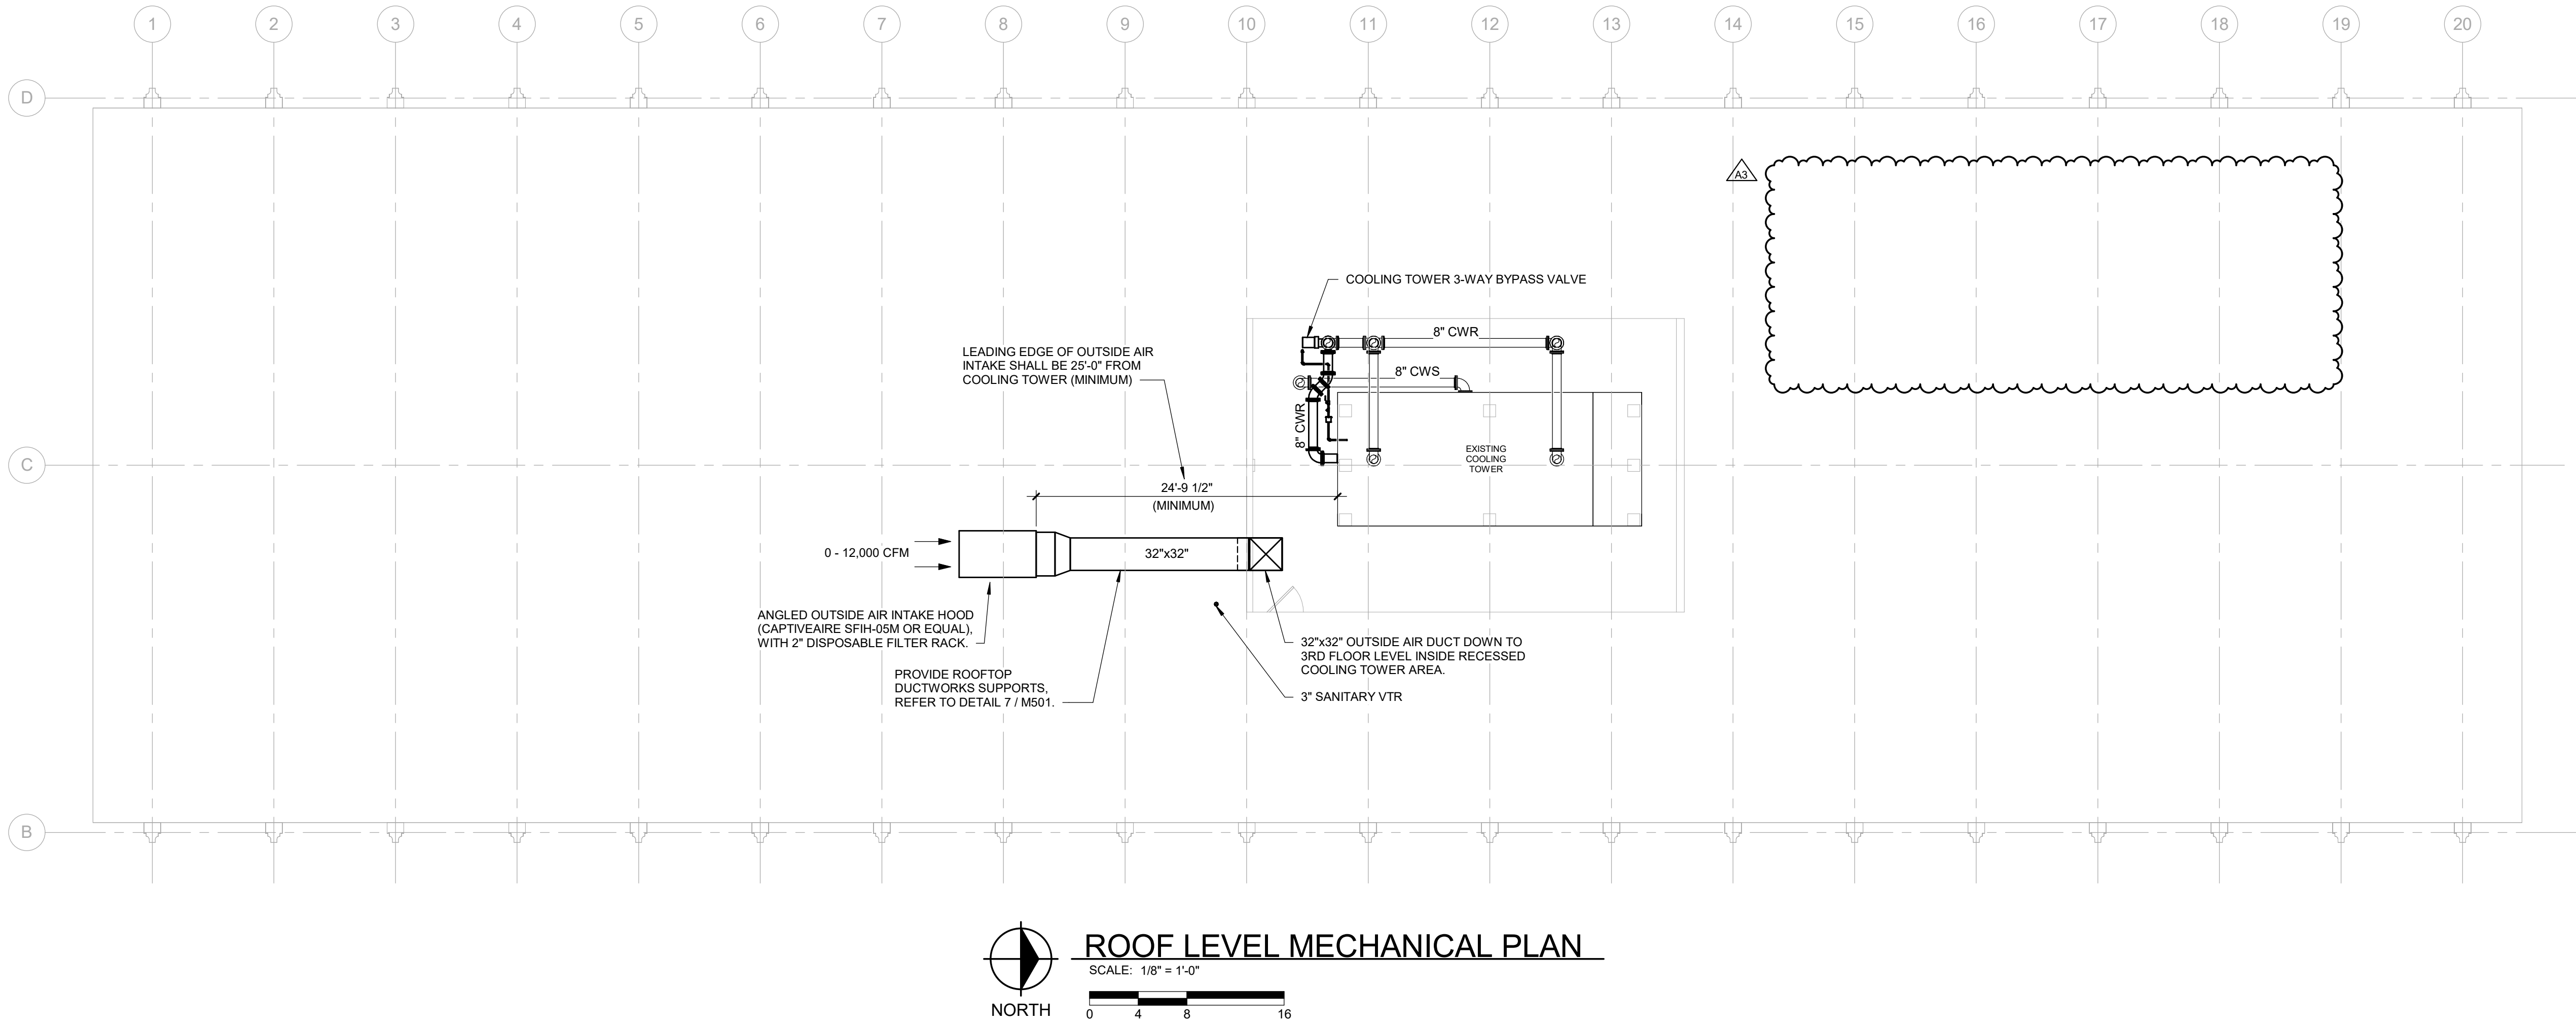

NOTES

1. ALL EXISTING CONDITIONS NOT SHOWN, CONTRACTOR SHALL FIELD VERIFY EXISTING CONDITIONS.
2. EXISTING CONDITIONS SHOWN ARE BASED ON MINORU YAMASAKI AND ASSOCIATES DRAWINGS (PROJECT 6015), DATED 5-7-1962.



WAYNE STATE
UNIVERSITY

ftc&h

engineers
scientists
architects
constructors

fishbeck, thompson, carr & huber, inc.
www.ftch.com

Wayne State University

5201 Cass Ave, Detroit, MI 48202

Prentis Building Computer Lab Relocation

WSU Project: 022-313456

REVISIONS

8/23/2018	A3	ADDENDUM NO. 3
-----------	----	----------------

8/13/2018 BIDS

Drawn By

Designer

Reviewer

Manager MMS

Hard copy is intended to be 24"x36" when plotted. Scale(s) indicated and graphic quality may not be accurate for any other size.

PROJECT NO.




180746

ROOF LEVEL MECHANICAL
PLAN

M107

©Copyright 2018
All Rights Reserved

PLOT INFO: 8/27/2018 8:42:48 AM C:\Work\Revit\2017_M_180746_wpslowik.rvt

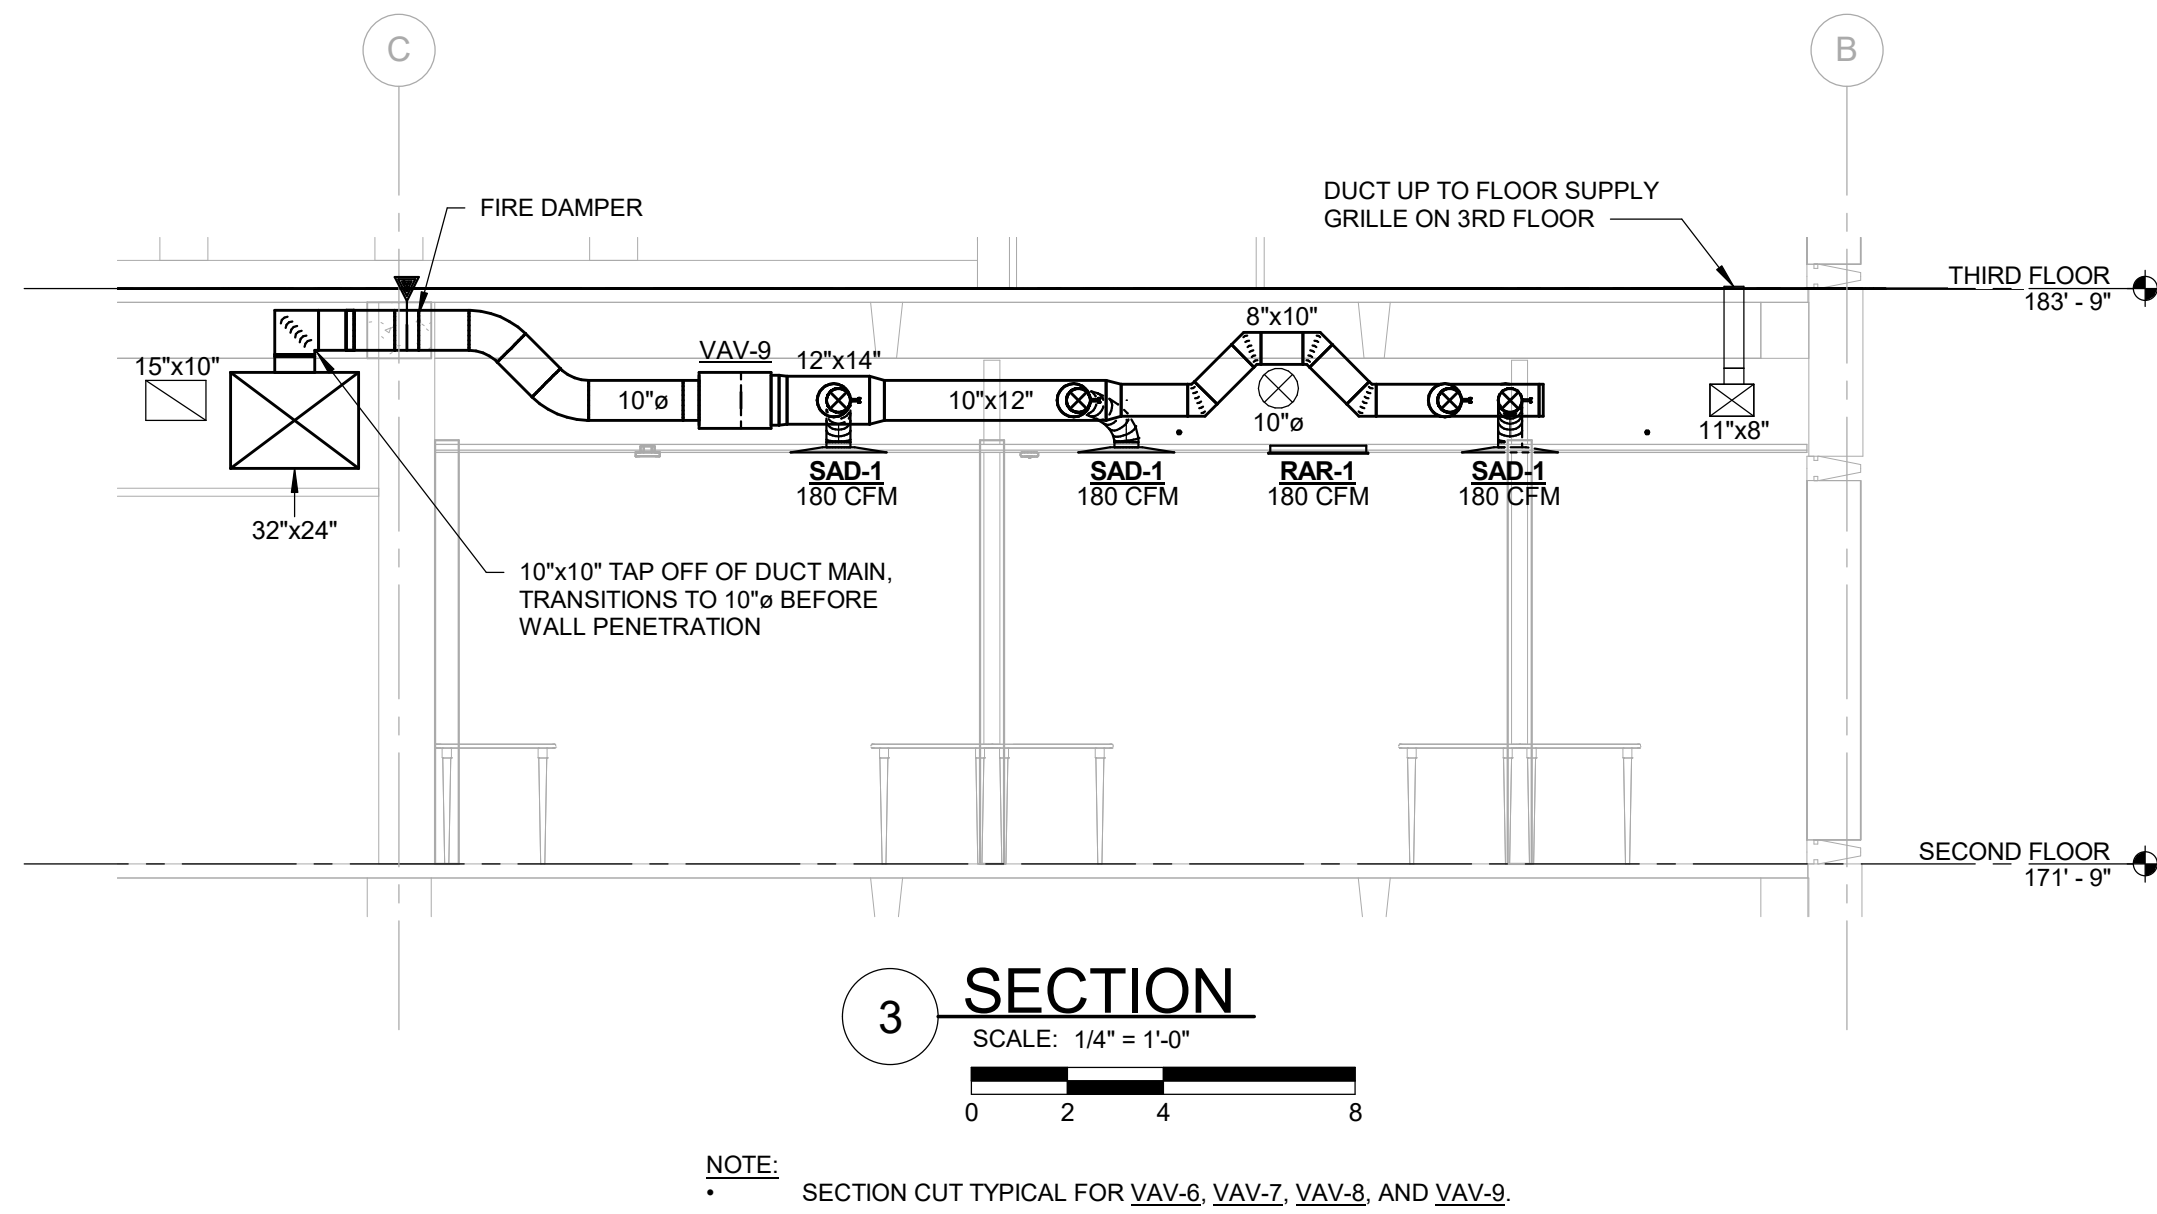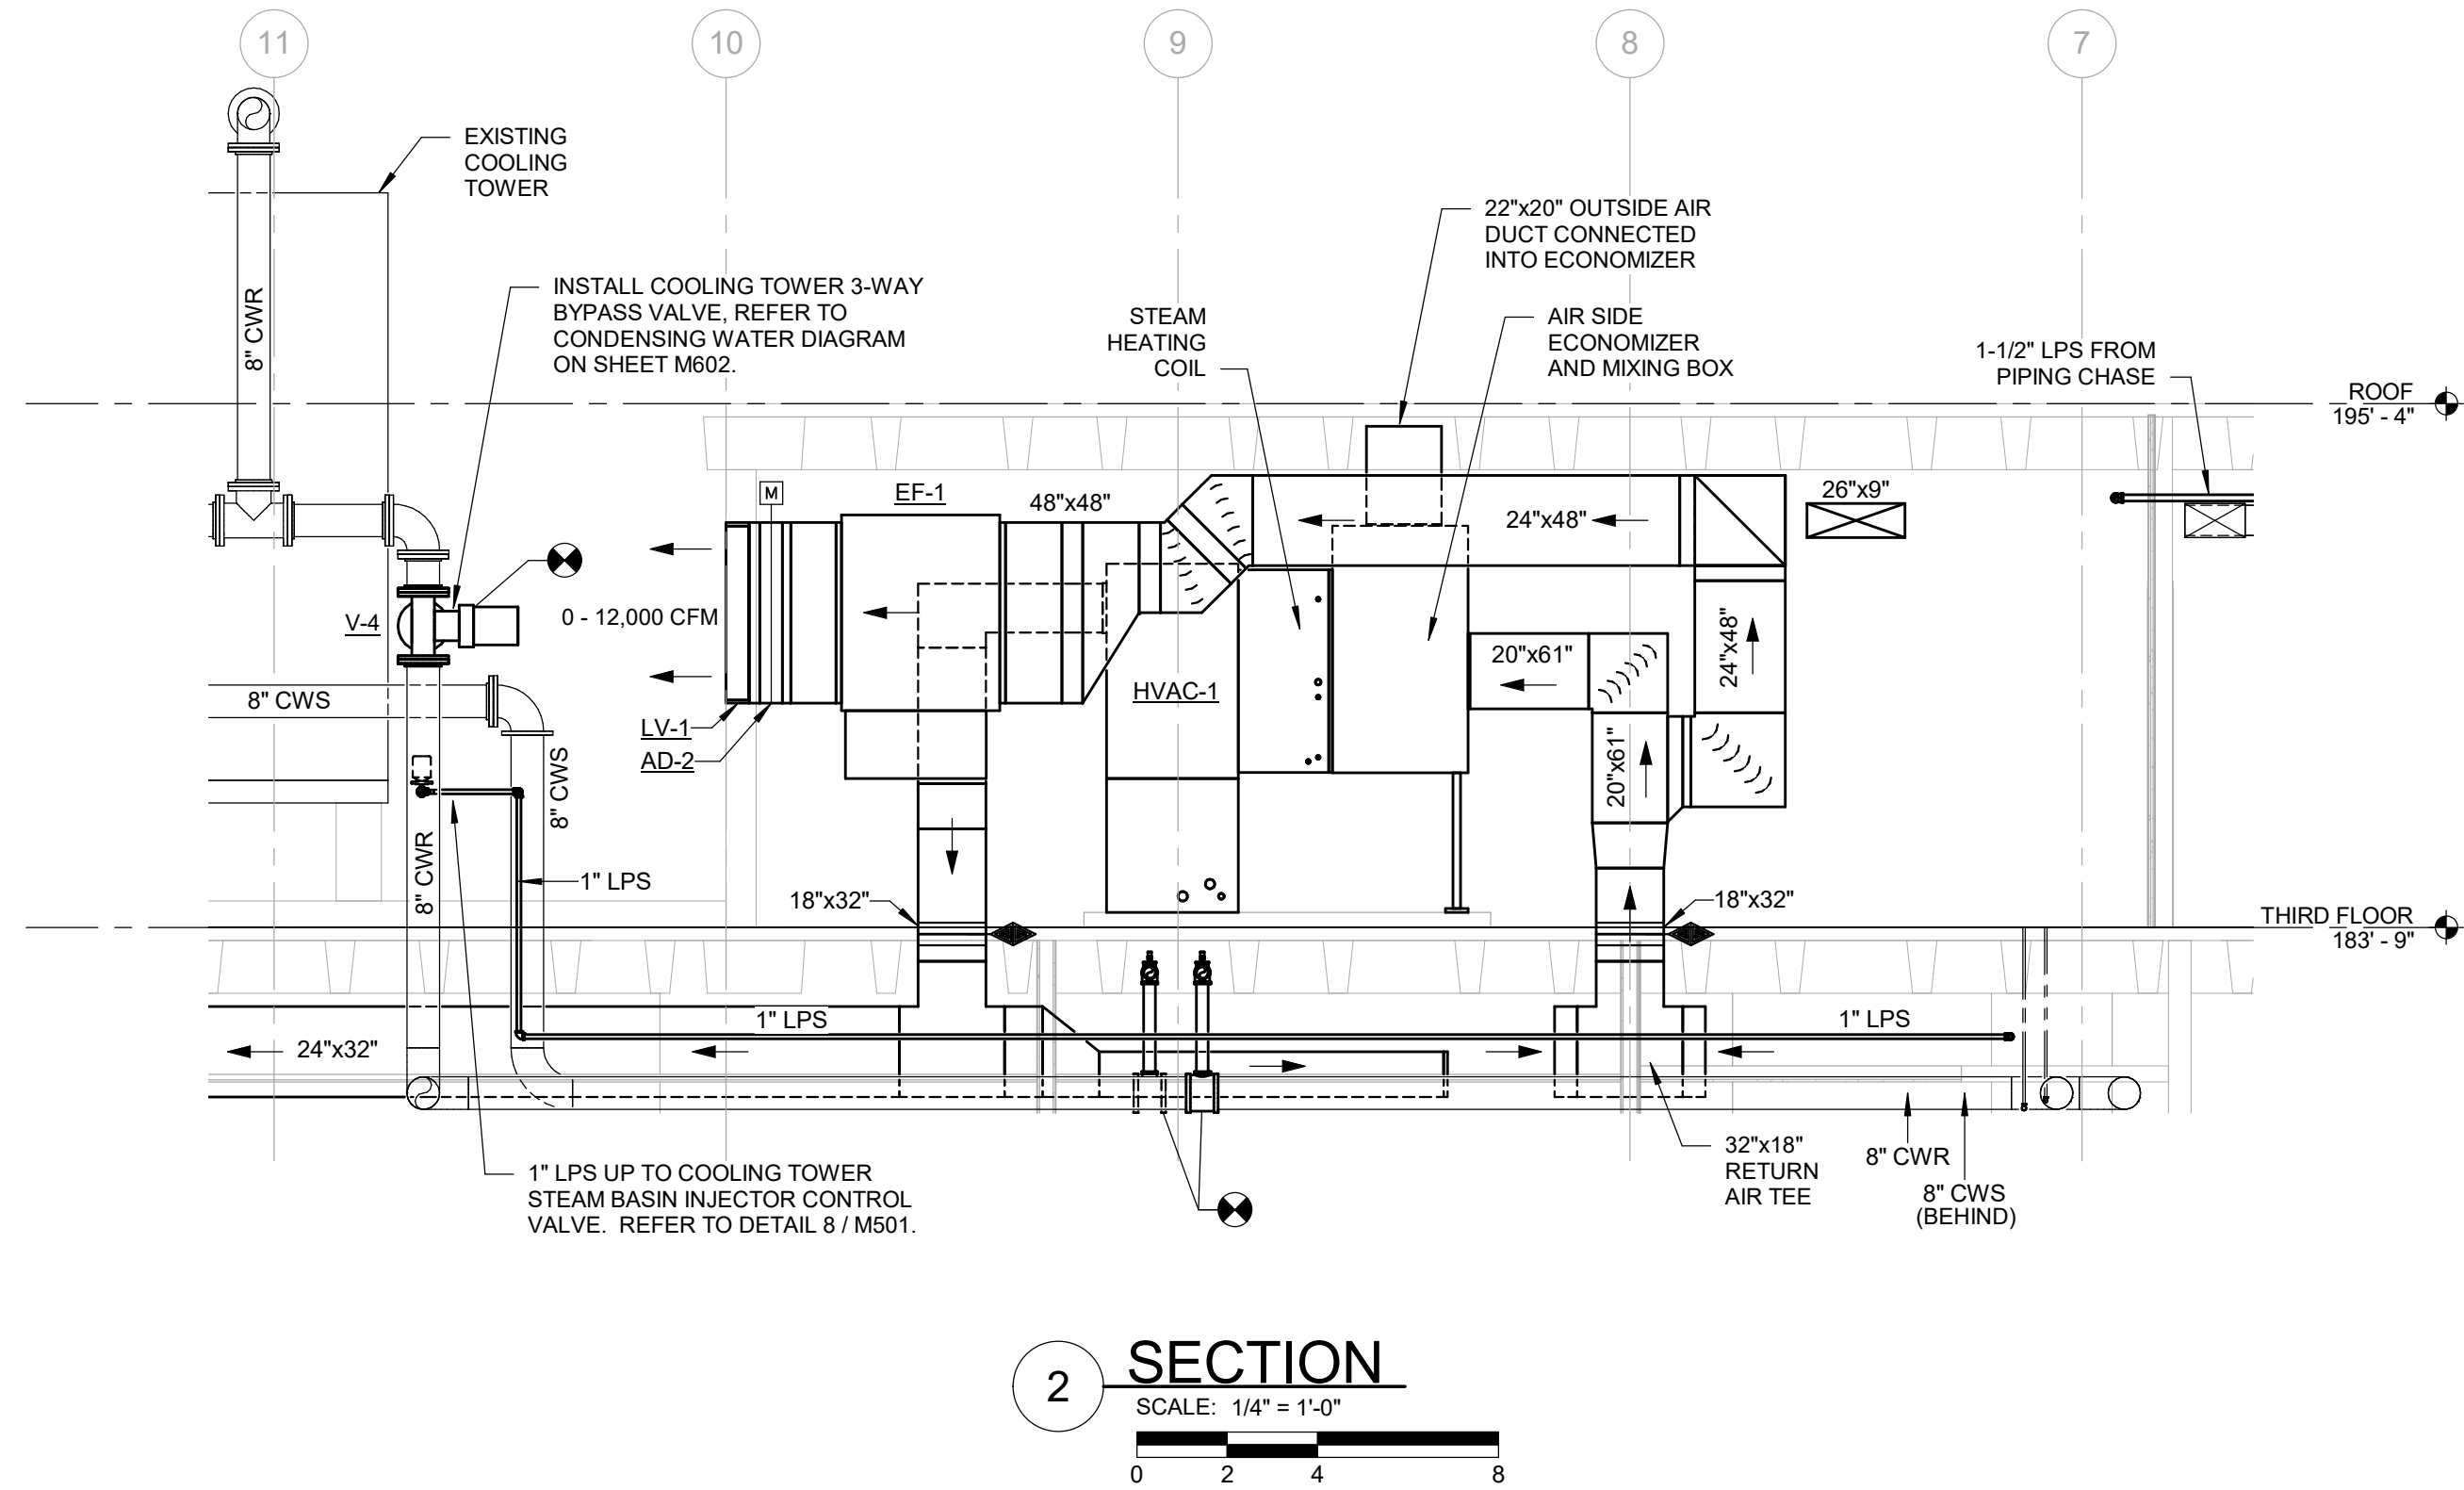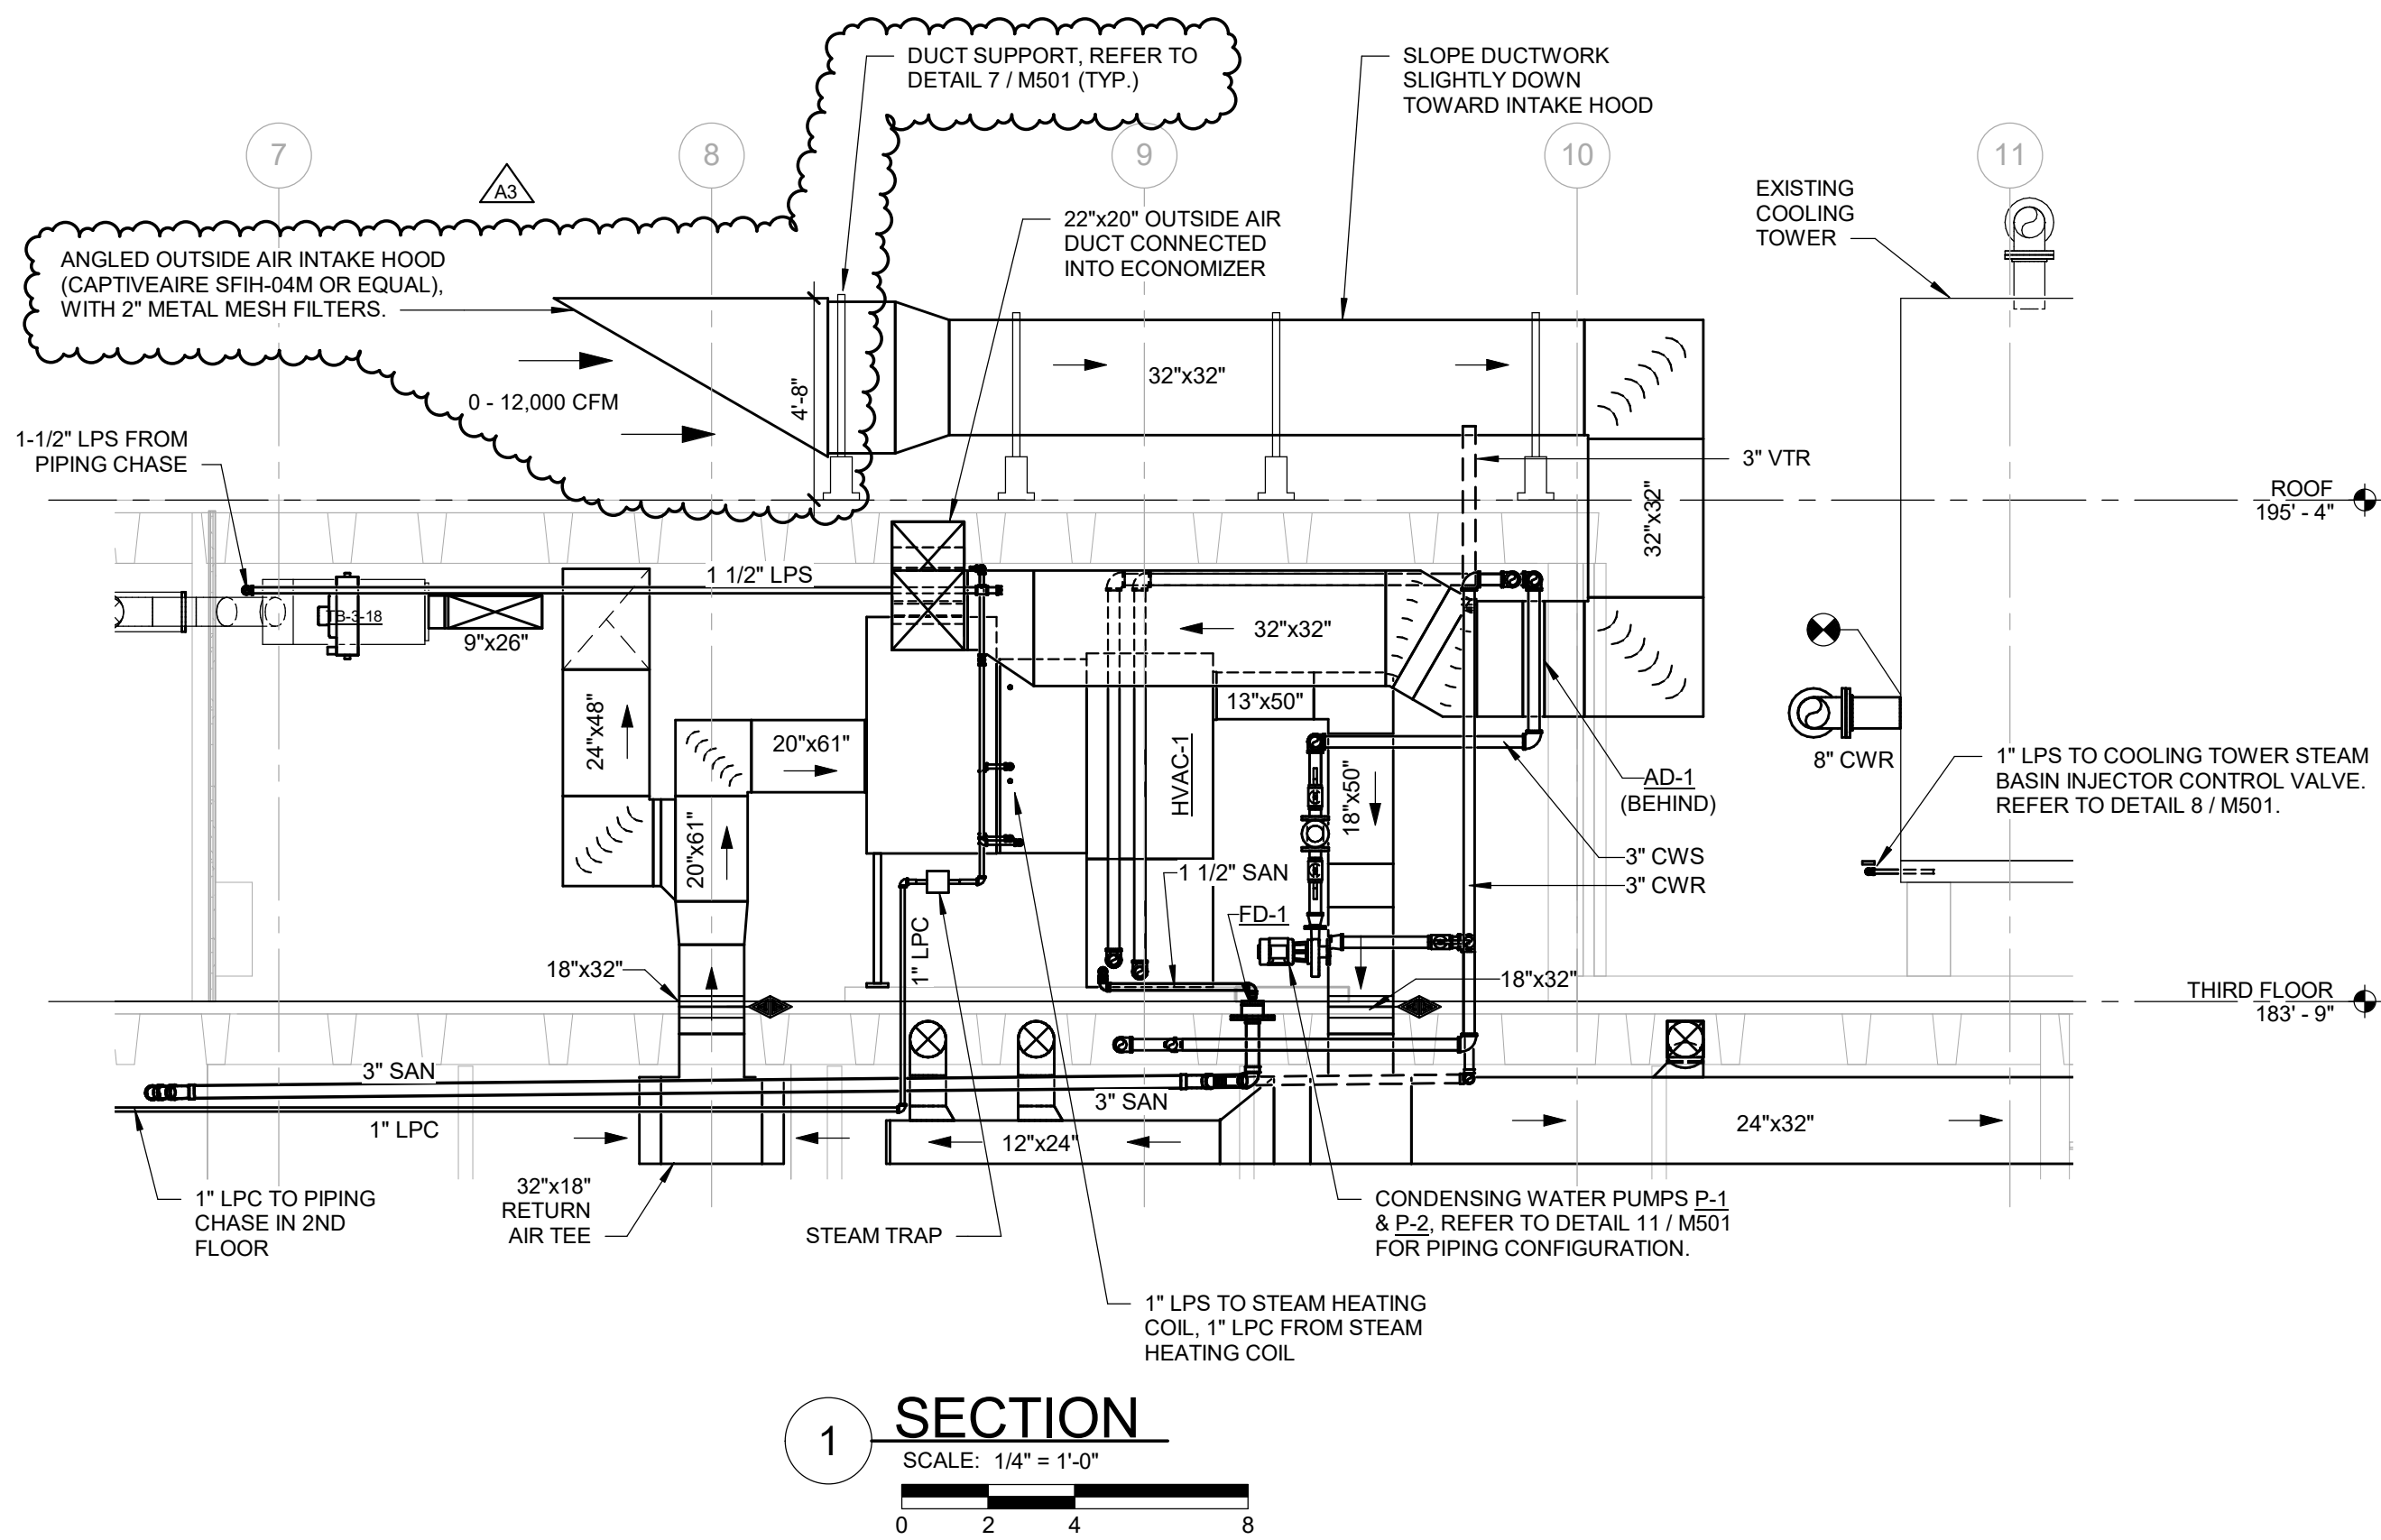

WAYNE STATE
UNIVERSITY

ftc&h

engineers
scientists
architects
constructors

fishbeck, thompson, carr & huber, inc.
www.ftch.com

Wayne State University

5201 Cass Ave, Detroit, MI 48202

Prentis Building Computer Lab Relocation

WSU Project: 022-313456

REVISIONS		
8/23/2018	A3	ADDENDUM NO. 3

8/13/2018	BIDS
Drawn By	sku
Designer	sku
Reviewer	PMO
Manager	MMS


Hard copy is intended to be 24"x36" when plotted. Scale(s) indicated and graphic quality may not be accurate for any other size.

PROJECT NO.
180746

MECHANICAL SECTIONS


M201

©Copyright 2018
All Rights Reserved

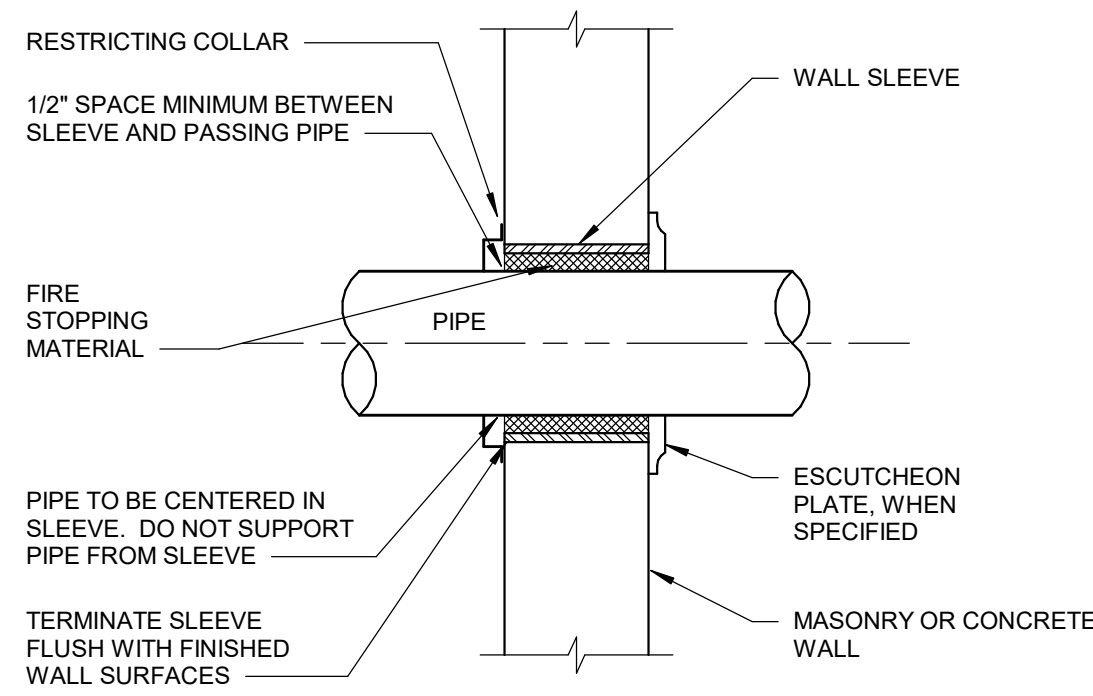


NOTE:
USE TYPE 5 WALL SLEEVE FOR ALL PIPING PASSING THROUGH NEW FIRE RATED INTERIOR MASONRY OR CONCRETE WALLS.

1 WALL SLEEVE DETAIL - TYPE 5
NO SCALE

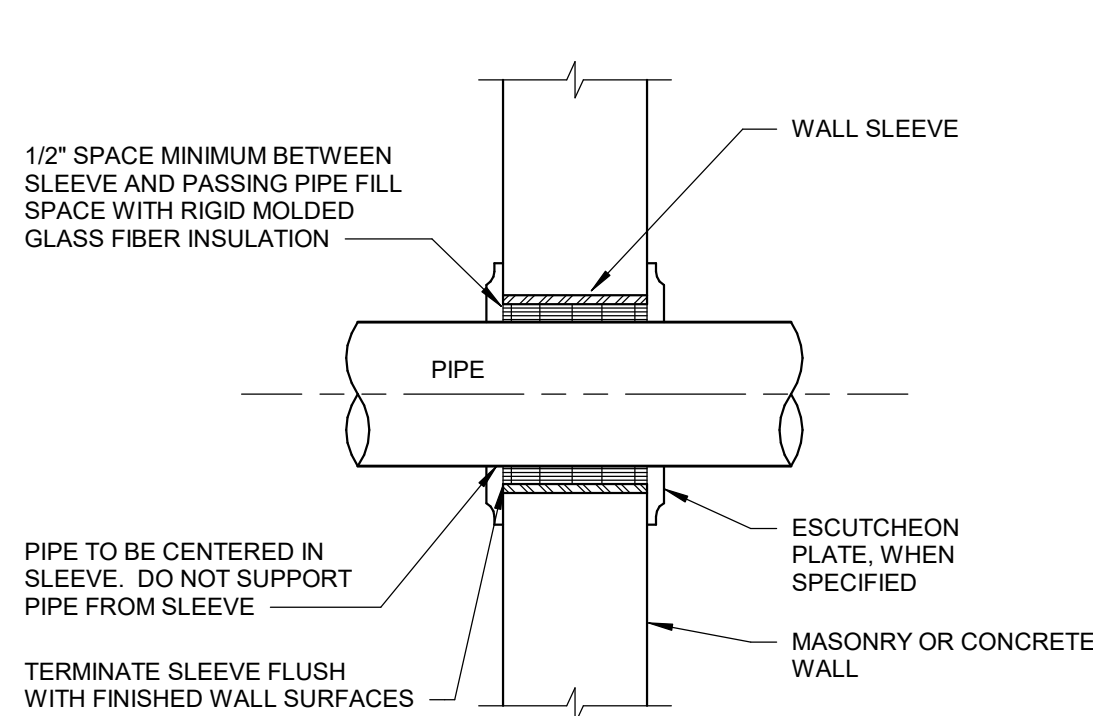


NOTE:
USE TYPE 6 WALL SLEEVE FOR ALL PIPING PASSING THROUGH NEW INTERIOR NON-FIRE RATED MASONRY OR CONCRETE WALLS.

2 WALL SLEEVE DETAIL - TYPE 6
NO SCALE

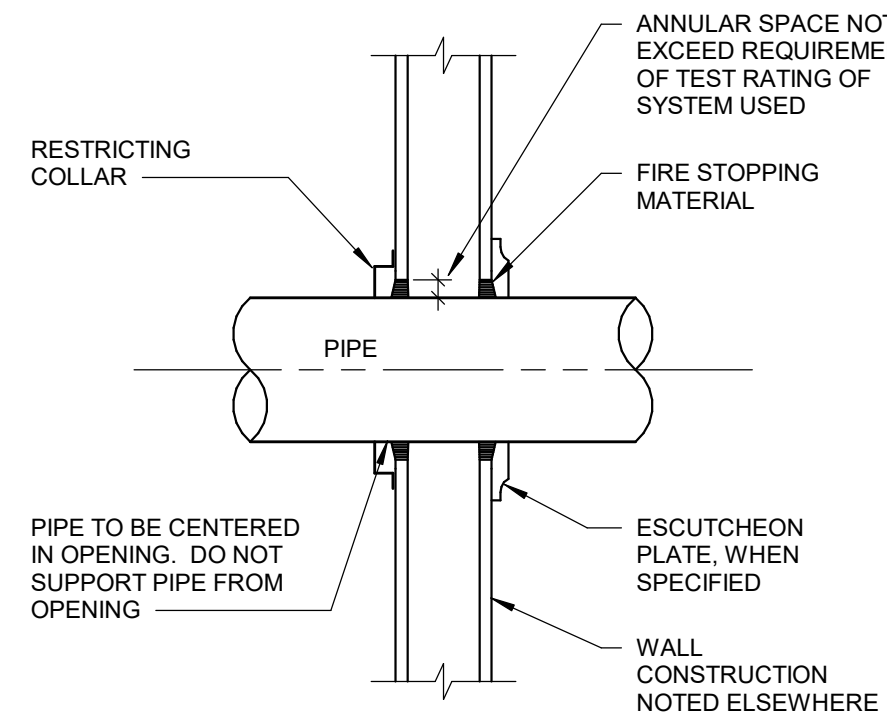


NOTE:
USE TYPE 4 WALL PENETRATION FOR ALL PIPING PASSING THROUGH NEW FIRE RATED INTERIOR STUD WALLS.

3 WALL PENETRATION DETAIL - TYPE 4
NO SCALE

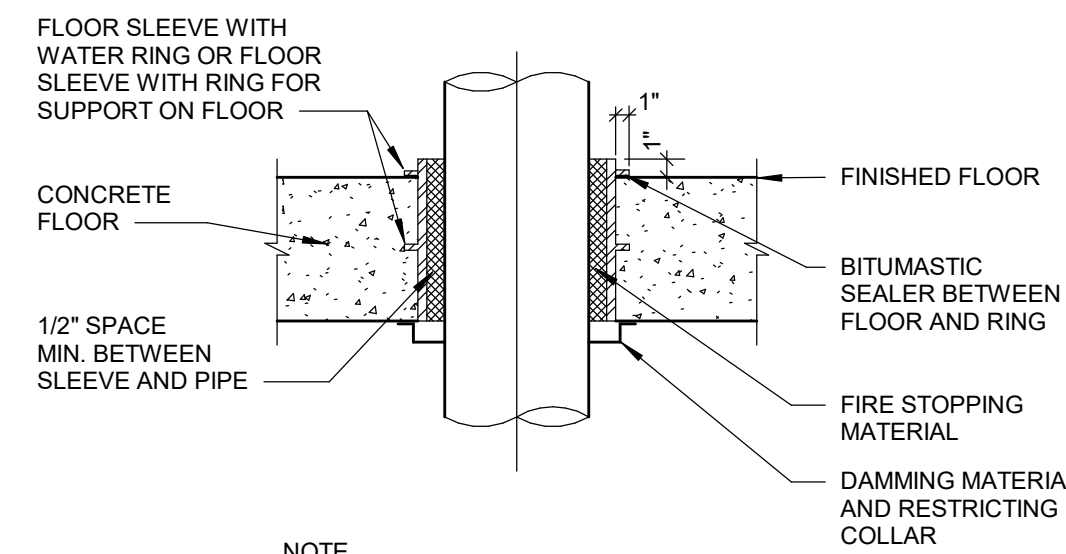


NOTE:
USE TYPE 3 FLOOR SLEEVE FOR ALL PIPING PASSING THROUGH NEW OR EXISTING FIRE RATED CONCRETE FLOORS.

4 FLOOR SLEEVE DETAIL - TYPE 3
NO SCALE

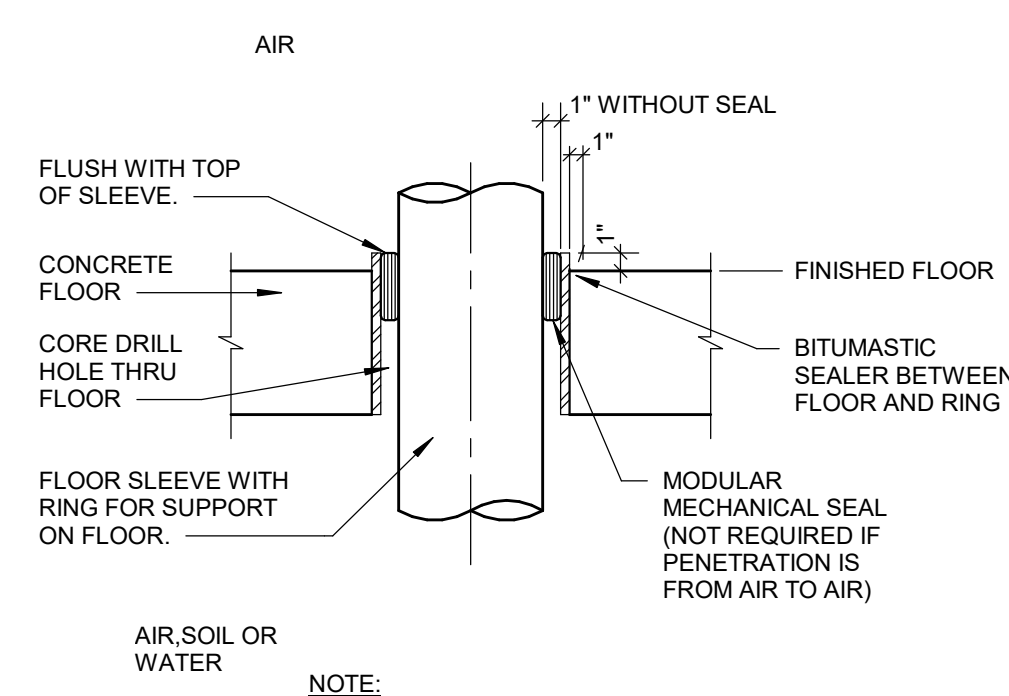


NOTE:
USE TYPE 2 FLOOR SLEEVE FOR ALL PIPING PASSING THROUGH CORED HOLE IN EXISTING NON-FIRE RATED CONCRETE FLOORS.

5 FLOOR SLEEVE DETAIL - TYPE 2
NO SCALE

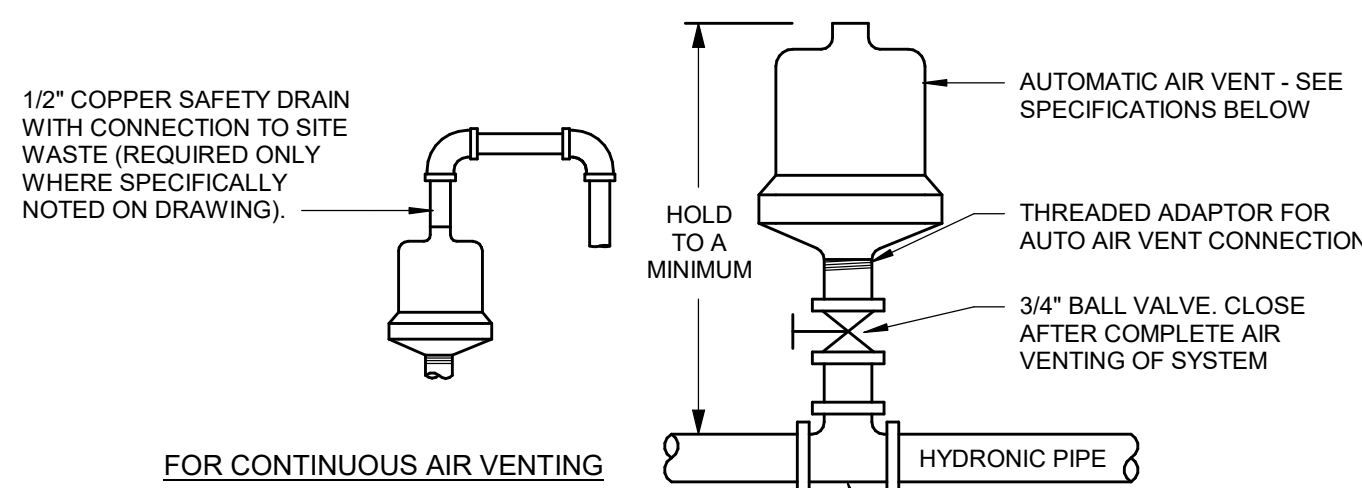


AUTOMATIC VENT

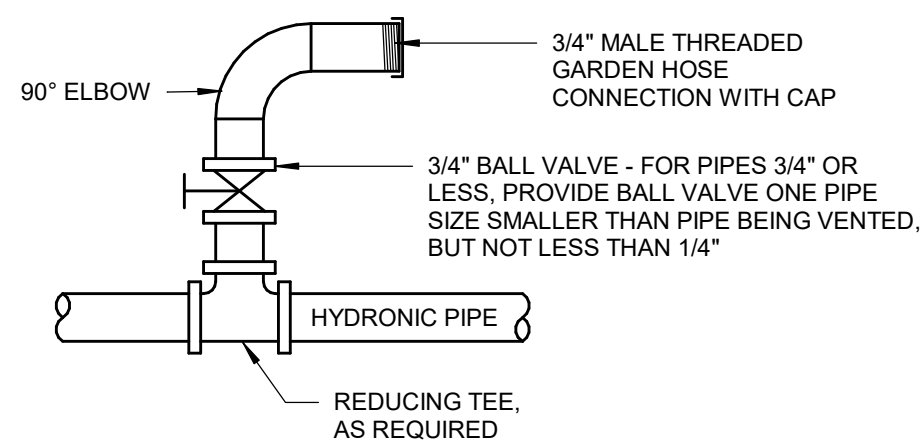


MANUAL VENT

- NOTES:
1. AUTOMATIC AIR VENTS ARE REQUIRED AT EACH HIGH POINT IN HYDRONIC PIPING LOCATED TO COMPLETELY VENT AIR FROM WATER SYSTEMS.
 2. FOR PIPE SIZES 2-1/2" AND LARGER, PROVIDE BELL & GOSSETT MODEL 78 AIR VENT, OR ARMSTRONG NO.75, RATED FOR 150 PSI.
 3. FOR PIPE SIZES 2" AND LESS, PROVIDE BELL & GOSSETT MODEL 87 AIR VENT, OR ARMSTRONG NO.75, RATED FOR 150 PSI.
 4. WHEN AUTOMATIC AIR VENT INSTALLATION IS NOT POSSIBLE, OR WHEN MANUAL VENTS ARE INDICATED, PROVIDE A BALL VALVE AND HOSE THREAD CONNECTION.

6 WATER SYSTEM AIR VENT DETAILS
NO SCALE

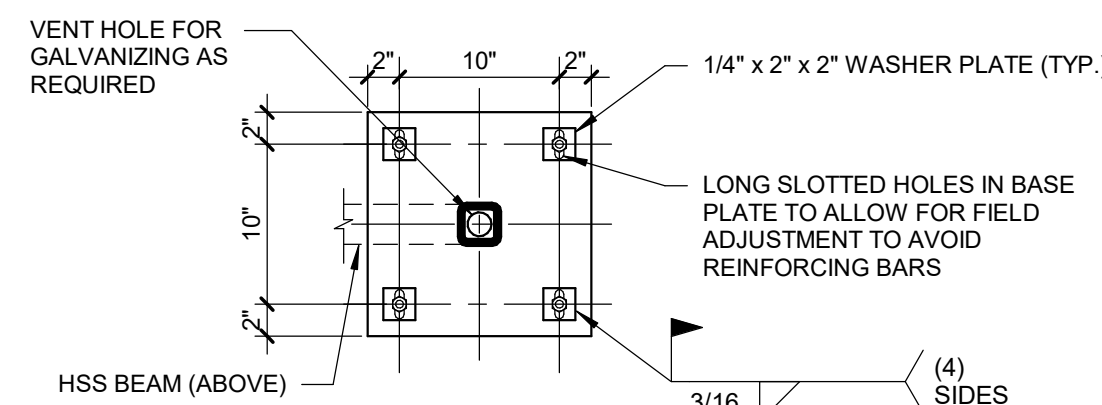


BASE PLATE PLAN

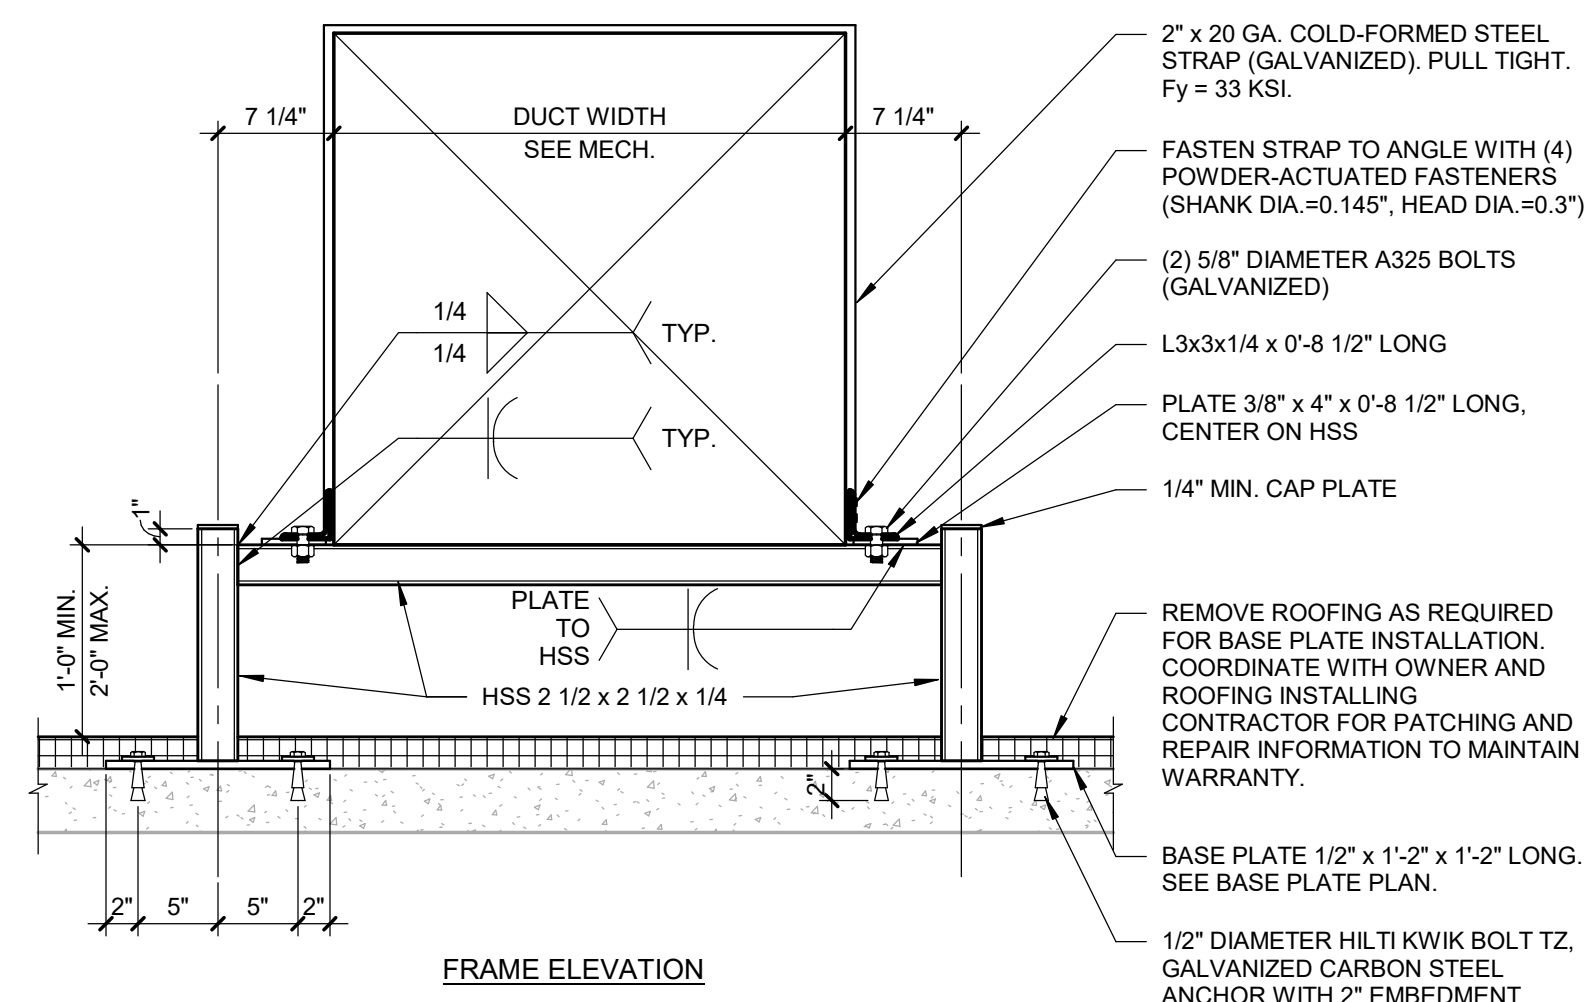

FRAME ELEVATION


7 ROOFTOP DUCTWORK SUPPORT DETAIL

- NOTES:
1. ALL STEEL HOT DIPPED GALVANIZED.
 2. EXPOSED HOLES IN MEMBERS ADDED FOR VENTING DURING GALVANIZING SHALL BE SEALED TIGHT WITH A NON-CORROSIVE AND DURABLE MATERIAL.
 3. HSS SHAPES TO BE ASTM A500 GR B, Fy = 46.0 KSI.
 4. PLATES AND ANGLES TO BE ASTM A36, Fy = 36 KSI.
 5. FIELD LOCATE EXISTING REINFORCING BARS IN CONCRETE SLAB AND AVOID DAMAGING WHEN INSTALLING ANCHORS. COORDINATE REINFORCING BAR LOCATIONS WITH STEEL DETAILER TO ADJUST HOLES IN BASE PLATES AS REQUIRED. MAINTAIN A MINIMUM EDGE DISTANCE OF 1 1/2" ON BOLT HOLES. BASE PLATE SIZE MAY BE INCREASED UP TO 2" TO ACCOMMODATE DESIRED BOLT HOLE LOCATION. DO NOT MAKE PLATE SMALLER THAN SHOWN.
 6. ALL WELDING TO SATISFY AWS REQUIREMENTS.
 7. ABSENT WELD SIZE IN WELD SYMBOL MEANS USE MINIMUM SIZE BASED ON CONNECTED PARTS PER AWS REQUIREMENTS.
 8. ABSENT WELD LENGTH IN WELD SYMBOL MEANS WELD FULL LENGTH OF JOINT.

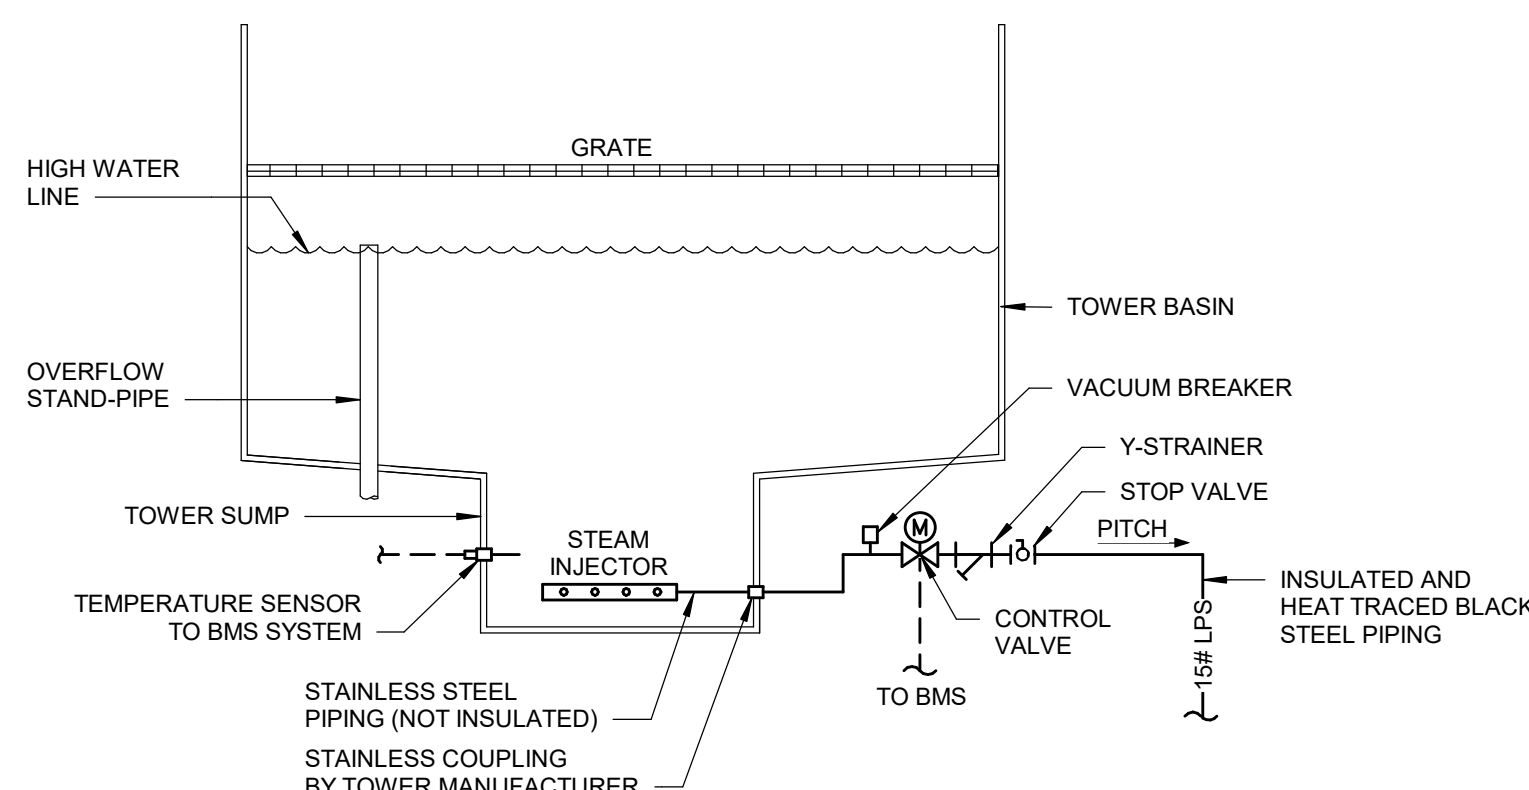

8 COOLING TOWER STEAM BASIN HEATER DETAIL
NO SCALE

NOTES:
1. TOWER BASIN HEATER SHALL MAINTAIN MINIMUM 40°F WATER TEMPERATURE (ADJUSTABLE).

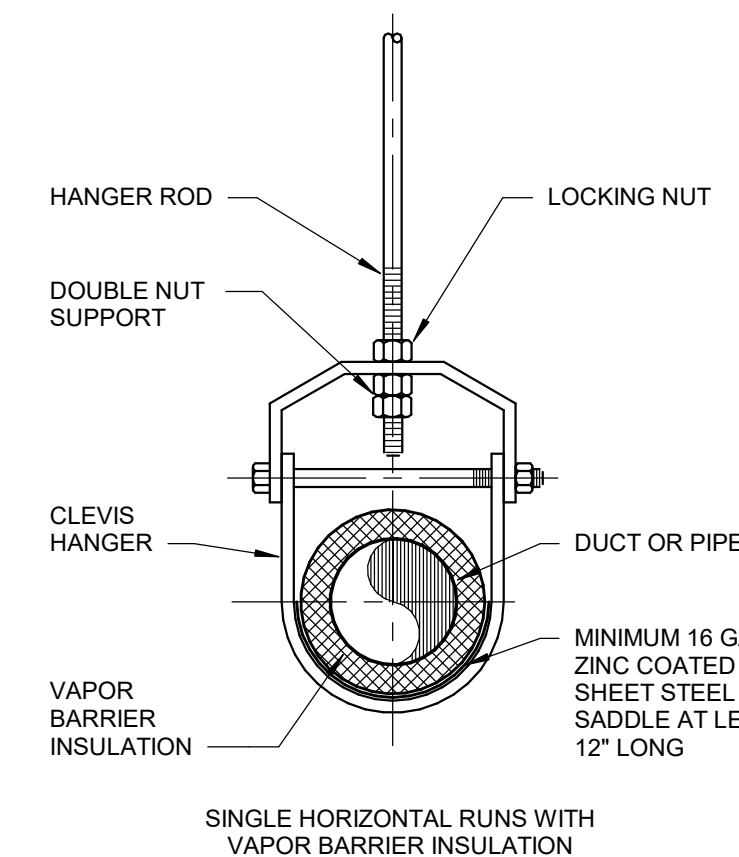

9 TYPICAL CLEVIS HANGER
NO SCALE


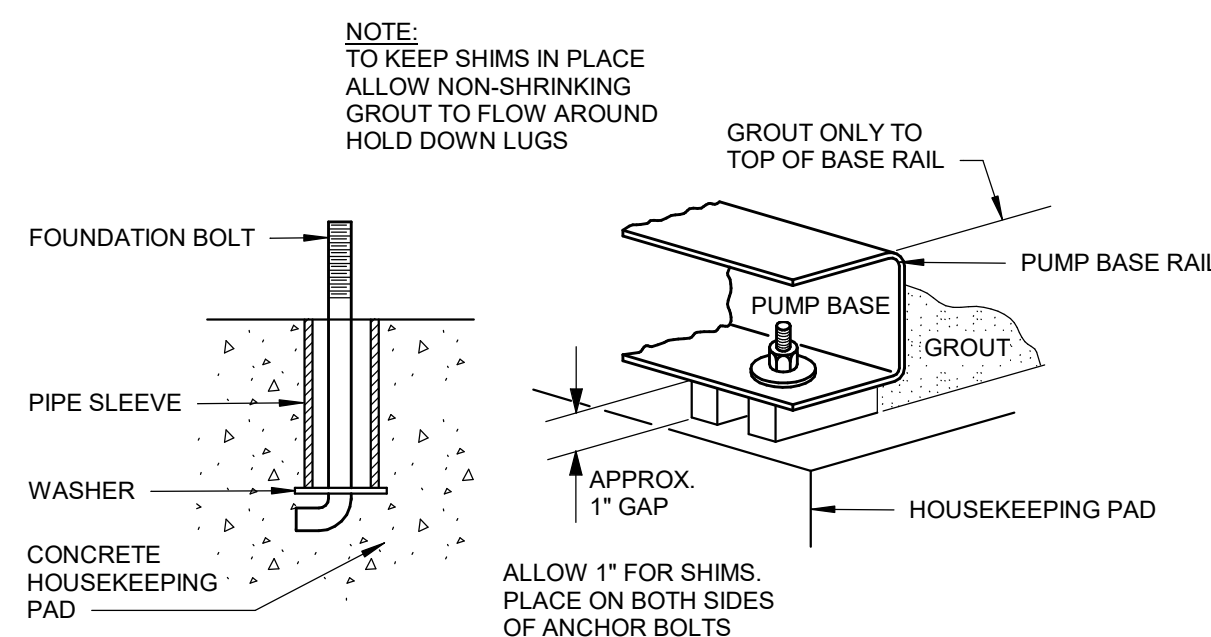


FIGURE 1

FIGURE 2

- INSTALLATION NOTES
1. INSTALL FOUNDATION BOLTS IN NEW CONCRETE HOUSEKEEPING PAD (SEE FIGURE 1).
 2. PLACE PUMP ON HOUSEKEEPING PAD SUPPORTING IT WITH SHIMS TOTALING 1" IN THICKNESS. SHIMS SHOULD BE PUT ON BOTH SIDES OF EACH ANCHOR BOLT AS A MEANS OF LEVELING THE BASE (SEE FIGURE 2).
 3. AFTER PUMP HAS BEEN LEVELLED, SECURELY BOLTED TO FLOOR AND PROPERLY ALIGN PER SPECIFICATION, NON-SHRINKING GROUT IS TO BE POURED INTO PUMP BASE. TO HOLD SHIMS IN PLACE ALLOW THE GROUT TO FLOW AROUND THEM (SEE FIGURE 2).

10 PUMP BASE INSTALLATION DETAIL
NO SCALE

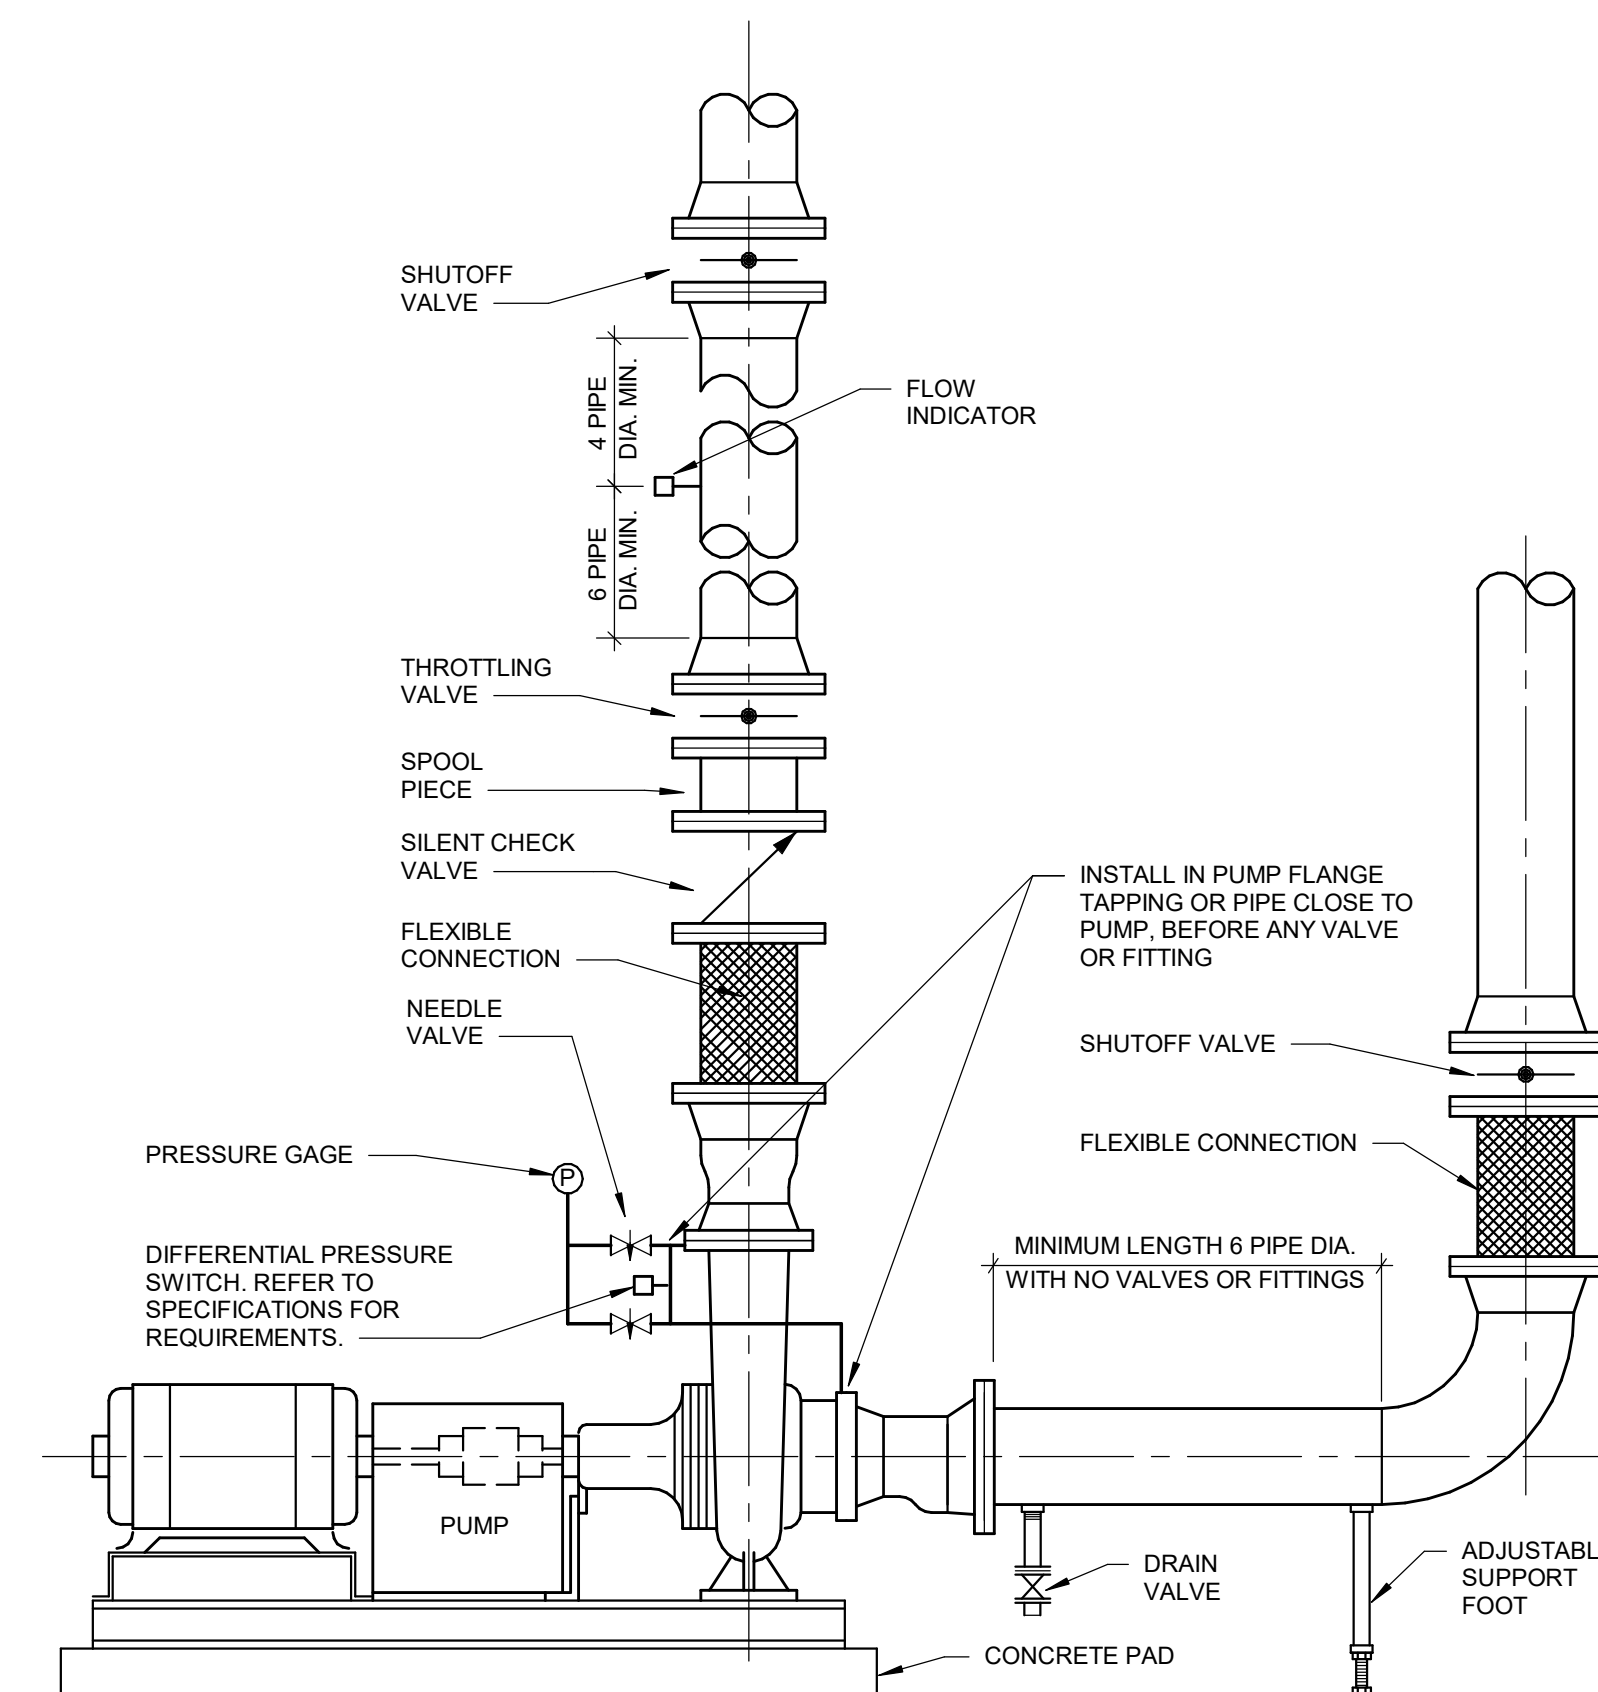

- NOTES
1. FOR PIPE SIZES 2" AND SMALLER, CIRCUIT SETTER MAY BE USED IN LIEU OF FLOW INDICATOR AND THROTTLING VALVE.
 2. FLOW INDICATOR MAY BE ON RETURN SIDE, SEE SYSTEM SCHEMATIC.

11 BASE MOUNTED PUMP WITHOUT SUCTION DIFFUSER
NO SCALE



WAYNE STATE
UNIVERSITY

fic&h

engineers
scientists
architects
constructors

fishbeck, thompson, carr & huber, inc.
www.fic&h.com

Wayne State University

5201 Cass Ave, Detroit, MI 48202

Prentis Building Computer Lab Relocation
WSU Project: 022-313456

REVISIONS		
8/23/2018	A3	ADDENDUM NO. 3

8/13/2018	BIDS
Drawn By	sku
Designer	sku
Reviewer	PMS
Manager	MM








Hard copy is intended to be 24"x36" when plotted. Scale(s) indicated and graphic quality may not be accurate for any other size.

PROJECT NO.
180746

MECHANICAL DETAILS



M501

©Copyright 2018
All Rights Reserved

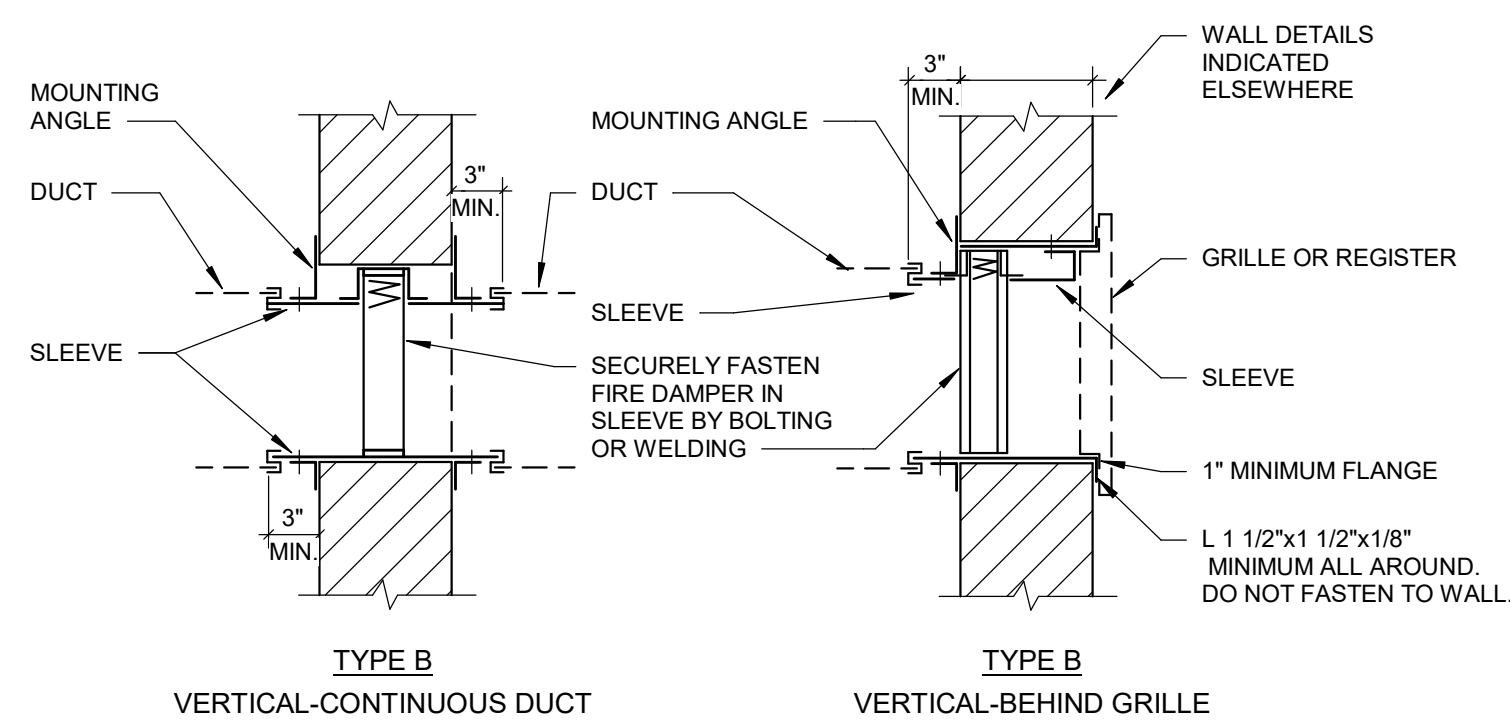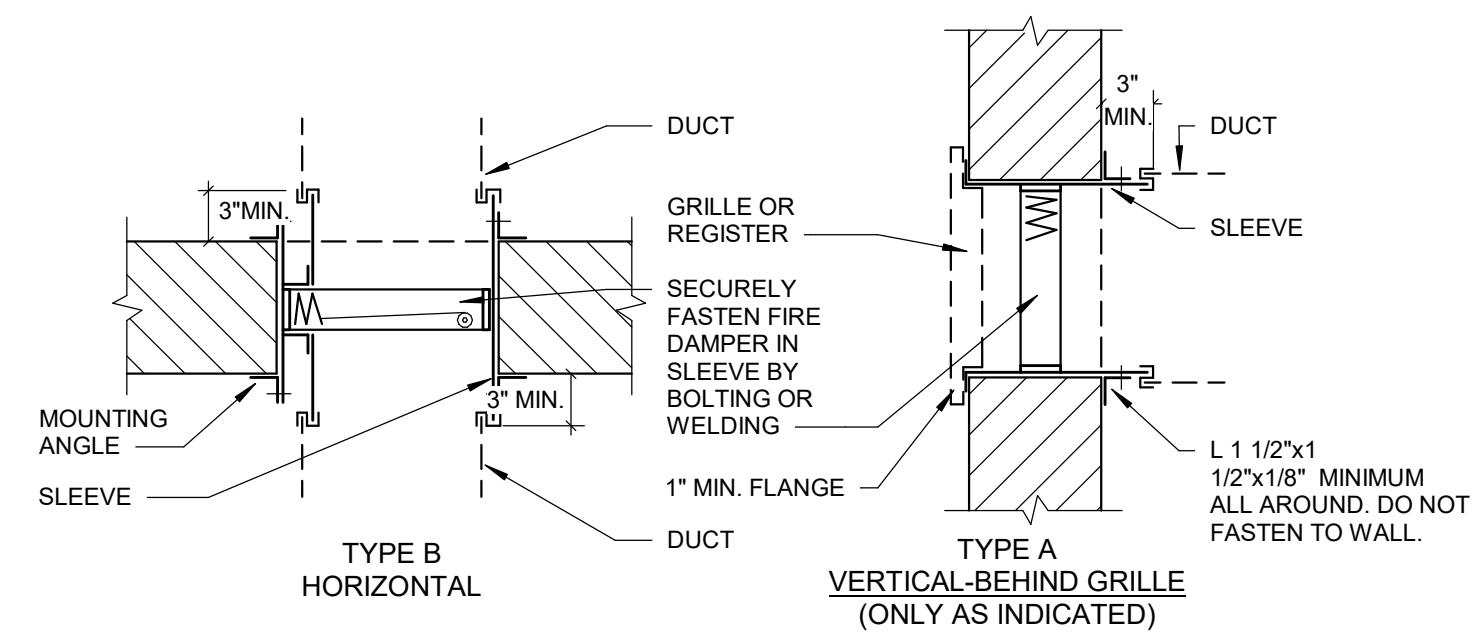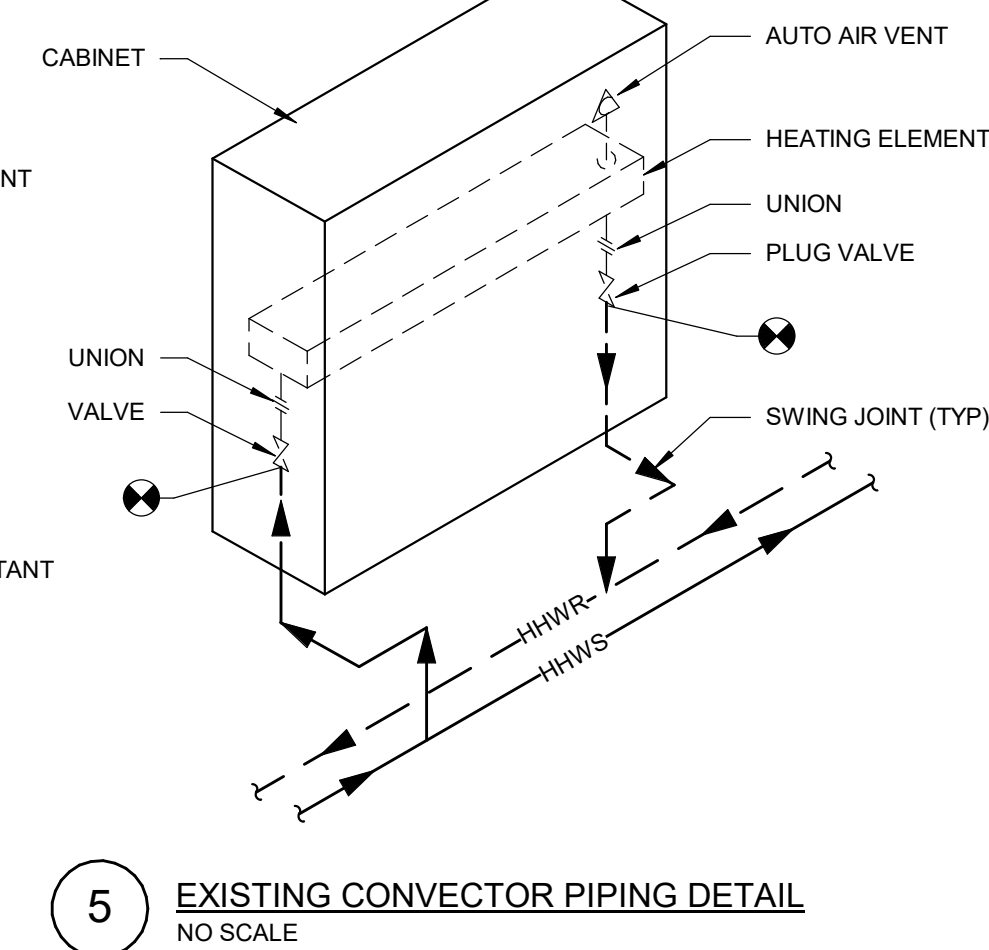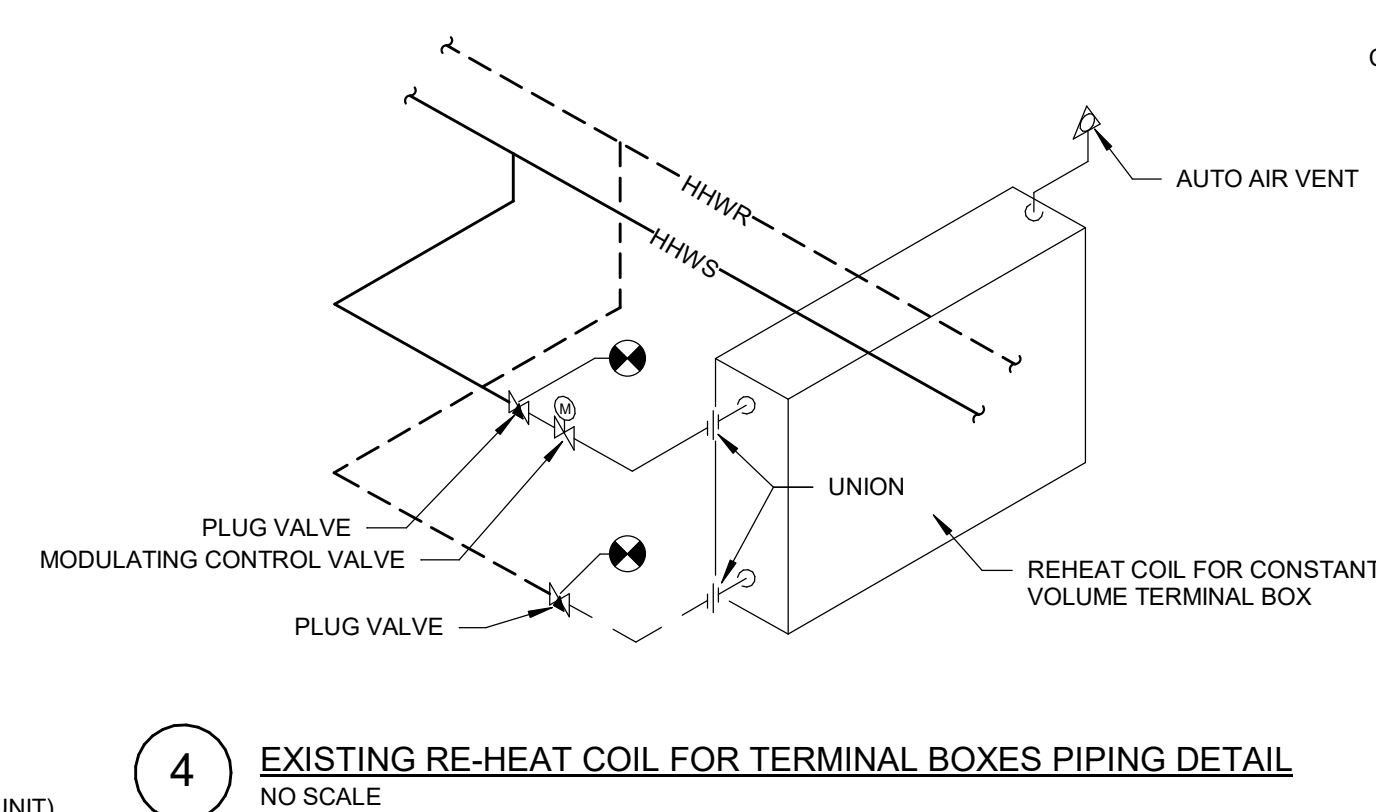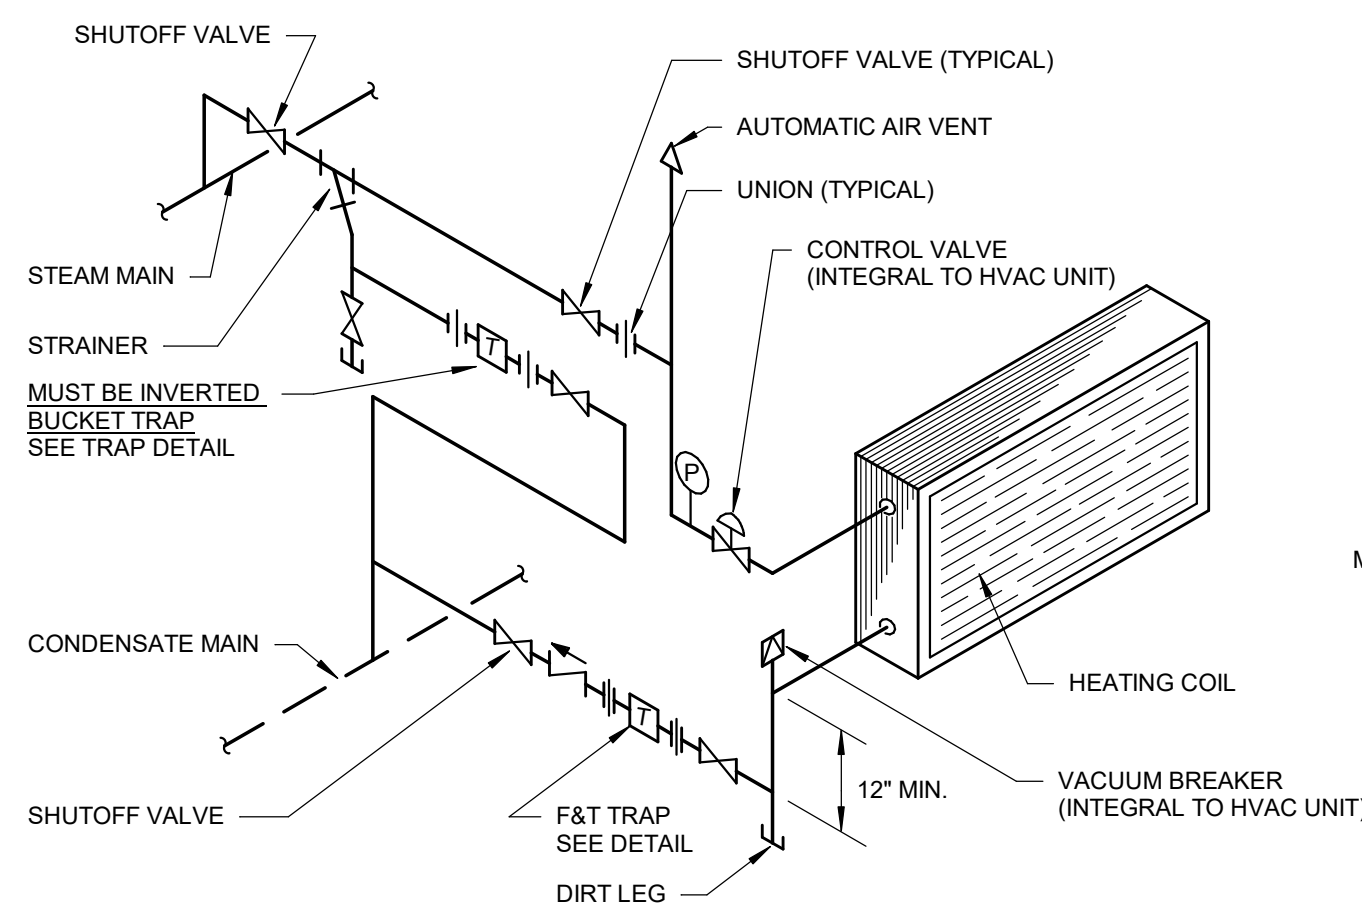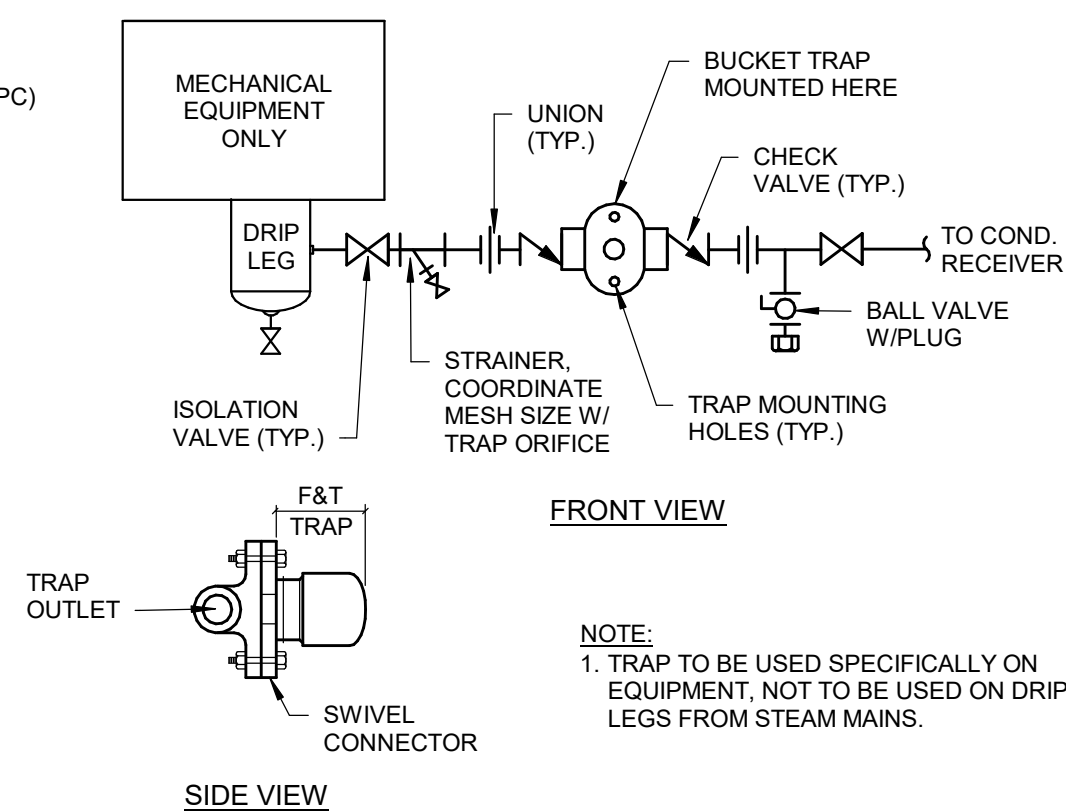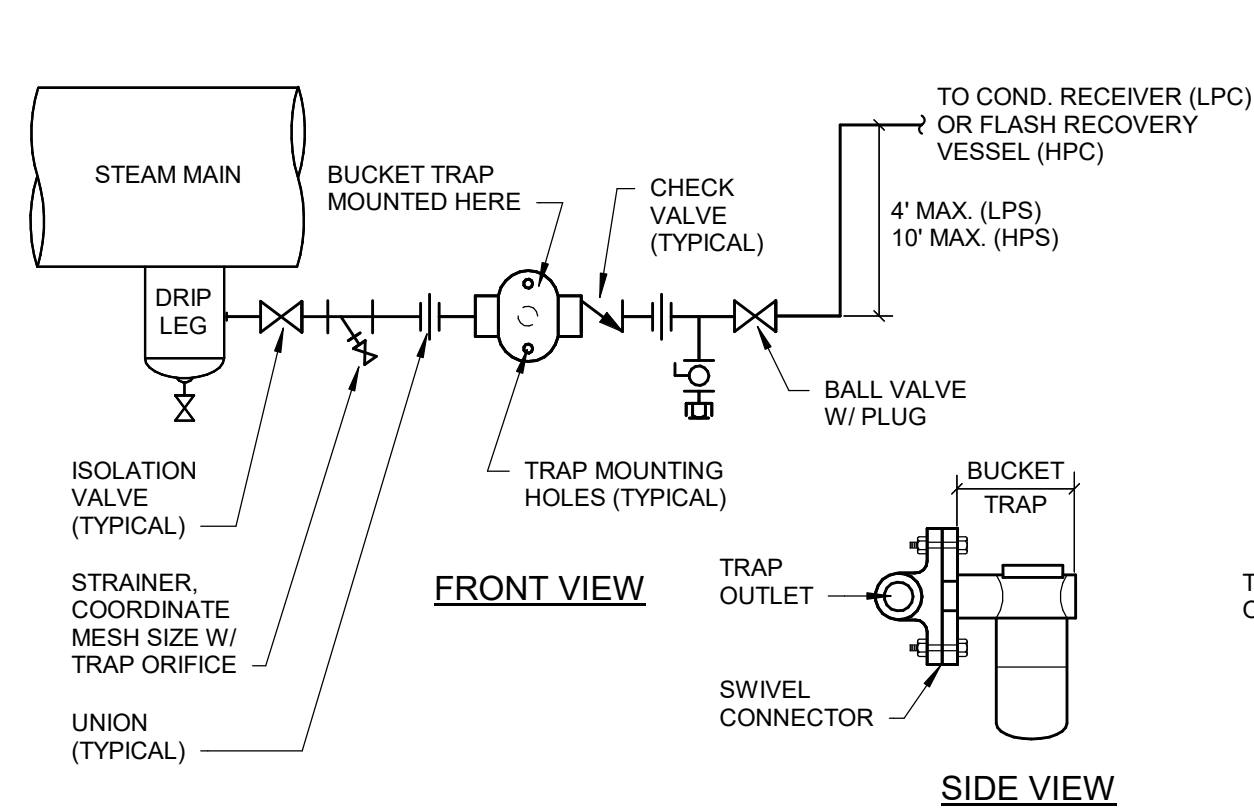


NOTES

1. USE TYPE B UNLESS NOTED OTHERWISE.
2. OPENINGS ARE TO BE 1/8" PER FOOT OF DAMPER SIZE LARGER THAN DAMPER IN BOTH DIRECTIONS; MINIMUM OF 1/4".
3. SLEEVES ARE TO BE OF GALVANIZED STEEL, GAGE AS REQUIRED BY SMACNA STANDARD OR LOCAL FIRE OFFICIAL, WHICHEVER REQUIREMENT IS MORE STRINGENT.

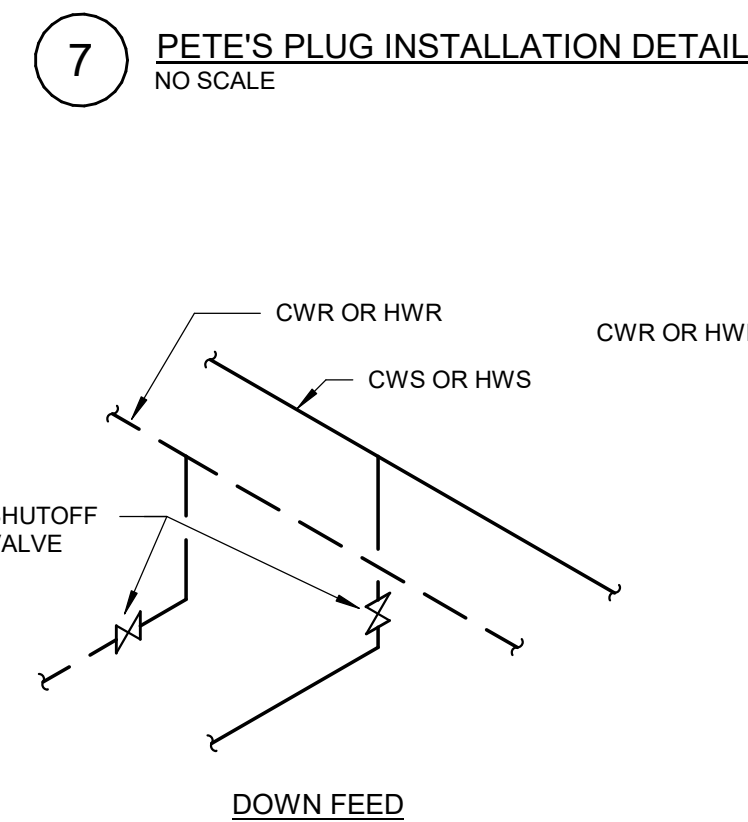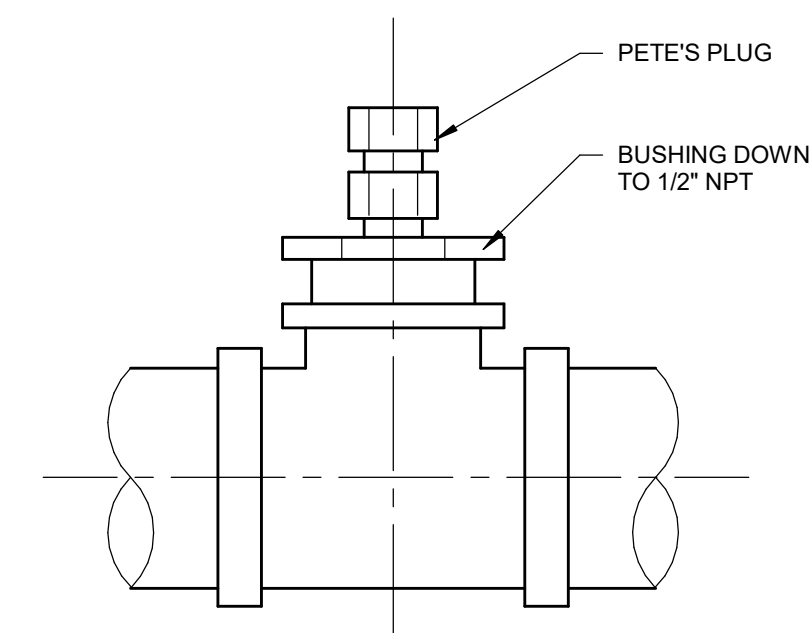



NOTES

1. MAKE ALL TAKE OFFS WITH SWING JOINTS.
2. DOWN FEED TO BE USED UNLESS INDICATED OTHERWISE.

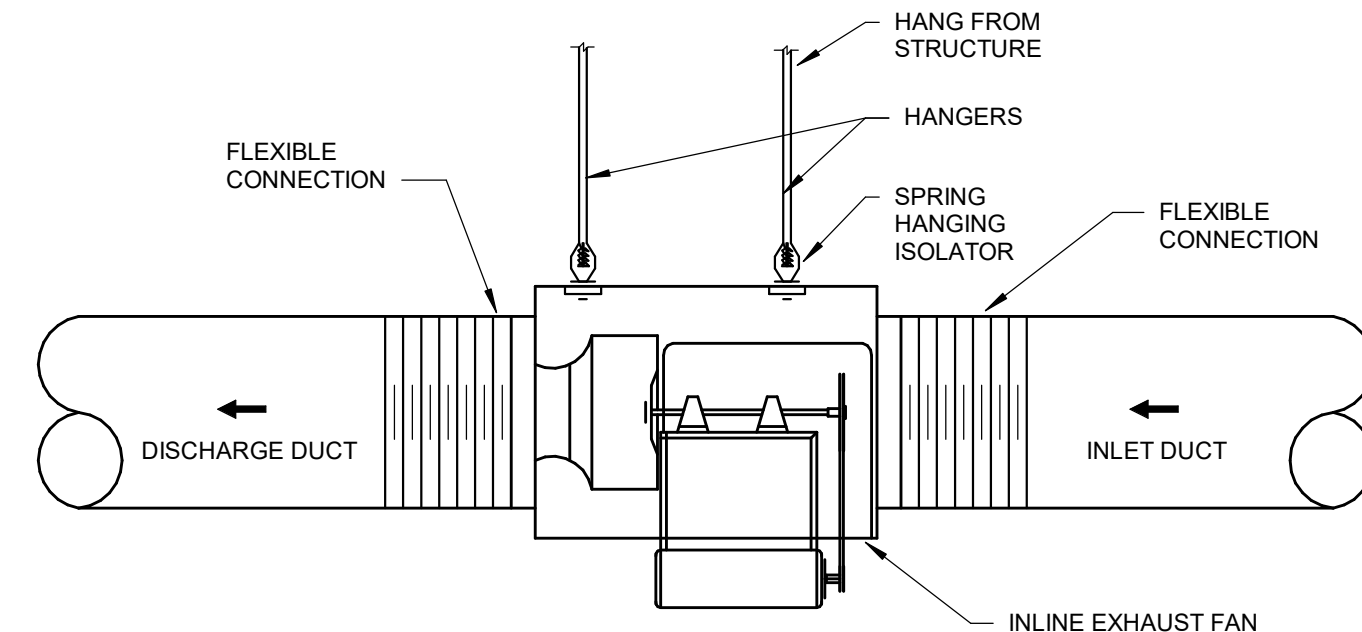

NOTES

NO SCALE

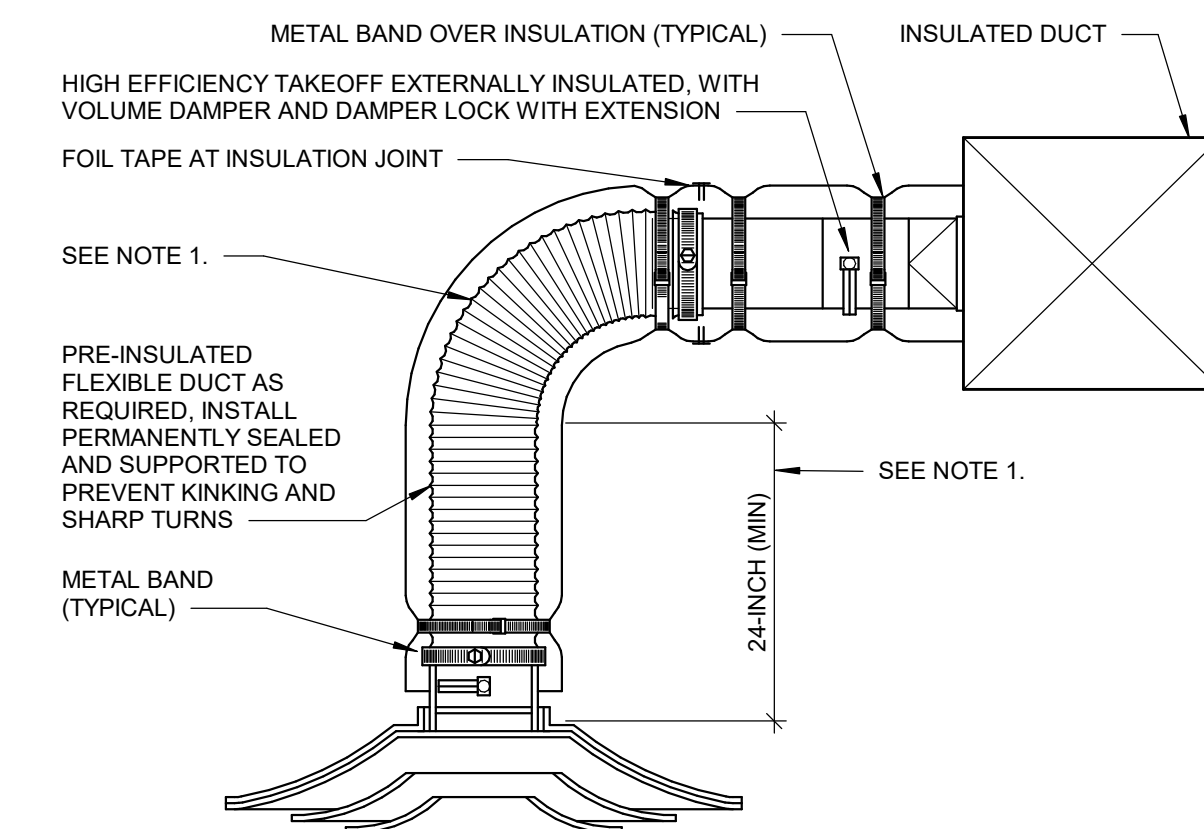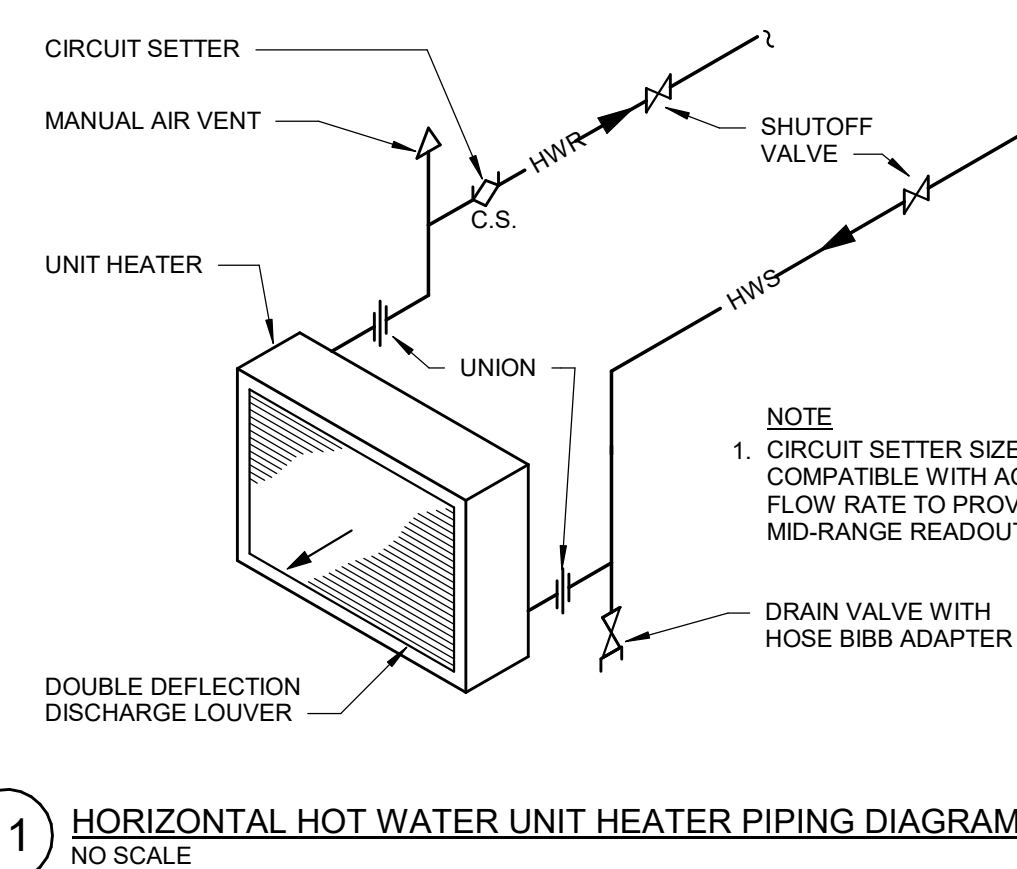

NOTES

1. EXTEND RIGID METAL DUCT SO THAT MAXIMUM FLEXIBLE DUCT LENGTH DOES NOT EXCEED 5'-0". PROVIDE RIGID 90° ELBOW WHERE REQUIRED TO KEEP FLEXIBLE DUCT WITHIN 5'-0" LENGTH LIMITATION.

NOTES

NO SCALE

WAYNE STATE
UNIVERSITY

fitch

engineers
scientists
architects
constructorsfishbeck, thompson, carr & huber, inc.
www.fitch.com

Wayne State University

5201 Cass Ave, Detroit, MI 48202

Prentis Building Computer Lab Relocation

WSU Project: 022-313456

REVISIONS

8/23/2018 A3 ADDENDUM NO. 3

8/13/2018 BIDS

Drawn By sku

Designer sku

Reviewer PMO

Manager MMS

Hard copy is intended to be 24"x36" when plotted. Scale(s) indicated and graphic quality may not be accurate for any other size.


PROJECT NO.

180746

MECHANICAL DETAILS

M502

©Copyright 2018
All Rights Reserved

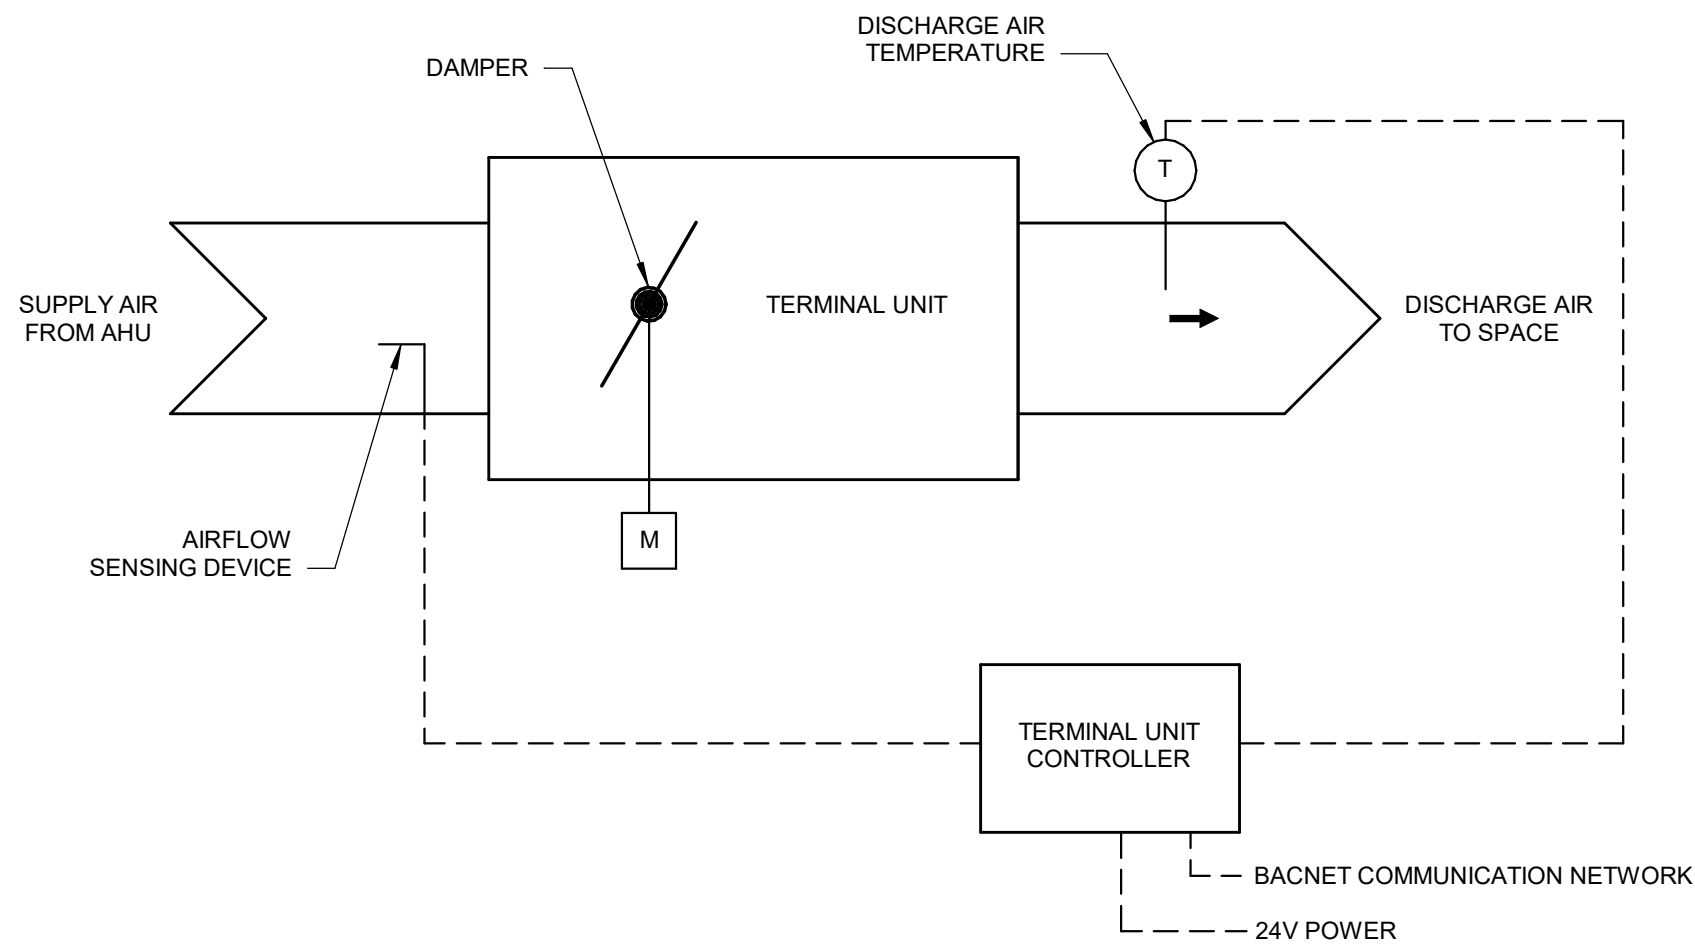

VARIABLE AIR VOLUME TERMINAL BOX CONTROL DIAGRAM
NO SCALE
(FOR NEW VAV TERMINAL UNITS ONLY)

GENERAL

- TEMPERATURE SETPOINTS SHALL BE ADJUSTABLE TO A RANGE SPECIFIED THROUGH THE FRONT END WITH LOCAL ADJUSTMENT ON ROOM SENSOR. TYPICAL SETPOINT ADJUSTMENT RANGES: +/- 2°F.

OPERATIONAL MODES

OCCUPIED:

- THE ROOM CONTROL SYSTEM WITH INPUT FROM A SPACE SENSOR SHALL MODULATE THE VAV SUPPLY DAMPER TO MAINTAIN THE DESIRED SPACE TEMPERATURE.
- UPON A RISE IN SPACE TEMPERATURE ABOVE SETPOINT THE SUPPLY DAMPER WILL MODULATE TOWARD THE MAXIMUM COOLING AIRFLOW SETPOINT.
- WHEN SPACE TEMPERATURE IS WITHIN ITS DEADBAND RANGE, THE SUPPLY DAMPER SHALL MAINTAIN THE CURRENT AIRFLOW SETPOINT.
- UPON A DROP IN SPACE TEMPERATURE BELOW SETPOINT, THE SUPPLY DAMPER WILL MODULATE TOWARD THE MINIMUM AIRFLOW SETPOINT.
- OCCUPIED COOLING SETPOINT SHALL BE 76°F (ADJUSTABLE).


UNOCCUPIED:

- THE ROOM CONTROL SYSTEM SHALL MODULATE THE VAV SUPPLY DAMPER TO THE MINIMUM AIRFLOW SETPOINT.
- COOLING SETPOINT SHALL BE DISABLED.

NOTES:

- A. THE TERMINAL BOX CONTROLLER, DAMPER ACTUATOR AND AIR FLOW PROBE ARE PROVIDED BY THE TEMPERATURE CONTROL CONTRACTOR. THESE DEVICES SHALL BE SHIPPED TO THE MANUFACTURER. ALL OTHER FIELD MOUNTED CONTROL DEVICES ARE FURNISHED, MOUNTED AND WIRED BY THE TEMPERATURE CONTROL CONTRACTOR.

TEMPERATURE SETPOINT SCHEDULE		
OCCUPANCY STATE	HEATING	COOLING
OCCUPIED	N/A	76
UNOCCUPIED	N/A	N/A

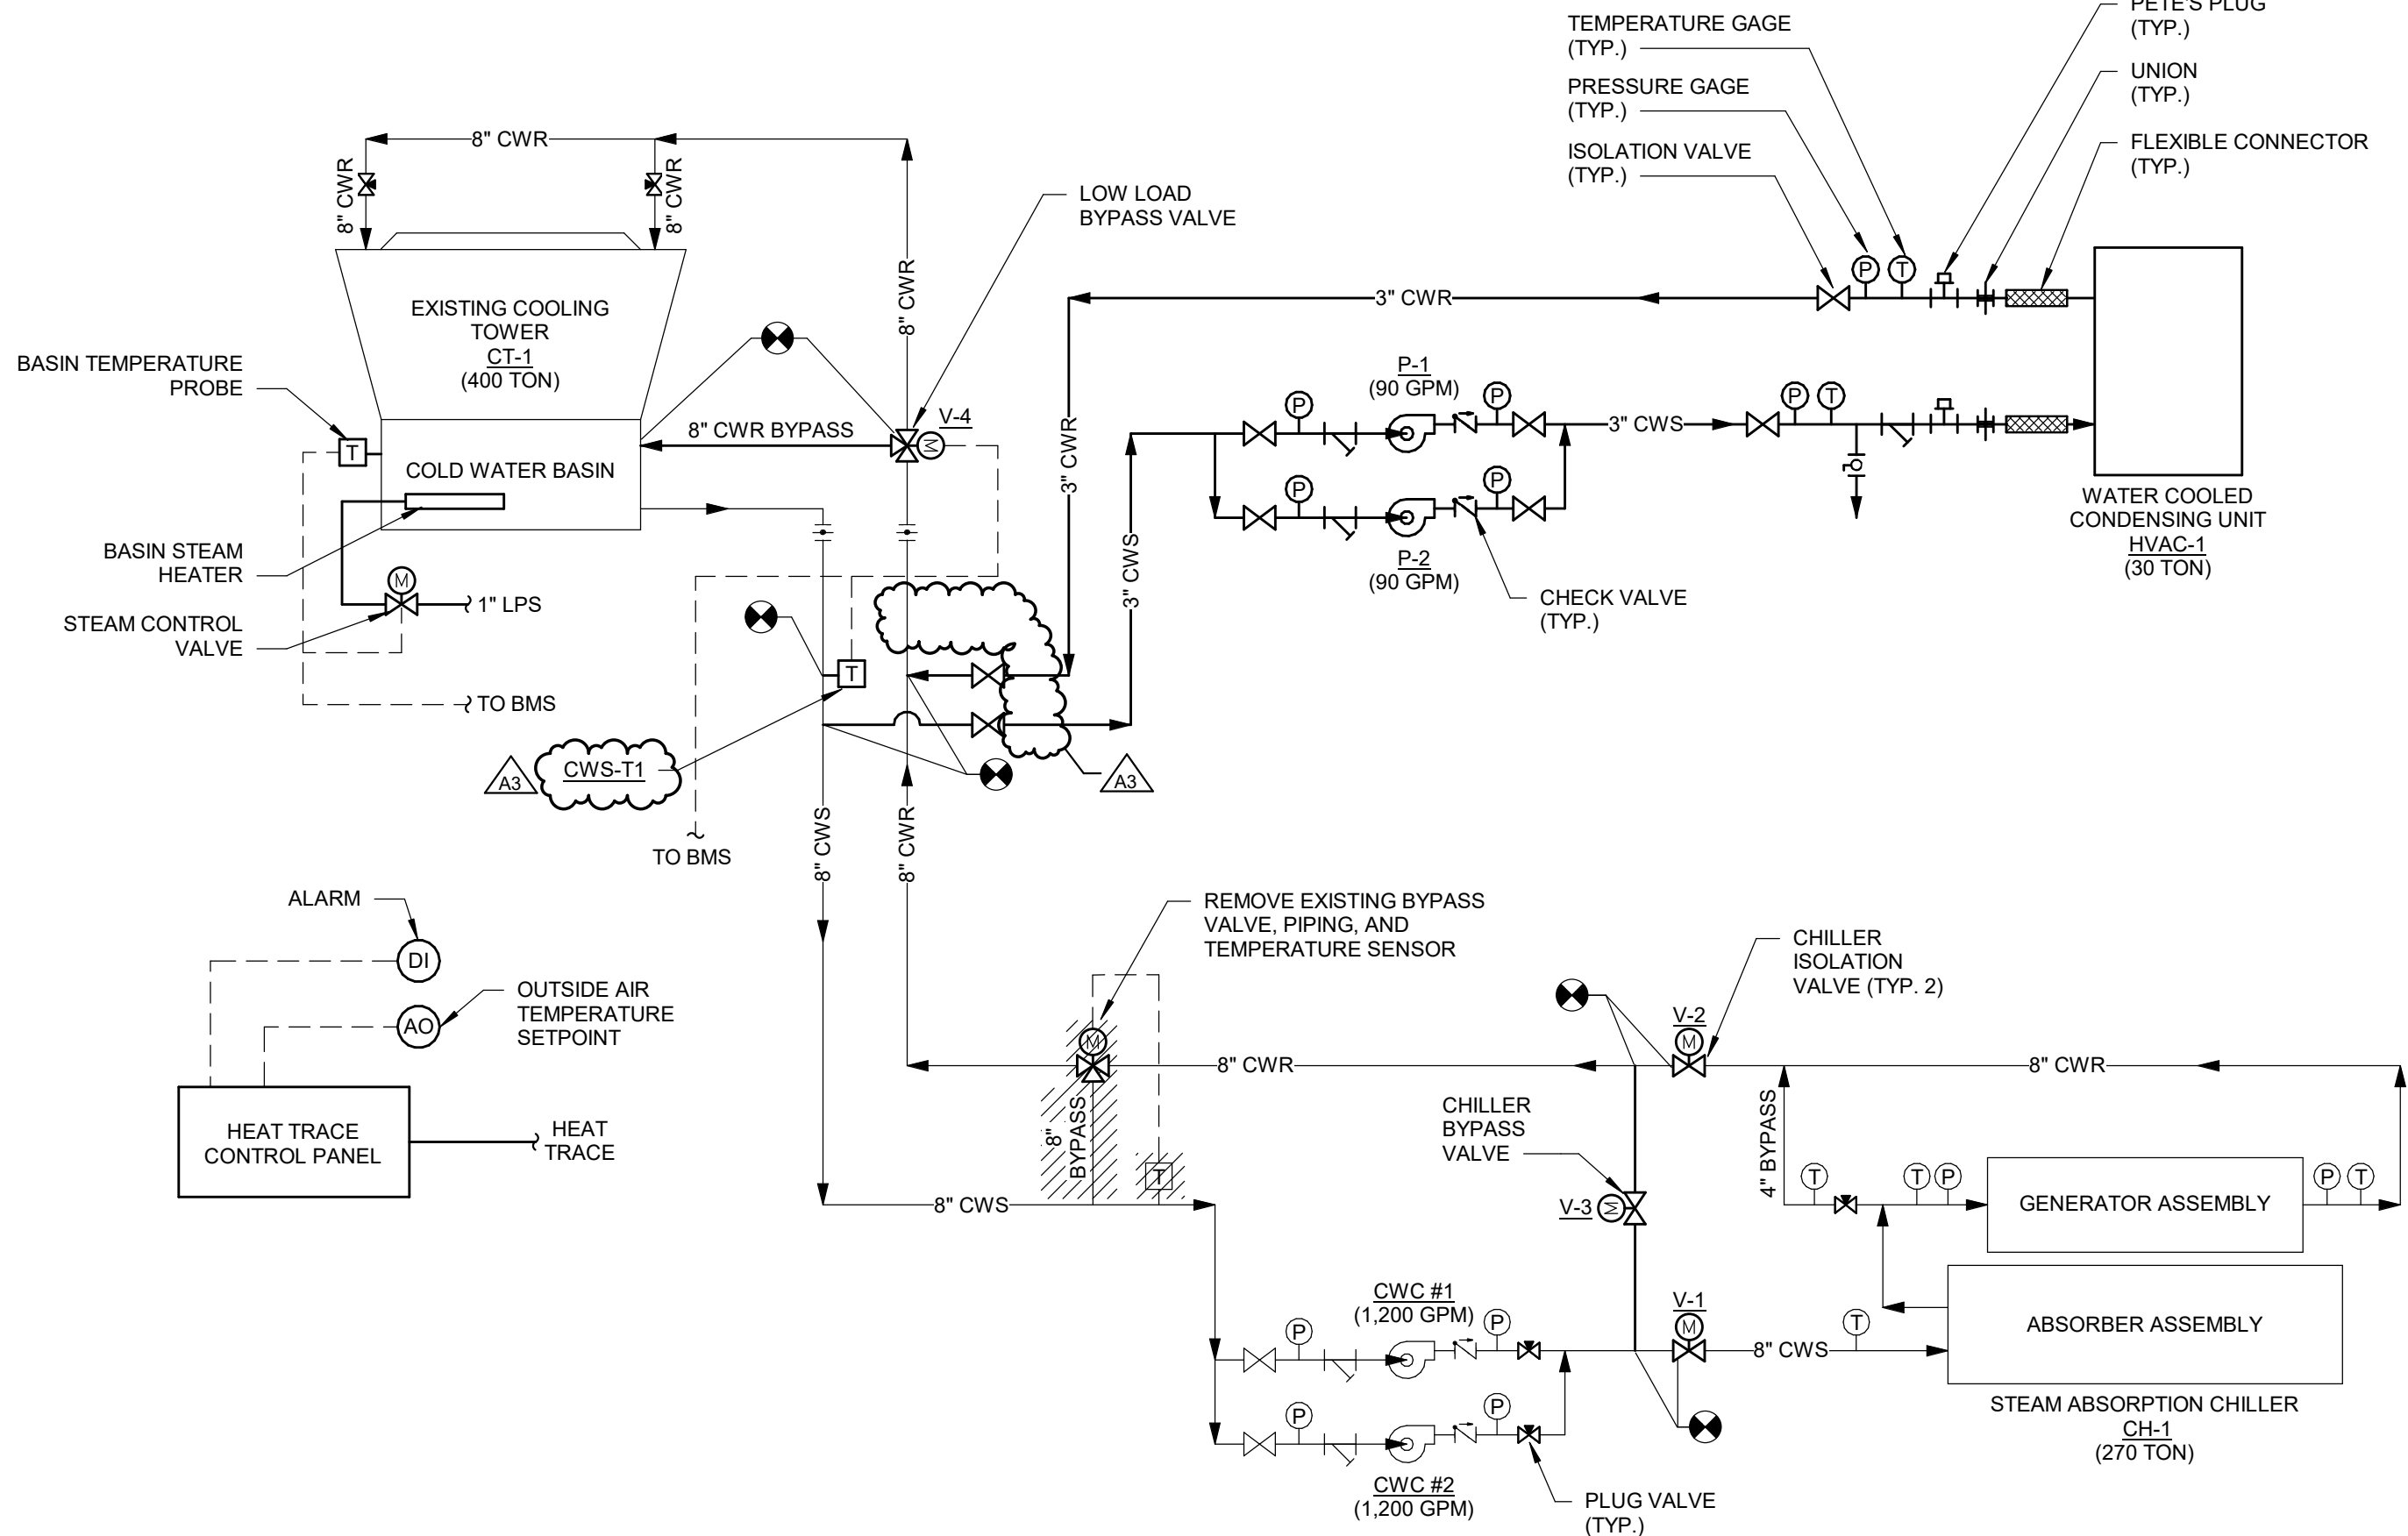

COOLING TOWER & CONDENSING WATER FLOW DIAGRAM

NO SCALE

NOTES:

- ALL EXISTING AND NEW EXTERIOR CONDENSING WATER PIPING (CWS & CWR) SHALL BE HEAT TRACED AND INSULATED.
- ALL EXTERIOR STEAM PIPING SHALL BE HEAT TRACED AND INSULATED. ALL INTERIOR STEAM PIPING SHALL BE INSULATED.

UPDATED CONDENSING WATER SYSTEM SEQUENCE OF OPERATION:

SUMMER MODE:

- CHILLER (CH-1) AND COOLING TOWER (CT-1) SHALL BE ENABLED.
- THE LOW LOAD BYPASS VALVE (V-4) SHALL DIRECT ALL FLOW THROUGH THE COOLING TOWER FILL MEDIA.

CHILLER OPERATING:

- UPON CALL FOR ACTIVATION OF CHILLER (CH-1), THE CHILLER ISOLATION VALVES (V-1 & V-2) SHALL FULLY OPEN, AND BYPASS VALVE (V-3) SHALL FULLY CLOSE TO DIRECT FLOW THROUGH THE CHILLER. WHEN VALVES ARE PROVEN OPEN BY END SWITCH, THE ASSOCIATED CONDENSING WATER PUMPS (CWC #1 & CWC #2) SHALL ENERGIZE.
- UPON CONDENSING WATER SUPPLY (CWS) TEMPERATURE INCREASING ABOVE THE SETPOINT OF 85F (ADJ.), THE COOLING TOWER BYPASS VALVE SHALL OPEN TO DIRECT CONDENSING WATER TO THE COOLING TOWER MEDIA.
- THE COOLING TOWER FAN SHALL ENERGIZE AND THE SPEED SHALL BE MODULATED TO MAINTAIN THE CWS SETPOINT OF 85F (ADJ.).
- UPON CALL FOR DEACTIVATION OF CHILLER (CH-1):
 - THE CONDENSING WATER PUMPS (CWC #1 & CWC #2) AND COOLING TOWER FAN SHALL REMAIN ACTIVE FOR 3 MINUTES (ADJ.) AFTER CHILLER CYCLES OFF.
 - AFTER THE TIME DELAY, THE CONDENSING WATER PUMPS AND COOLING TOWER FAN SHALL DE-ENERGIZE. CHILLER ISOLATION VALVES (V-1, V-2) SHALL CLOSE AND BYPASS VALVE (V-3) SHALL OPEN TO BYPASS THE CHILLER. THE COOLING TOWER BYPASS VALVE (V-4) SHALL CLOSE TO DIRECT ALL FLOW THROUGH BYPASS.

CHILLER & HVAC-1 OPERATING:

- UPON CALL FOR THE ACTIVATION OF HEATING VENTILATING AND AIR CONDITIONING UNIT (HVAC-1), THE ASSOCIATED CONDENSING WATER PUMPS (P-1 & P-2) SHALL ENERGIZE (PRIMARY/STANDBY).
 - THE LOW LOAD BYPASS VALVE SHALL MODULATE TO DIRECT ALL FLOW TO THE COOLING TOWER COLD WATER BASIN IF CHILLER (CH-1) IS NOT OPERATING. IF CHILLER IS OPERATING, THE BYPASS VALVE SHALL DIRECT ALL FLOW TO THE COOLING TOWER MEDIA.
- UPON CALL FOR ACTIVATION OF CHILLER (CH-1), THE CHILLER ISOLATION VALVES (V-1 & V-2) SHALL FULLY OPEN, AND BYPASS VALVE (V-3) SHALL FULLY CLOSE TO DIRECT FLOW THROUGH THE CHILLER. WHEN VALVES ARE PROVEN OPEN BY END SWITCH, THE ASSOCIATED CONDENSING WATER PUMPS (CWC #1 & CWC #2) SHALL ENERGIZE.
 - THE LOW LOAD BYPASS VALVE (V-4) SHALL CLOSE TO DIRECT ALL FLOW TO THE COOLING TOWER FILL MEDIA.
- UPON CALL FOR DEACTIVATION OF CHILLER (CH-1):
 - THE CONDENSING WATER PUMPS (CWC #1 & CWC #2) AND COOLING TOWER FAN SHALL REMAIN ACTIVE FOR 3 MINUTES (ADJ.) AFTER CHILLER CYCLES OFF.
 - AFTER THE TIME DELAY, THE CONDENSING WATER PUMPS AND COOLING TOWER FAN SHALL DE-ENERGIZE. CHILLER ISOLATION VALVES (V-1, V-2) SHALL CLOSE AND BYPASS VALVE (V-3) SHALL OPEN TO BYPASS THE CHILLER. THE COOLING TOWER BYPASS VALVE (V-4) SHALL CLOSE TO DIRECT ALL FLOW THROUGH BYPASS.
- IF CHILLER (CH-1) IS NOT OPERATING AND CONDENSING WATER SUPPLY (CWS) TEMPERATURE INCREASES ABOVE THE SETPOINT OF 85F FOR 15 MINUTES (ADJ.), AS MEASURED BY THE TEMPERATURE SENSOR (CWS-T1), THE CONDENSING WATER PUMPS (CWC #1 & CWC #2) SHALL ENERGIZE.
 - THE LOW LOAD BYPASS VALVE (V-4) SHALL CYCLE TO DIRECT ALL FLOW TO THE COOLING TOWER FILL MEDIA.
- IF AFTER THE FULL FLOW OF WATER IS DIRECTED TO THE TOWER MEDIA, AND THE CWS TEMPERATURE IS STILL ABOVE ITS SETPOINT, THE COOLING TOWER FAN SHALL ENERGIZE AND THE SPEED SHALL BE MODULATED TO MAINTAIN THE CWS SETPOINT OF 85F (ADJ.).
- UPON CWS TEMPERATURE FALLING BELOW THE SETPOINT OF 85F (ADJ.) THE COOLING TOWER FAN SHALL MODULATE DOWN TO FULL STOP. IF THE CWS TEMPERATURE CONTINUES TO DROP, THE LOW LOAD BYPASS VALVE SHALL OPEN TO DIRECT FLOW TO THE TOWER BASIN. IF AFTER 15 MINUTES OF FULL BYPASS THE CWS TEMPERATURE IS STILL BELOW 85F (ADJ.), THE CONDENSING WATER PUMPS (CWC #1 & CWC #2) SHALL SHUT OFF.

WINTER MODE:

- CHILLER (CH-1) SHALL BE DISABLED AND COOLING TOWER (CT-1) SHALL BE ENABLED.
- THE LOW LOAD BYPASS VALVE (V-4) SHALL MODULATE BASED ON TEMPERATURE CONDITIONS.

HVAC-1 OPERATING & CHILLER DISABLED:

- UPON CALL FOR THE ACTIVATION OF HEATING VENTILATING AND AIR CONDITIONING UNIT (HVAC-1), THE ASSOCIATED CONDENSING WATER PUMPS (P-1 & P-2) SHALL ENERGIZE (PRIMARY/STANDBY).
 - THE LOW LOAD BYPASS VALVE SHALL MODULATE TO DIRECT ALL FLOW TO THE COOLING TOWER COLD WATER BASIN.
- IF CONDENSING WATER SUPPLY (CWS) TEMPERATURE INCREASES ABOVE THE SETPOINT OF 85F FOR 5 MINUTES (ADJ.) THE CONDENSING WATER PUMPS (CWC #1 & CWC #2) SHALL ENERGIZE. THE CHILLER ISOLATION VALVES (V-1 & V-2) SHALL REMAIN FULLY CLOSED, AND BYPASS VALVE (V-3) SHALL REMAIN FULLY OPEN TO BYPASS THE CHILLER.
 - THE LOW LOAD BYPASS VALVE (V-4) SHALL CYCLE TO DIRECT FLOW TO THE COOLING TOWER FILL MEDIA.
- THE COOLING TOWER FAN SHALL REMAIN DE-ENERGIZED UNLESS AFTER 5 MINUTES (ADJ.) THE CWS TEMPERATURE REMAINS ABOVE THE SETPOINT OF 85F. AFTER THE TIME DELAY, THE COOLING TOWER FAN SHALL ENERGIZE AND THE SPEED MODULATED UNTIL THE CWS SETPOINT OF 85F (ADJ.) IS REACHED.
- UPON CWS TEMPERATURE FALLING BELOW THE SETPOINT OF 85F FOR 5 MINUTES (ADJ.) THE CONDENSING WATER PUMPS (CWC #1 & CWC #2) AND COOLING TOWER FAN SHALL DE-ENERGIZE. SEE PREVIOUS SUMMER MODE SEQUENCE FOR SAME SITUATION.
- ALARM: IF CONDENSING WATER SUPPLY (CWS) TEMPERATURE IS ABOVE THE SETPOINT FOR 15 MINUTES (ADJ.) AN ALARM SHALL BE SENT TO BMS.

STEAM BASIN HEATER:

- THE CONTROL SYSTEM SHALL MONITOR THE COOLING TOWER COLD WATER BASIN TEMPERATURE AND MODULATE THE STEAM CONTROL VALVE TO MAINTAIN THE BASIN WATER TEMPERATURE OF 45F (ADJ.).
- COOLING TOWER COLD WATER BASIN TEMPERATURE SHALL BE MONITORED AND SETPOINT ADJUSTABLE BY BMS.

ALARMS:

- IF CONDENSING WATER SUPPLY (CWS) TEMPERATURE IS ABOVE THE SETPOINT FOR 15 MINUTES (ADJ.) AN ALARM SHALL BE SENT TO BMS.
- IF COOLING TOWER BASIN TEMPERATURE FALLS BELOW THE SETPOINT OF 45F (ADJ.) AN ALARM SHALL BE SENT TO BMS.



WAYNE STATE
UNIVERSITY

ftc&h

engineers
scientists
architects
constructors

fishbeck, thompson, carr & huber, inc.
www.ftch.com

Wayne State University

5201 Cass Ave, Detroit, MI 48202

Prentis Building Computer Lab Relocation

WSU Project: 022-313456

REVISIONS

DATE	DESCRIPTION	BY
8/23/2018	A3 ADDENDUM NO. 3	

8/13/2018 BIDS

Drawn By sku

Designer sku

Reviewer PMO

Manager MMS

Hard copy is intended to be
24"x36" when plotted. Scale(s)
indicated and graphic quality may
not be accurate for any other size.

PROJECT NO.

180746

MECHANICAL CONTROLS
DIAGRAMS

M602

©Copyright 2018
All Rights Reserved

ELECTRICAL SYMBOL LEGEND

SYMBOL	DESCRIPTION
S	SINGLE POLE MANUAL LIGHTING SWITCH
S ₂	TWO POLE MANUAL LIGHTING SWITCH
S ₃	THREE-WAY MANUAL LIGHTING SWITCH
S ₄	FOUR-WAY MANUAL LIGHTING SWITCH
S ₀	MANUAL DIMMER LIGHTING SWITCH
S ₀ P	SINGLE POLE MANUAL LIGHTING SWITCH WITH PILOT LIGHT
S _T	MANUAL TIMER LIGHTING SWITCH
S _F	SINGLE POLE MANUAL FUSED SWITCH
S _M	SINGLE POLE MANUAL MOTOR STARTER
S ₀ MP	SINGLE POLE MANUAL MOTOR STARTER WITH PILOT LIGHT
S _L	SINGLE POLE LOW VOLTAGE SWITCH
S _{OC}	OCCUPANCY SENSOR WALL SWITCH
S _{OSD}	OCCUPANCY SENSOR DIMMER WALL SWITCH
Ⓢ	CEILING MOUNTED OCCUPANCY SENSOR
Ⓢ	WALL MOUNTED OCCUPANCY SENSOR
Ⓢ	POWER PACK FOR OCCUPANCY SENSOR
Ⓢ	RELAY PACK FOR OCCUPANCY SENSOR
Ⓢ	UL 924 EMERGENCY LIGHTING CONTROL UNIT
Ⓢ	CLG MTD DAYLIGHT HARVESTING PHOTO SENSOR
Ⓢ	SIMPLEX RECEPTACLE
Ⓢ	DUPLEX RECEPTACLE
Ⓢ	DUPLEX RECEPTACLE (ABOVE COUNTER)
Ⓢ	DOUBLE DUPLEX RECEPTACLE
Ⓢ	DOUBLE DUPLEX RECEPTACLE (ABOVE COUNTER)
Ⓢ	SPECIAL RECEPTACLE (AS NOTED)
Ⓢ	CEILING MOUNTED SIMPLEX RECEPTACLE
Ⓢ	CEILING MOUNTED DUPLEX RECEPTACLE
Ⓢ	CEILING MOUNTED DOUBLE DUPLEX RECEPTACLE
Ⓢ	CEILING MOUNTED SPECIAL RECEPTACLE
Ⓢ	SIMPLEX RECEPTACLE (CONTROLLED)
Ⓢ	DUPLEX RECEPTACLE (CONTROLLED)
Ⓢ	DUPLEX RECEPTACLE (CONTROLLED - ABOVE COUNTER)
Ⓢ	DOUBLE DUPLEX RECEPTACLE (CONTROLLED)
Ⓢ	DOUBLE DUPLEX RECEPT (CONTROLLED - ABOVE COUNTER)
Ⓢ	CEILING MOUNTED SIMPLEX RECEPTACLE (CONTROLLED)
Ⓢ	CEILING MOUNTED DUPLEX RECEPTACLE (CONTROLLED)
Ⓢ	CLG MTD DOUBLE DUPLEX RECEPTACLE (CONTROLLED)
Ⓢ	POWER AND DATA POKE-THRU FLOOR DEVICE
Ⓢ	POWER AND DATA FLOOR BOX
Ⓢ	VIDEO MONITOR POWER AND DATA WALL BOX
Ⓢ	CONTACTOR
Ⓢ	CEILING MOUNTED JUNCTION BOX
Ⓢ	WALL MOUNTED JUNCTION BOX
Ⓢ	FLOOR MOUNTED JUNCTION BOX
Ⓢ	PHOTOCELL
Ⓢ	PUSHBUTTON
Ⓢ	TIME CLOCK
Ⓢ	LOW VOLTAGE TRANSFORMER
Ⓢ	THERMOSTAT
Ⓢ	HUMIDISTAT
Ⓢ	SPECIAL CONNECTION (AS NOTED)
Ⓢ	PANELBOARD (480Y/277V) OR (480V)
Ⓢ	PANELBOARD (208Y/120V) OR (120/240V)
Ⓢ	SINGLE PHASE MOTOR CONNECTION
Ⓢ	THREE PHASE MOTOR CONNECTION
Ⓢ	NON FUSIBLE DISCONNECT SWITCH
Ⓢ	FUSIBLE DISCONNECT SWITCH (Z=No. POLES; X=SWITCH SIZE; Y=FUSE SIZE; MOUNT AT 5'-0" AFF, UNO)
Ⓢ	MOTOR STARTER N=STARTER SIZE; X=STARTER TYPE. (RV: REDUCED VOLTAGE; BLANK: FULL VOLTAGE); MOUNT AT 5'-0" AFF, UNO
Ⓢ	COMBINATION MOTOR STARTER / DISCONNECT SWITCH N=STARTER SIZE; X=STARTER TYPE. (RV: REDUCED VOLTAGE; BLANK: FULL VOLTAGE); MOUNT AT 5'-0" AFF, UNO
Ⓢ	GROUND ROD
Ⓢ	CONDUIT UNDER FLOOR
Ⓢ	CONDUIT ABOVE FLOOR
Ⓢ	SURFACE OR RECESSED LUMINAIRE
Ⓢ	SURFACE OR RECESSED DIRECTIONAL LUMINAIRE
Ⓢ	WALL MOUNTED LUMINAIRE
Ⓢ	TRACK MOUNTED LUMINAIRE
Ⓢ	EMERGENCY LUMINAIRE
Ⓢ	NIGHT LIGHT LUMINAIRE
Ⓢ	EMERGENCY NIGHT LIGHT LUMINAIRE
Ⓢ	BATTERY POWERED EMERGENCY LIGHTING UNIT
Ⓢ	CEILING MOUNTED EXIT SIGN
Ⓢ	WALL MOUNTED EXIT SIGN
Ⓢ	SITE LUMINAIRE AND POLE

FIRE ALARM SYMBOL LEGEND

SYMBOL	DESCRIPTION
Ⓢ	MAIN FIRE ALARM CONTROL PANEL
Ⓢ	FIRE ALARM REMOTE ANNUNCIATOR PANEL
Ⓢ	NOTIFICATION APPLIANCE CONTROL PANEL
Ⓢ	MANUAL PULL STATION
Ⓢ	HEAT DETECTOR; CEILING MOUNTED
Ⓢ	HEAT DETECTOR; WALL MOUNTED
Ⓢ	SMOKE DETECTOR; CEILING MOUNTED
Ⓢ	SMOKE DETECTOR; WALL MOUNTED
Ⓢ	ELEVATOR SMOKE DETECTOR
Ⓢ	DUCT-TYPE SMOKE DETECTOR
Ⓢ	BEAM-TYPE SMOKE DETECTOR; WALL MOUNTED
Ⓢ	REMOTE TEST STATION; CEILING MOUNTED
Ⓢ	REMOTE TEST STATION; WALL MOUNTED
Ⓢ	AUDIO DEVICE, CEILING MOUNTED
Ⓢ	AUDIO DEVICE; WALL MOUNTED
Ⓢ	VISUAL DEVICE; CEILING MOUNTED
Ⓢ	VISUAL DEVICE; WALL MOUNTED
Ⓢ	COMBINATION AUDIO/VISUAL DEVICE; CEILING MOUNTED
Ⓢ	COMBINATION AUDIO/VISUAL DEVICE; WALL MOUNTED
Ⓢ	SMOKE DAMPER
Ⓢ	FIRE PROTECTION SPRINKLER FLOW SWITCH
Ⓢ	FIRE PROTECTION SPRINKLER TAMPER SWITCH
Ⓢ	FIRE PROTECTION POST INDICATOR VALVE
Ⓢ	FIRE PROTECTION CO2 SYSTEM FLOW SWITCH
Ⓢ	FIRE FIGHTER'S PHONE OUTLET
Ⓢ	FIRE ALARM BELL
Ⓢ	MAGNETIC DOOR HOLDER
Ⓢ	FIRE ALARM INTERLOCK / CONTROL CONNECTION

SYSTEMS SYMBOL LEGEND

SYMBOL	DESCRIPTION
Ⓢ	VOICE / DATA OUTLET, SEE DETAIL ON E501
Ⓢ	OUTLET FOR WALL MOUNTED TELEPHONE
Ⓢ	DATA OUTLET; CEILING MOUNTED
Ⓢ	WIRELESS ACCESS POINT OUTLET; CEILING MOUNTED
Ⓢ	MICROPHONE OUTLET; WALL MOUNTED
Ⓢ	MICROPHONE OUTLET; CEILING MOUNTED
Ⓢ	POWER / DATA POLE
Ⓢ	POWER / DATA FLOOR BOX
Ⓢ	SPEAKER OUTLET; CEILING MOUNTED
Ⓢ	SPEAKER OUTLET; WALL MOUNTED
Ⓢ	VIDEO MONITOR OUTLET; WALL MOUNTED
Ⓢ	CLOCK OUTLET; WALL MOUNTED
Ⓢ	INTERCOM OUTLET; WALL MOUNTED
Ⓢ	VOLUME CONTROL OUTLET; WALL MOUNTED
Ⓢ	CABLE TRAY
Ⓢ	VERTICAL CONDUIT SLEEVE; THROUGH FLOOR
Ⓢ	HORIZONTAL CONDUIT SLEEVE; IN ACCESSIBLE CEILING SPACE

SECURITY SYMBOL LEGEND

SYMBOL	DESCRIPTION
Ⓢ	CAMERA OUTLET; CEILING OR PENDANT MOUNTED
Ⓢ	CAMERA OUTLET; WALL MOUNTED
Ⓢ	KEYPAD CONTROLLER OUTLET
Ⓢ	PROXIMITY CARD READER OUTLET
Ⓢ	PANIC BUTTON OUTLET
Ⓢ	MOTION DETECTOR OUTLET
Ⓢ	GLASS BREAK SENSOR OUTLET
Ⓢ	SECURITY SIREN OUTLET
Ⓢ	DOOR PROP ALARM OUTLET
Ⓢ	DOOR MAGNETIC CONTACTS
Ⓢ	ELECTRIC DOOR STRIKE
Ⓢ	ELECTRIC DOOR LATCH
Ⓢ	ELECTRIC POWER TRANSFER HINGE
Ⓢ	REQUEST-TO-EXIT DEVICE OUTLET

GENERAL ELECTRICAL ABBREVIATIONS

A, AMP	AMPERES	KW	KILOWATT
AC	ALTERNATING CURRENT	KVHR	KILOWATT-HOUR
ACP	ACOUSTICAL CEILING PANEL	LED	LIGHT-EMITTING DIODE
ADA	AMERICANS WITH DISABILITIES ACT	LS	LIGHT SWITCH OR LIMIT SWITCH
AFF	ABOVE FINISHED FLOOR	LT	LIGHT OR LEVEL TRANSDUCER
AHJ	AUTHORITY HAVING JURISDICTION	LTFCM	LIQUID-TIGHT FLEXIBLE METAL CONDUIT
AIC	AMPERE-INTERRUPTING CURRENT	LTG	LIGHTING
AL	ALUMINUM	LV	LOW VOLTAGE
ATM	AUTOMATIC TELLER MACHINE	M	METER
ATS	AUTOMATIC TRANSFER SWITCH	MANUF	MANUFACTURER
BMS	BUILDING MANAGEMENT SYSTEM	MCA	MINIMUM CIRCUIT AMPACITY
BRKR	BREAKER	MCB	MAIN CIRCUIT BREAKER
C	CONDUIT OR CELSIUS	MCC	MOTOR CONTROL CENTER
CB	CIRCUIT BREAKER	MCP	MOTOR CIRCUIT PROTECTOR
CATV	CABLE TELEVISION	MH	MANHOLE
CIP	CAST-IN-PLACE	MLO	MAIN LUGS ONLY
CJ	CONTROL JOINT	MT	MOUNT
CKT	CIRCUIT	MTD	MOUNTED
CLG	CEILING	MV	MEDIUM VOLTAGE
CM	CONSTRUCTION MANAGER	N, NEUT	NEUTRAL
CMU	CONCRETE MASONRY UNIT	NC	NORMALLY CLOSED
COAX	COAXIAL	NEC	NATIONAL ELECTRICAL CODE
CONC	CONCRETE	NEEA	NATIONAL ELECTRICAL MANUFACTURERS ASSOCIATION
CP	CONTROL PANEL	NL	NIGHT LIGHT
CT	CURRENT TRANSFORMER	NO	NORMALLY OPEN
CU	COPPER	NOM	NOMINAL
Cx	COMMISSIONING	NTS	NOT TO SCALE
CxA	COMMISSIONING AGENT	OD	OUTSIDE DIAMETER
DB	DECIBEL	OH	OVERHEAD
DC	DIRECT CURRENT	OHD	OVERHEAD DOOR
DEM	DEMOLISH	OL	OVERLOAD
DEMO	DEMOLISH OR DEMOLITION	PA	PUBLIC ADDRESS
DF	DRINKING FOUNTAIN	PB	PULL BOX OR PUSHBUTTON
DISC	DISCONNECT	PFC	POWER FACTOR CORRECTION
DPDT	DOUBLE POLE DOUBLE THROW	PH	PHASE
DPST	DOUBLE POLE SINGLE THROW	PNL	PANEL OR PANELBOARD
EC	ELECTRICAL CONTRACTOR	PT	POTENTIAL TRANSFORMER
EJ	EXPANSION JOINT	PTZ	PAN-TILT-ZOOM
ELEC	ELECTRICAL	PWR	POWER
ELEV	ELEVATOR OR ELEVATION	RCP	REFLECTED CEILING PLAN
EM	EMERGENCY	REBAR	REINFORCING BAR
EMT	ELECTRICAL METALLIC TUBING	RECEPT	RECEPTACLE
ENCL	ENCLOSURE	RM	ROOM
ETR	EXISTING TO REMAIN	RNMC	RIGID NON-METALLIC CONDUIT
EW	ELECTRIC WATER COOLER	ROW	RIGHT-OF-WAY
EW	ELECTRIC WATER HEATER	RMC	RIGID METAL CONDUIT
EXIST	EXISTING	SEC	SECONDARY
F	FUSE OR FAHRENHEIT	SPD	SURGE PROTECTIVE DEVICE
FA	FIRE ALARM	SPDT	SINGLE POLE DOUBLE THROW
FAAP	FIRE ALARM ANNUNCIATOR PANEL	SPECS	SPECIFICATIONS
FACP	FIRE ALARM CONTROL PANEL	SPST	SINGLE POLE SINGLE THROW
FF&E	FIXTURES, FURNISHINGS & EQUIPMENT	SQ	SQUARE
FIXT	FIXTURE	SS	STAINLESS STEEL
FLA	FULL LOAD AMPERES	SV	SOLENOID VALVE
FM	FACTORY MUTUAL	SWBD	SWITCHBOARD
FMC	FLEXIBLE METAL CONDUIT	SWGR	SWITCHGEAR
FO	FIBER OPTIC	TCC	TEMPERATURE CONTROL CONTRACTOR
FRT	FIRE RETARDANT	TCP	TEMPERATURE CONTROL PANEL
GC	GENERAL CONTRACTOR	TRANS	TRANSFORMER
GEN	GENERATOR	TS	TIME SWITCH
GFCI	GROUND FAULT CIRCUIT INTERRUPTER	TYP	TYPICAL
GFI	GROUND FAULT INTERRUPTER	UL	UNDERWRITERS LABORATORIES
GND	GROUND	UNO	UNLESS NOTED OTHERWISE
GYP BD	GYP SUM BOARD	UPS	UNINTERRUPTIBLE POWER SUPPLY
HH	HANDHOLE	V	VOLTS
HOA	HAND-OFF-AUTO	VA	VOLT-AMPERE
HP	HORSE POWER	VAC	VOLTS-ALTERNATING CURRENT
HV	HIGH VOLTAGE	VDC	VOLTS-DIRECT CURRENT
ID	INSIDE DIAMETER	VFD	VARIABLE FREQUENCY DRIVE
JB	JUNCTION BOX	W	WATTS
KO	KNOCKOUT	WH	WATER HEATER
KVA	KILOVOLT AMPERE	WP	WEATHERPROOF

GENERAL NOTES

- SYMBOLS AND GENERAL DESCRIPTIONS IN SYMBOL LEGENDS ARE INDICATED FOR GENERAL REFERENCE ONLY. NOT ALL SYMBOLS ARE USED ON THIS PROJECT. SEE SCHEDULES, SPECIFICATIONS AND PLANS FOR ADDITIONAL INFORMATION INCLUDING MOUNTING HEIGHTS.
- THESE ELECTRICAL DRAWINGS ARE DIAGRAMMATIC AND REPRESENT THE ELECTRICAL DESIGN INTENT. PROVIDE ALL WORK AND MATERIALS THAT ARE REQUIRED FOR COMPLETE AND FUNCTIONAL ELECTRICAL SYSTEMS THAT FULLY MEET THE ELECTRICAL DESIGN INTENT. ALL ELECTRICAL WORK SHALL CONFORM TO THE LATEST VERSION OF THE NEC AS ADOPTED BY THE AUTHORITY HAVING JURISDICTION. SEE SPECIFICATIONS FOR ADDITIONAL INSTALLATION REQUIREMENTS AND ITEMS THAT MAY BE REQUIRED ABOVE AND BEYOND THE MINIMUM REQUIREMENTS THAT ARE OUTLINED IN THE NATIONAL ELECTRICAL CODE (NEC).
- THOROUGHLY AND CAREFULLY REVIEW ALL DRAWINGS, SPECIFICATIONS AND WORK SCOPES IN CONTRACT DOCUMENTS PRIOR TO BIDS AND CONSTRUCTION. WHERE THERE ARE CONFLICTS AMONG THE DRAWINGS, SPECIFICATIONS AND WORK SCOPES, THE MORE STRINGENT OR GREATER QUANTITY REQUIREMENTS SHALL APPLY.
- ALL ELECTRICAL EQUIPMENT SHALL BE UL LISTED.
- SEE INDIVIDUAL SPECIFICATION SECTIONS FOR SPECIFIC REQUIREMENTS RELATED TO TESTING, MANUFACTURER STARTUP, TRAINING, ETC. ALL APPLICABLE TESTING AND MANUFACTURER STARTUP REPORTS SHALL BE SUBMITTED AND APPROVED PRIOR TO THE DEVELOPMENT OF ELECTRICAL PUNCH LISTS.
- ALL CONDUCTORS, INCLUDING THE GROUNDED CONDUCTORS (NEUTRALS), SHALL BE LABELED AT ALL ENDS AND JOINTS, WITH THE CORRESPONDING PANELBOARD NAME AND CIRCUIT NUMBER OR OTHERWISE IDENTIFIED TO CORRESPOND WITH THE ASSOCIATED EQUIPMENT MANUFACTURER'S IDENTIFICATION SYSTEM.
- AT A MINIMUM, PROVIDE #12, #12N, #12G FOR 20A BRANCH CIRCUITING. UNO. MINIMUM CONDUIT SIZE SHALL BE 3/4". UNO. NO MORE THAN NINE CURRENT CARRYING CONDUCTORS, SHALL BE ALLOWED IN A RACEWAY. UNO. EQUIPMENT GROUNDING CONDUCTORS SHALL BE SIZED IN ACCORDANCE WITH THE NEC AND MAY BE SHARED. ALL GROUNDED CONDUCTORS (NEUTRALS) SHALL BE TREATED AS CURRENT CARRYING CONDUCTORS.
- PROVIDE A DEDICATED GROUNDED CONDUCTOR (NEUTRAL) FOR EACH BRANCH CIRCUIT. SHARED NEUTRALS ARE NOT ALLOWED.
- INSTALL GREEN, INSULATED, COPPER EQUIPMENT GROUNDING CONDUCTORS IN ALL RACEWAYS INCLUDING ALL FLEXIBLE METAL CONDUITS AND NON-METALLIC RACEWAYS. GREEN INSULATED, EQUIPMENT GROUNDING CONDUCTORS SHALL BE INSTALLED WITH ALL FEEDERS AND BRANCH CIRCUITS.
- PROVIDE FIRE STOPPING FOR ALL CONDUIT AND OTHER ELECTRICAL EQUIPMENT PENETRATIONS THROUGH FLOORS, WALLS AND CEILINGS TO MAINTAIN FIRE RATINGS. SEE ARCHITECTURAL FOR THE SPECIFIED FIRE RATINGS OF FLOORS, WALLS, AND CEILINGS.
- LIMIT VOLTAGE DROP IN CONDUCTORS TO 2% FOR FEEDERS AND 3% FOR BRANCH CIRCUITS, ASSUMING FULL LOAD CONDITIONS. VOLTAGE DROP SHALL NOT EXCEED 5% FROM THE ELECTRICAL SERVICE TO THE FURTHEST ELECTRICAL DEVICE.
- CALCULATE AND APPLY THE APPROPRIATE NEC DERATING FACTOR FOR CONDUCTORS INSTALLED IN ROOF MOUNTED CONDUITS.
- PROVIDE THERMAL SEALS IN ALL CONDUITS THAT RUN FROM CONDITIONED SPACES TO UNCONDITIONED SPACES.
- ALL WIRING FOR INTERIOR LED LUMINAIRES THAT ARE REQUIRED TO BE DIMMED SHALL INCLUDE (2) #18 AWG WIRES FROM EACH LUMINAIRE TO THE ASSOCIATED LIGHTING CONTROLLER FOR 0-10V LIGHTING CONTROL. ALL CONTROL WIRES SHALL BE LABELED.
- SEE ARCHITECTURAL REFLECTED CEILING PLANS AND ELEVATIONS FOR LOCATIONS OF CEILING AND WALL MOUNTED DEVICES.
- ALL LUMINAIRES SHALL BE SUPPORTED FROM THE BUILDING STRUCTURE.
- UNLESS NOTED OTHERWISE, ALL CONDUIT AND WIRING SHALL BE CONCEALED. ELECTRICAL CONNECTIONS SHOWN ON DRAWINGS ARE DIAGRAMMATIC AND ARE USED TO ILLUSTRATE CIRCUITING AND WIRING REQUIREMENTS ONLY.
- ALL JUNCTION BOXES SERVING BRANCH CIRCUIT WIRING SHALL BE LABELED TO IDENTIFY THE CIRCUIT(S) ROUTED THROUGH EACH RESPECTIVE JUNCTION BOX BY UTILIZING BRADY LABELS.
- WHERE PLENUMS ARE UTILIZED FOR HVAC AIR DISTRIBUTION, PROVIDE PLENUM RATED CABLES AND CONDUCTORS IN THOSE PLENUMS. SEE MECHANICAL FOR LOCATIONS OF HVAC PLENUMS.
- ELECTRICAL EQUIPMENT INSTALLED ABOVE CEILINGS SHALL BE INSTALLED IN READILY ACCESSIBLE LOCATIONS, SUCH AS, BUT NOT LIMITED TO, ABOVE DOORWAYS TO ROOMS. COORDINATE ALL LOCATIONS WITH OTHER TRADES TO AVOID CONFLICTS WITH OTHER EQUIPMENT AND THE NEED FOR EXCESSIVELY LONG LADDER REQUIREMENTS TO ACCESS EQUIPMENT AND DIFFICULT AND AWKWARD CLIMBING AND/OR UNNECESSARY BENDING DURING SERVICING OF EQUIPMENT.
- CONDUCTORS INSTALLED IN WIREWAYS THAT CONTAIN MORE THAN 30 CURRENT CARRYING CONDUCTORS SHALL BE DERATED IN ACCORDANCE WITH THE NEC.
- DO NOT USE LOAD CENTERS, PANELBOARDS, SWITCHBOARDS, MOTOR CONTROL CENTERS AND OTHER POWER DISTRIBUTION EQUIPMENT AS RACEWAYS.
- SEE SPECIFICATION SECTION 26 05 34, RACEWAYS FOR ELECTRICAL SYSTEMS, FOR PROJECT SPECIFIC RACEWAY INSTALLATION REQUIREMENTS.
- SEE SPECIFICATION SECTION 26 05 53, IDENTIFICATION FOR ELECTRICAL SYSTEMS, FOR PROJECT SPECIFIC IDENTIFICATION REQUIREMENTS.
- EXISTING ELECTRICAL ITEMS INDICATED IN THE CONTRACT DRAWINGS ARE BASED ON THE OWNER'S LIMITED RECORD DRAWINGS AND THE ENGINEER'S LIMITED FIELD OBSERVATIONS. CONTRACTOR AND ALL APPLICABLE SUB-CONTRACTORS SHALL VISIT THE SITE TO UNDERSTAND COMPLETELY THE CONDITIONS UNDER WHICH THE WORK SHALL BE PERFORMED. PERFORM ALL INCIDENTAL ELECTRICAL DEMOLITION AND/OR RELOCATION OF DEVICES AND EQUIPMENT REQUIRED TO FACILITATE THE DEMOLITION WORK OF OTHER TRADES AT NO ADDITIONAL COST TO THE OWNER.
- DRAWINGS DO NOT INDICATE ALL ELECTRICAL EQUIPMENT AND DEVICES INTENDED TO BE REMOVED. DRAWINGS INDICATE MAJOR ELECTRICAL EQUIPMENT, FIXTURES AND DEVICES THAT ARE REQUIRED TO BE REMOVED. CONTRACTOR SHALL REMOVE OR RELOCATE ELECTRICAL EQUIPMENT, FIXTURES AND DEVICES AS NECESSARY FOR A COMPLETE AND PROFESSIONAL INSTALLATION. SEE NEW LIGHTING, POWER, SYSTEMS, ARCHITECTURAL, PLUMBING AND MECHANICAL PLANS FOR ADDITIONAL DEMOLITION REQUIREMENTS.
- UNLESS NOTED OTHERWISE, DISPOSE ALL REMOVED MATERIALS OFF SITE AND INCLUDE ALL COSTS FOR DISPOSAL IN BID. THE DISPOSAL OF MATERIALS SHALL COMPLY WITH ALL APPLICABLE FEDERAL, STATE AND LOCAL REGULATIONS INCLUDING TCLP TESTING.

LUMINAIRE SCHEDULE								
MARK	DESCRIPTION	MANUFACTURER	CATALOG NO.	OR EQUAL BY	LAMPS	VOLTAGE	LOAD	REMARKS
B	2'x2', RECESSED DIMMABLE LED TROFFER, 3.25" DEEP EXTRUDED ALUMINUM HOUSING, 3400 LUMEN OUTPUT	METALUX	22EN LD1 34 UNV L840 CD1	CREE LITHONIA	(LED LAMPS INCLUDED)	120 V	35 VA	4000K CCT
BE	SIMILAR TO TYPE B EXCEPT PROVIDED WITH INTEGRAL BATTERY PACK WITH TEST SWITCH AND INDICATOR LIGHT	METALUX	22EN LD1 34 UNV EL14W L840 CD1	CREE LITHONIA	(LED LAMPS INCLUDED)	120 V	35 VA	4000K CCT
C	2'x2', RECESSED LED TROFFER, 3.25" DEEP EXTRUDED ALUMINUM HOUSING, 2500 LUMEN OUTPUT, PROVIDE WITH 2'x2' DRYWALL FRAME KIT	METALUX	22 LD1 25 UNV L840 CD1-0F-22-W	CREE LITHONIA	(LED LAMPS INCLUDED)	120 V	26 VA	4000K CCT
CE	SIMILAR TO TYPE C EXCEPT PROVIDED WITH INTEGRAL BATTERY PACK WITH TEST SWITCH AND INDICATOR LIGHT	METALUX	22EN LD1 25 UNV EL14W L840 CD1	CREE LITHONIA	(LED LAMPS INCLUDED)	120 V	26 VA	4000K CCT
D	4' LED CHAIN MOUNTED LENSED INDUSTRIAL LIGHT	LITHONIA	CLX-L48-5000LM-SEF-RDL-WD-120-GZ10-40 K-80CRI	COOPER ACUITY HUBBELL	(LED LAMPS PROVIDED)	120 V	32 VA	4000K CCT
DE	SIMILAR TO TYPE D EXCEPT PROVIDED WITH INTEGRAL BATTERY PACK WITH TEST SWITCH AND INDICATOR LIGHT	LITHONIA	CLX-L48-5000LM-SEF-RDL-WD-120-GZ10-40 K-80CRI-E10WLCP	COOPER ACUITY HUBBELL	(LED LAMPS PROVIDED)	120 V	32 VA	4000K CCT
XA	SINGLE FACE LED EXIT SIGN, WHITE FACE, RED LETTERS, INTEGRAL BATTERY AND CHARGER	SURE-LITES	CX 7 SERIES	LITHONIA	LED INCLUDED	120 V	6 VA	UNIVERSAL MOUNTING KIT

ELECTRICAL SHEET LIST

SHEET	SHEET NAME
E001	LEGENDS AND GENERAL NOTES
E101	FIRST FLOOR ELECTRICAL PLAN
E102	SECOND FLOOR ELECTRICAL PLANS
E103	THIRD FLOOR ELECTRICAL PLANS
E401	ONE LINE DIAGRAMS
E501	ELECTRICAL DETAILS
E601	PANELBOARD SCHEDULES
ED101	ELECTRICAL DEMOLITION PLANS
TC101	COMMUNICATIONS LEGEND AND DETAILS
TC102	CONNECTIVITY DETAILS

REVISIONS		
8/23/2018	A3	ADDENDUM NO. 3


8/13/2018	BIDS
Drawn By	WRF
Designer	LTI
Reviewer	MM
Manager	MM

Hard copy is intended to be 24"x36" when plotted. Scale(s) indicated and graphic quality may not be accurate for any other size.

PROJECT NO.
180746
LEGENDS AND GENERAL NOTES


E001

C:\Work\Revit\2017_E_180746_wpslowk.rvt
PLOT INFO: 8/27/2018 8:46:42 AM

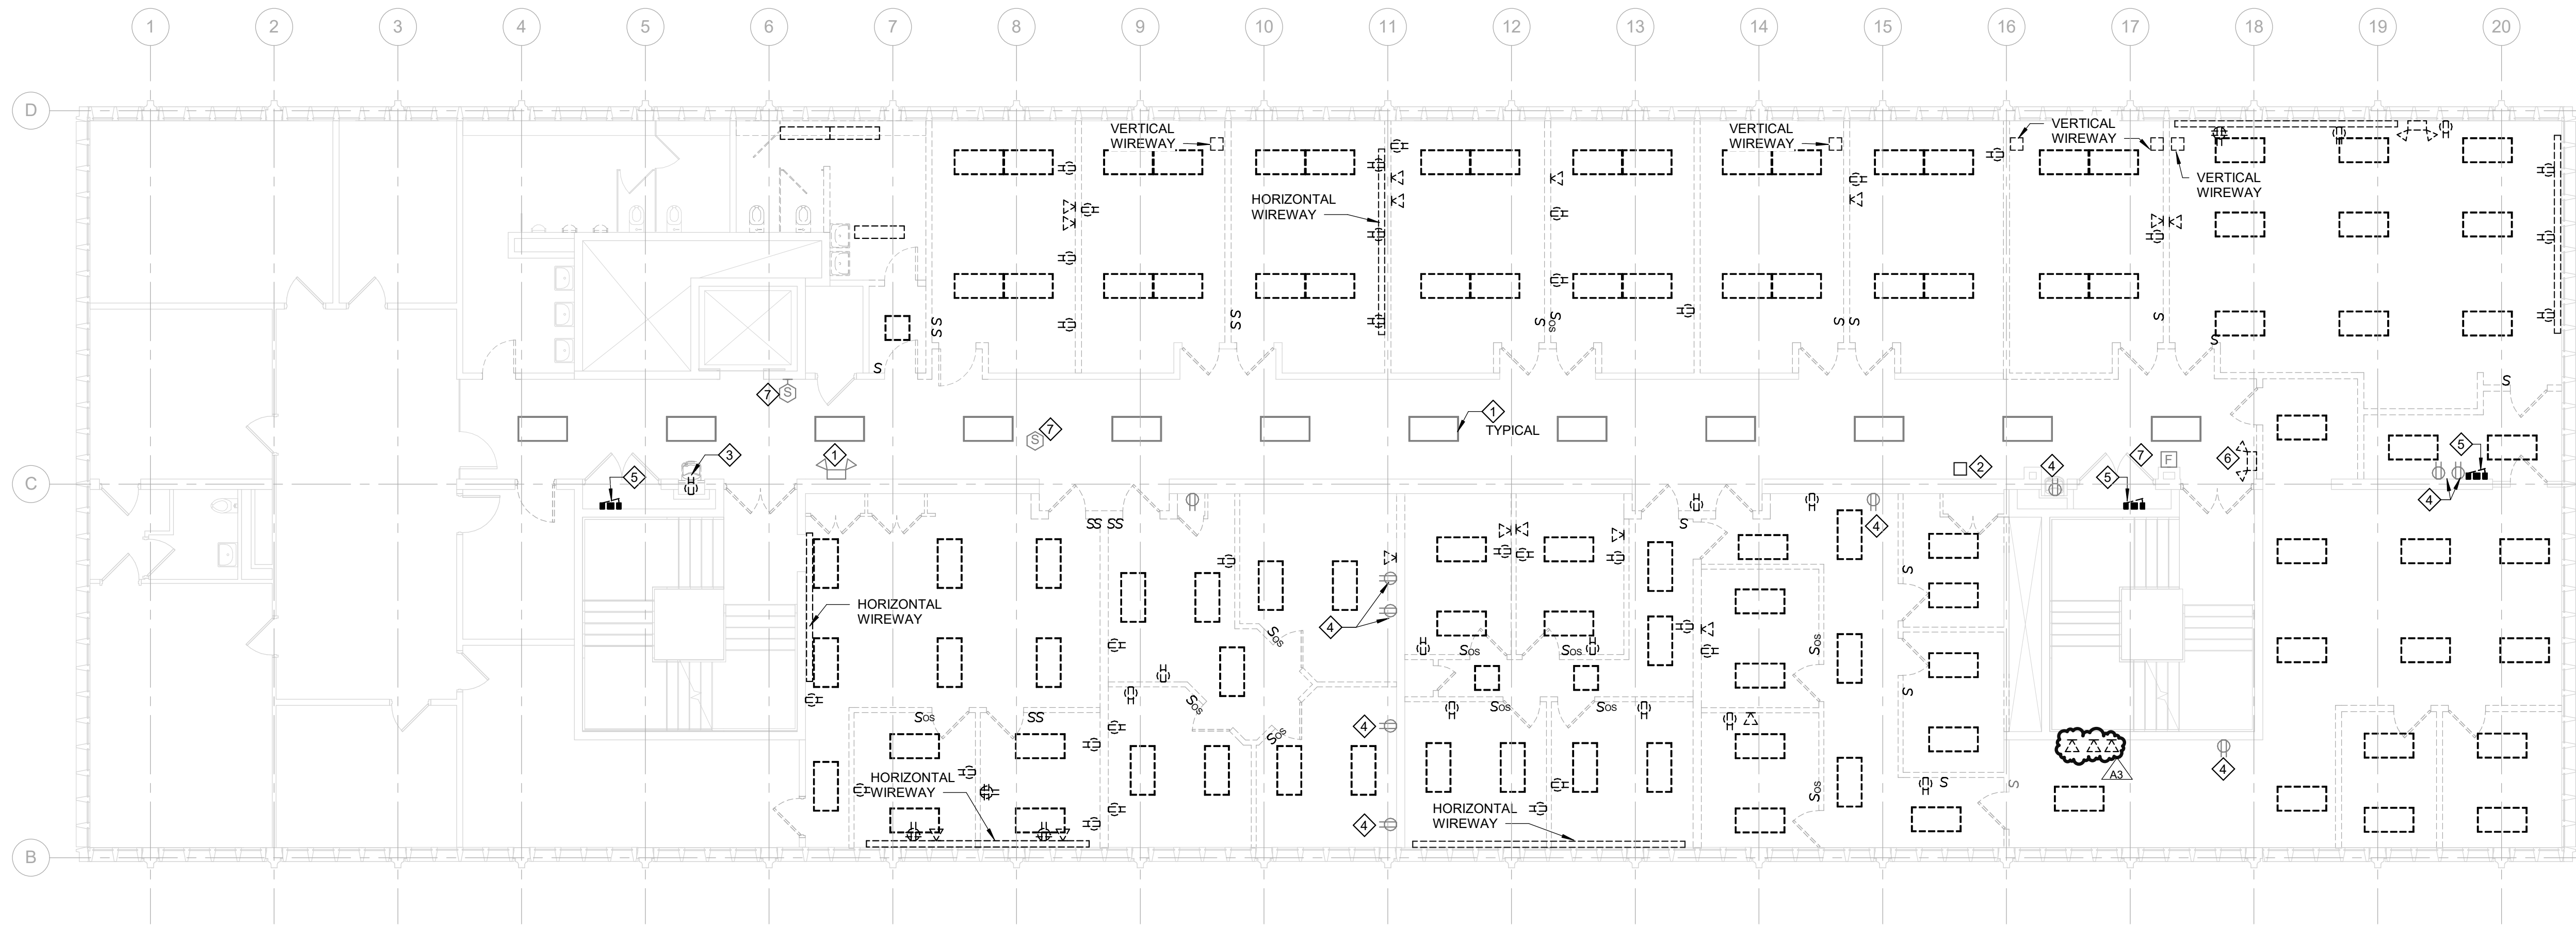

SECOND FLOOR ELECTRICAL DEMOLITION PLAN

SCALE: 1/8" = 1'-0"

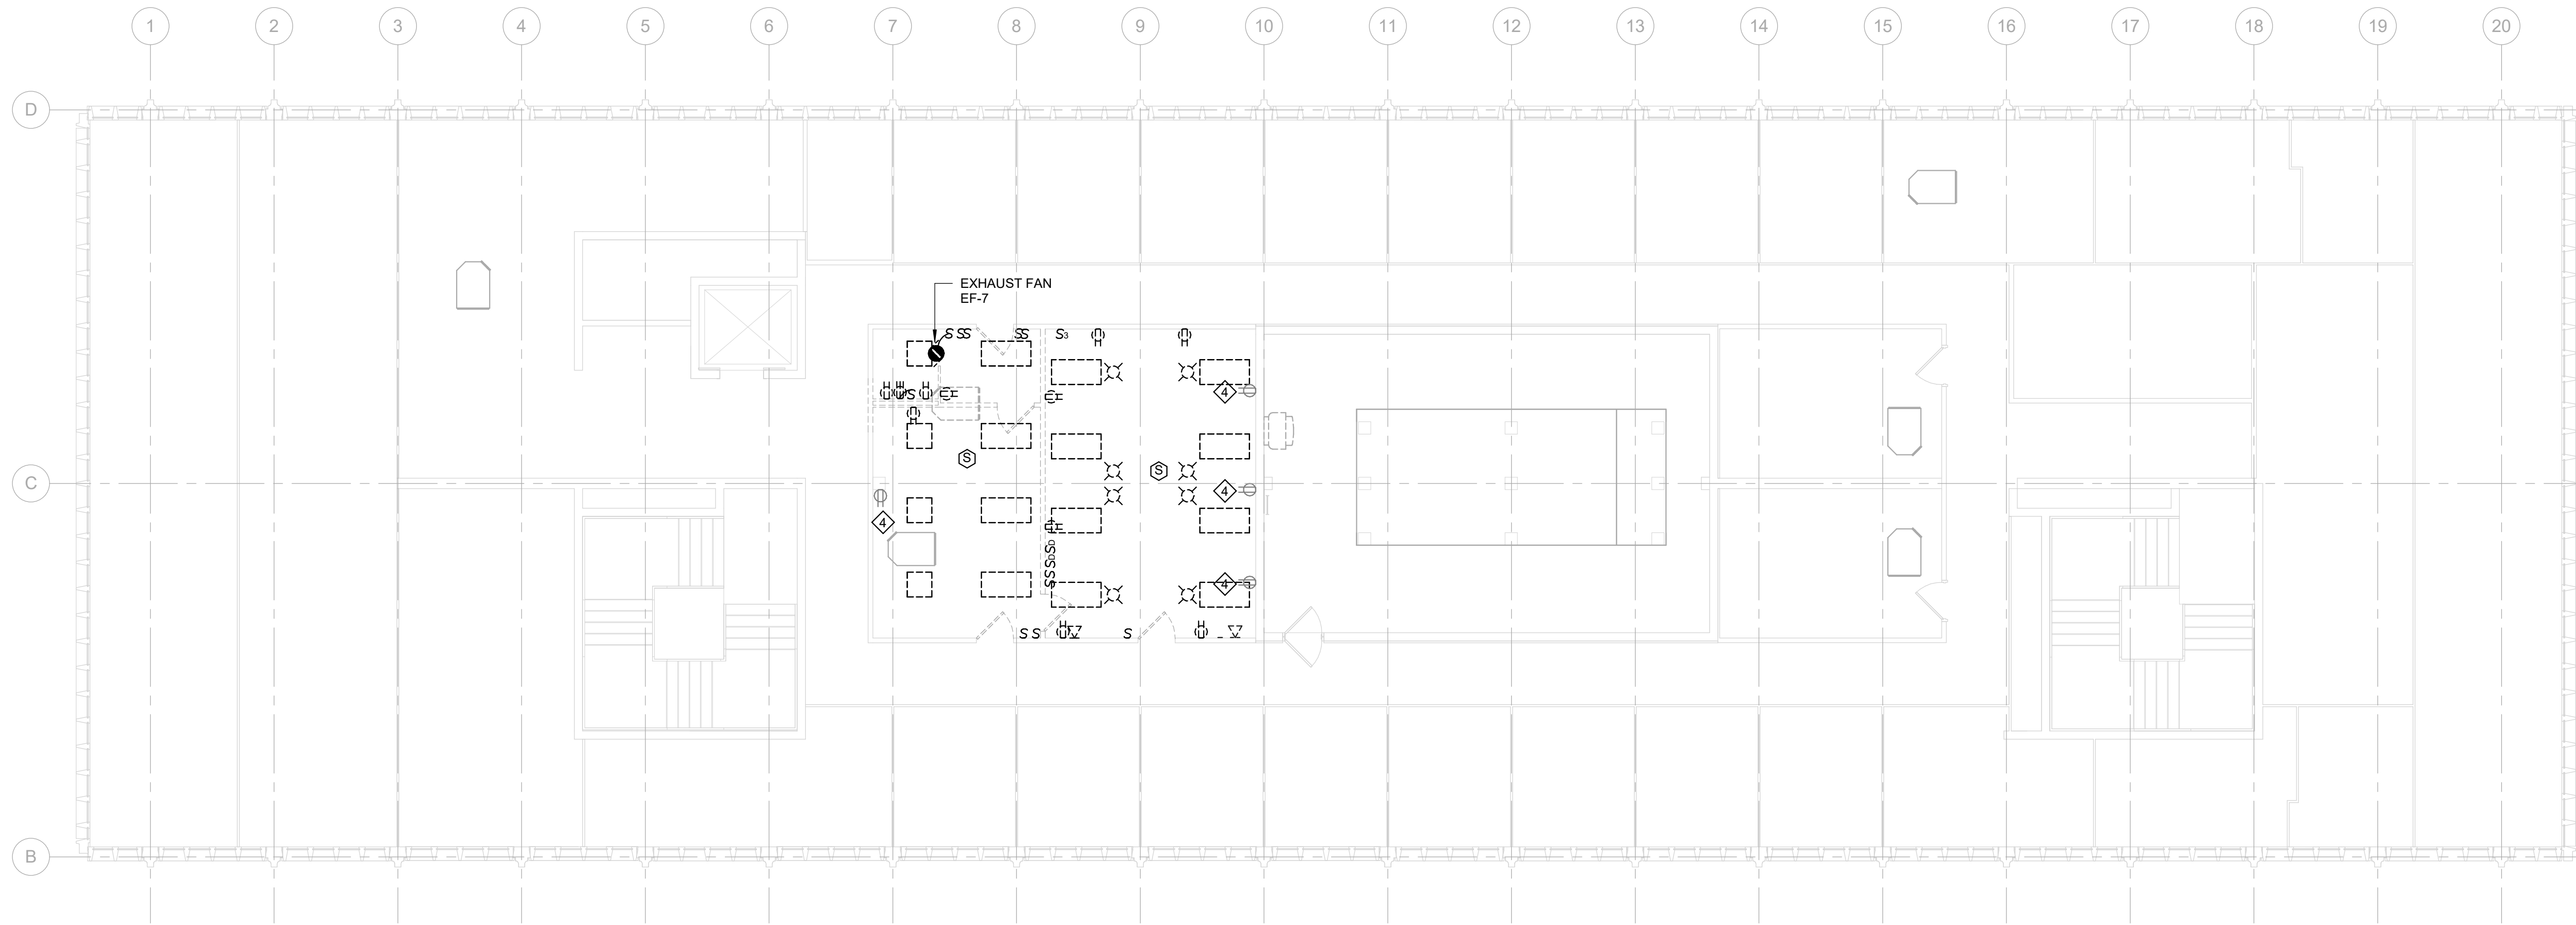

THIRD FLOOR ELECTRICAL DEMOLITION PLAN

SCALE: 1/8" = 1'-0"

NOTES

1. ITEMS SHOWN DASHED TO BE DEMOLISHED. SOLID ITEMS ARE EXISTING TO REMAIN UNLESS OTHERWISE NOTED.
2. MAINTAIN LIGHTING, POWER AND DATA CONNECTION FOR AREAS NOT PART OF THE SCOPE OF DEMOLITION THROUGH THE DURATION OF DEMOLITION.
3. FIRE ALARM, SECURITY AND OTHERS SYSTEMS TO REMAIN ACTIVE AT ALL TIMES.

KEY NOTES

1. EXISTING CORRIDOR LIGHT FIXTURES AND EXIT/EMERGENCY UNIT TO REMAIN, WITH LIGHTING CONTROL SYSTEM.
2. EXISTING DATA SERVICE TO REMAIN.
3. REMOVE RECEPTACLE FOR WATER COOLER. CIRCUIT TO BE EXTEND TO NEW WATER COOLER.
4. EXISTING POWER AND DATA OUTLETS TO REMAIN.
5. EXISTING ELECTRICAL PANEL TO BE REMOVED. FEEDER TO BE TERMINATED BACK AT THE SOURCE.
6. EXISTING EXIT/EMERGENCY UNIT TO BE RELOCATED. SEE SHEET E102 FOR NEW LOCATION.
7. EXISTING FIRE ALARM DEVICES TO BE TIED TO NEW FIRE ALARM CONTROL PANEL ON FIRST FLOOR.



WAYNE STATE
UNIVERSITY

ftc&h

engineers
scientists
architects
constructors

fishbeck, thompson, carr & huber, inc.
www.ftch.com

Wayne State University

5201 Cass Ave, Detroit, MI 48202

Prentiss Building Computer Lab Relocation

WSU Project: 022-313456

REVISIONS

8/23/2018	A3	ADDENDUM NO. 3
-----------	----	----------------

8/13/2018 BIDS

Drawn By MRF

Designer LTI

Reviewer RMM

Manager MMS

Hard copy is intended to be
24"x36" when plotted. Scale(s)
indicated and graphic quality may
not be accurate for any other size.


PROJECT NO.

180746


ELECTRICAL DEMOLITION
PLANS

ED101

©Copyright 2018
All Rights Reserved

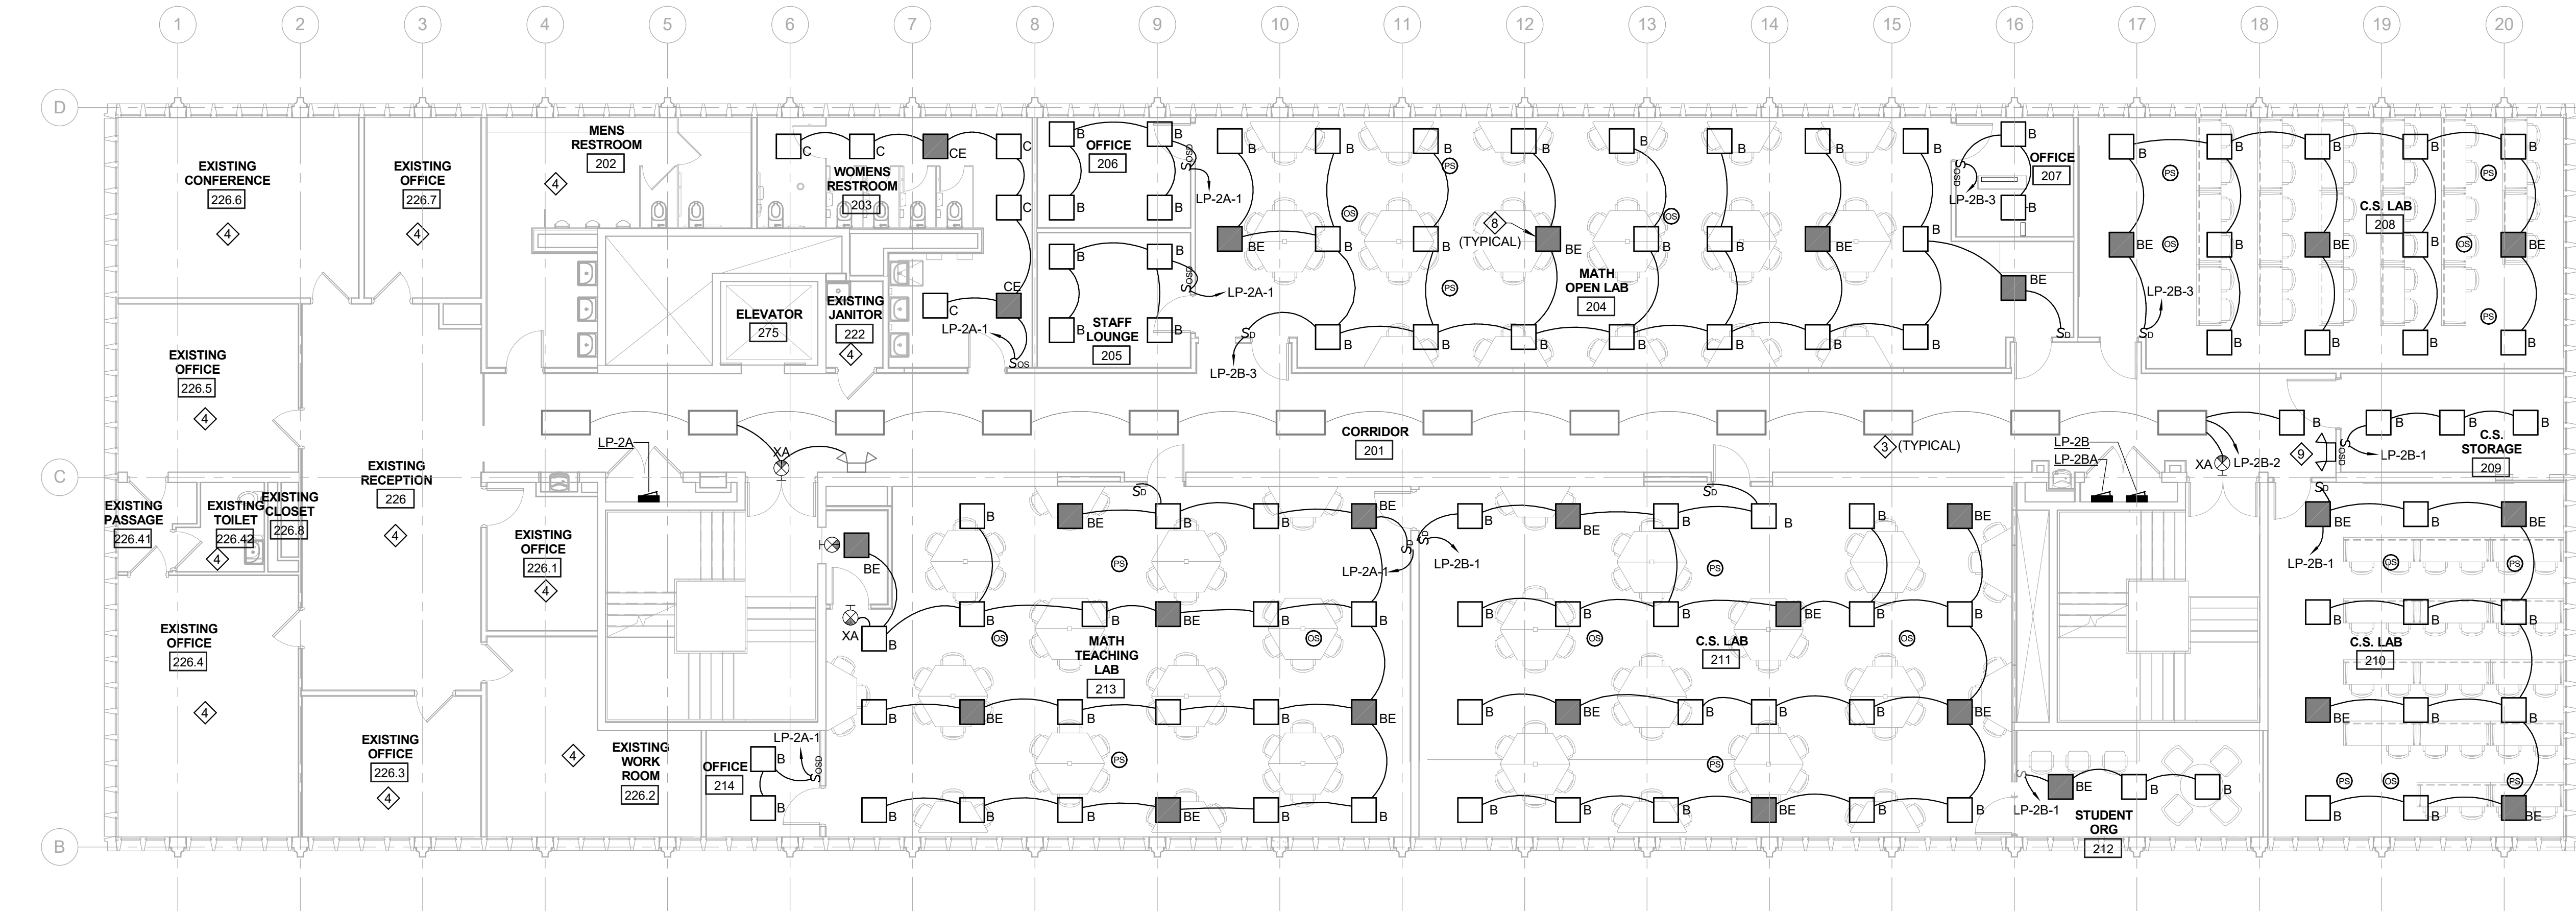

SECOND FLOOR LIGHTING PLAN
SCALE: 1/8" = 1'-0"

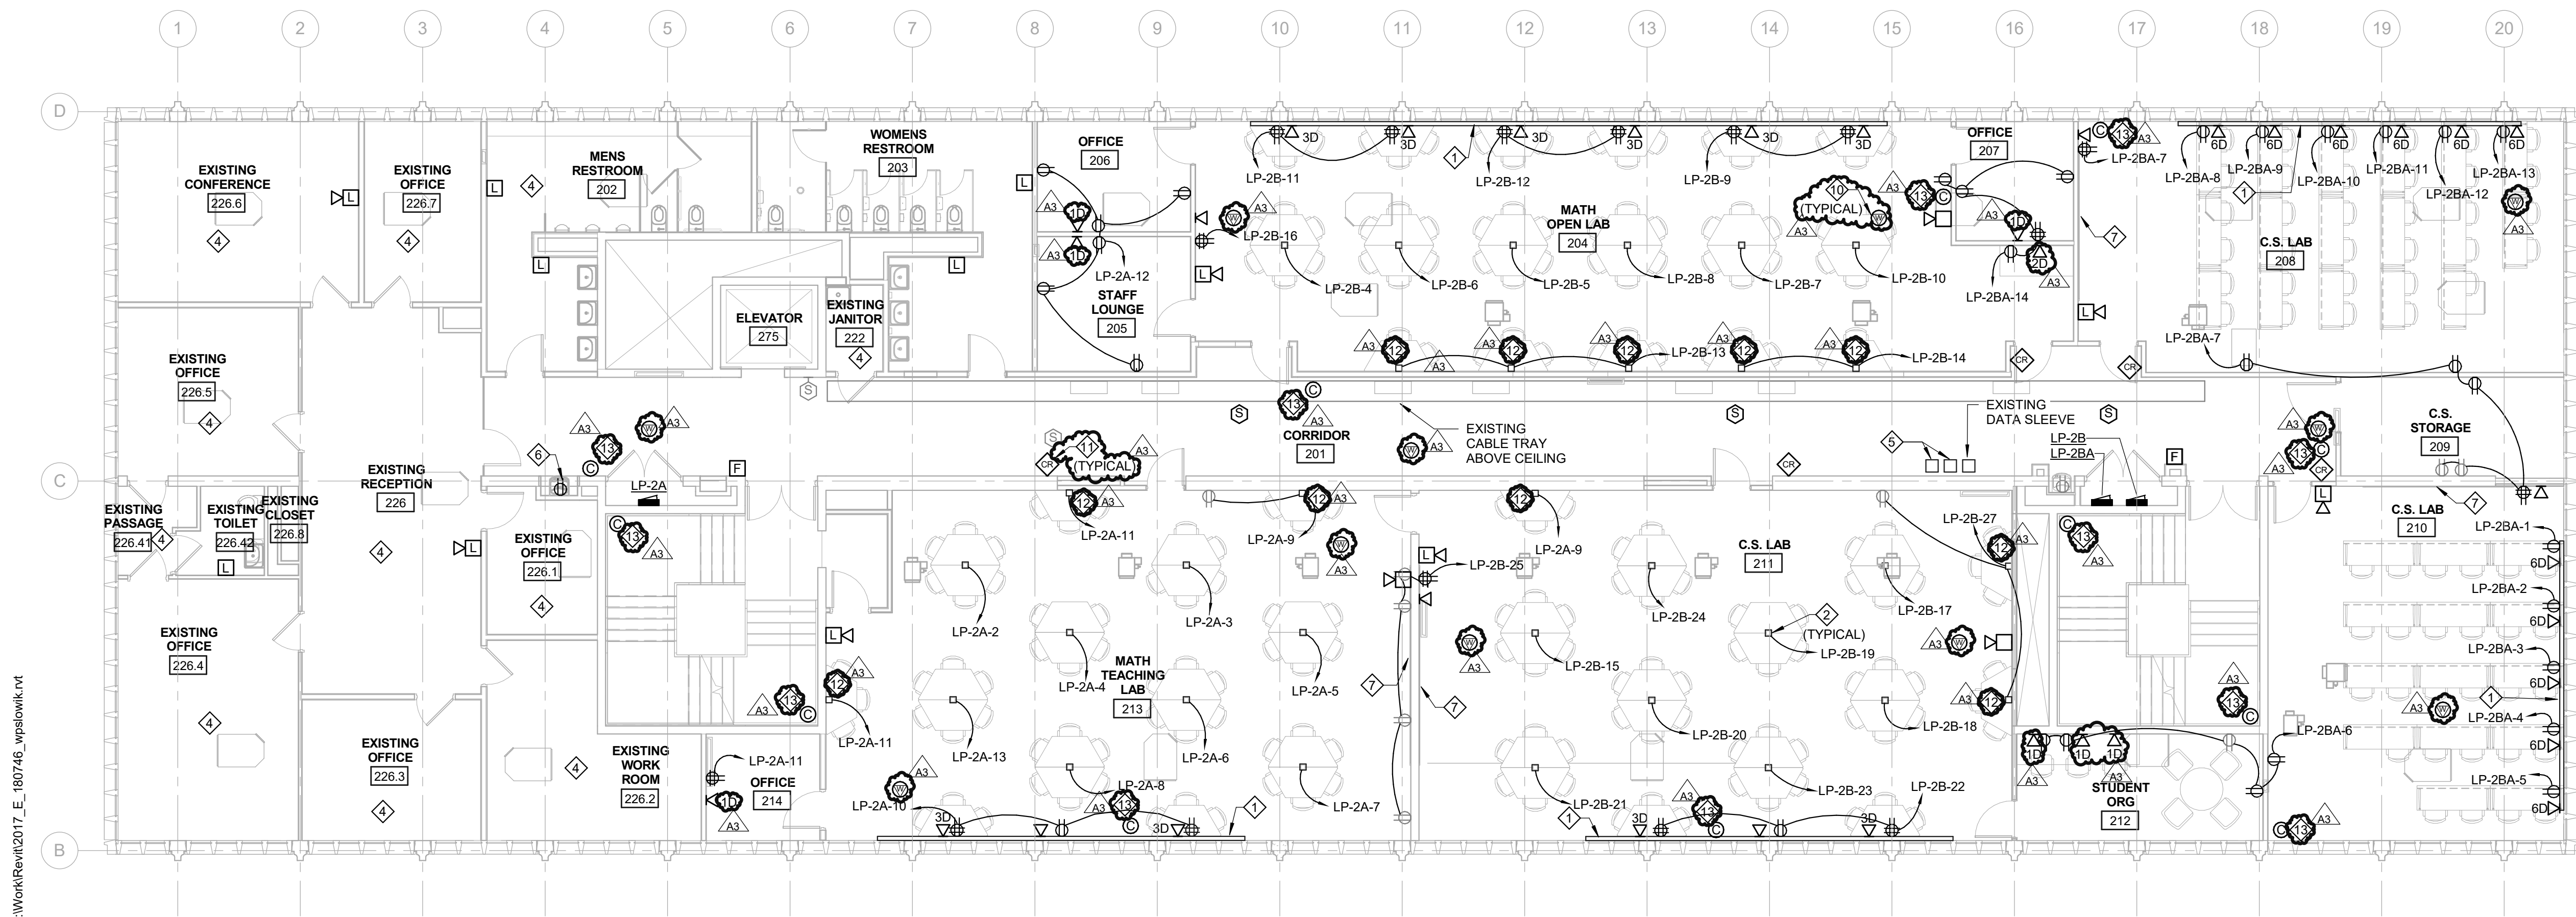

SECOND FLOOR POWER AND SYSTEMS PLAN
SCALE: 1/8" = 1'-0"

KEY NOTES

- FURNISH AND INSTALL SURFACE MOUNTED RACEWAY. MOUNT AT 0'-6" AFF. TO THE TOP. FOR ELECTRICAL ROUGH-IN REQUIREMENTS SEE DETAIL ON E501. (18) DATA DROPS IN ROOM 204, (36) DATA DROPS IN ROOM 208. WSU REQUIRES AT LEAST (1) BOX FOR EVERY (3) DATA OUTLETS.
- PROVIDE POWER POLE WITH (8) EIGHT POWER OUTLETS AND (8) DATA OUTLETS. LEGRAND 25DTP4 WITH 25DTP-B ADD ON POWER COVER AND 25DTPC-CVR DATA & AVY ADD ON POWER COVER WITH POWER AND DATA OUTLETS AS REQUIRED. RUN 3/4" CONDUIT ABOVE THE CEILING FOR POWER CONNECTION, AND 2" CONDUIT FOR DATA. CONDUITS TO RUN TO EXISTING CABLE TRAY IN THE CORRIDOR CEILING. PROVIDE (6) SIX - CAT 6 CABLE FOR DATA CONNECTION. AND ADDITIONAL (2) TWO CAT 6 CABLE FOR MONITORS.
- EXISTING LIGHT FIXTURE TO REMAIN. CIRCUIT TO BE POWERED TO NEW PANEL LP-B CIRCUIT NO. 2.
- EXISTING LIGHTING AND POWER CIRCUITS TO BE POWERED TO NEW PANEL LP-2A, PROVIDE CIRCUIT BREAKERS AS REQUIRED.
- PROVIDE (2) TWO 1/2" CONDUIT DATA SLEEVES FROM IDF ROOM 305 ON THIRD FLOOR.
- NEW WATER COOLER TO BE CONNECTED TO REMOVED WATER COOLER CIRCUIT.
- COORDINATE DEVICES LOCATION AND MOUNTING HEIGHT WITH GLASS MARKERBOARD.
- EMERGENCY LIGHT FIXTURES TO REMAIN ENERGIZED UPON LOSS OF POWER.
- RELOCATED EXIT/EMERGENCY UNIT EXTEND FEEDER TO NEW LOCATION.
- WIRELESS ACCESS POINT (WITH TWO CAT 5e DATA DROPS) COORDINATE EXACT LOCATION WITH CTL.
- PROVIDE (1) ONE CAT6 CABLE FROM CARD READER TO THIRD FLOOR IDF ROOM 305.
- PROVIDE POWER POLE WITH (3) POWER OUTLETS AND (3) DATA OUTLETS. LEGRAND 25DTP-4 WITH POWER AND DATA OUTLETS AS REQUIRED. RUN 3/4" CONDUIT FOR POWER CONNECTION TO EXISTING CABLE TRAY IN CORRIDOR CEILING. AND (3) THREE CAT 6 CABLE.
- DATA CABLING FOR SECURITY CAMERAS IS BASE BID. FURNISHING AND INSTALLATION OF SECURITY CAMERAS IS AN ALTERNATE TO THE BASE BID.

LIGHTING CONTROL FUNCTIONAL INTENT


- PRIVATE OFFICES, LOUNGE ROOM AND STORAGE: MANUAL-ON -OFF, AUTO OFF WITH DIMMER AND OCCUPANCY SENSOR.
- RESTROOMS: MANUAL ON-OFF, AUTOMATIC OFF, PIR TECHNOLOGY, LINE VOLTAGE WALL SWITCH OCCUPANCY. EMERGENCY LIGHT FIXTURES TO BE ENERGIZED UPON LOSS OF NORMAL POWER.
- LAB SPACES: MANUAL ON-OFF, AUTOMATIC OFF, DUAL ZONES DAYLIGHT HARVESTING, DIMMER SWITCH TO ADJUST LIGHTING LEVEL. EMERGENCY LIGHT FIXTURES TO BE ENERGIZED UPON LOSS OF NORMAL POWER.

REVISIONS		
8/23/2018	A3	ADDENDUM NO. 3

8/13/2018	BIDS
Drawn By	WRF
Designer	LTI
Reviewer	RRM
Manager	MM5

Hard copy is intended to be 24"x36" when plotted. Scale(s) indicated and graphic quality may not be accurate for any other size.

PROJECT NO.
180746
SECOND FLOOR ELECTRICAL PLANS

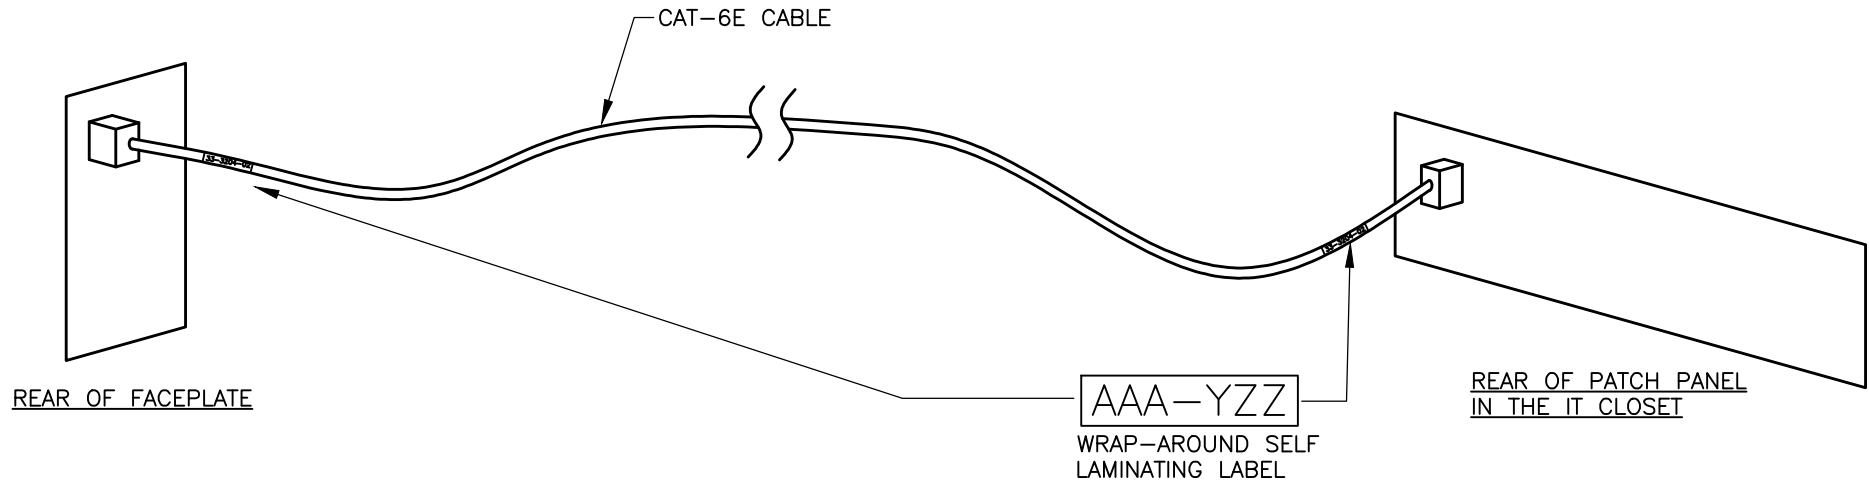


TYPICAL HORIZONTAL CABLING DETAIL NOTES:

1. INSTALL A LABEL AT EACH END OF THE CAT 6E CABLE.
2. LABELS SHALL BE LASER PRINTED AND OF THE WRAP AROUND, SELF LAMINATING STYLE.

CABLE LABELING SCHEME
 4AA = ROOM NUMBER
 Y = FUNCTION (D=DATA)
 ZZ = PORT NUMBER

TYPICAL HORIZONTAL CABLING DETAIL

NO SCALE

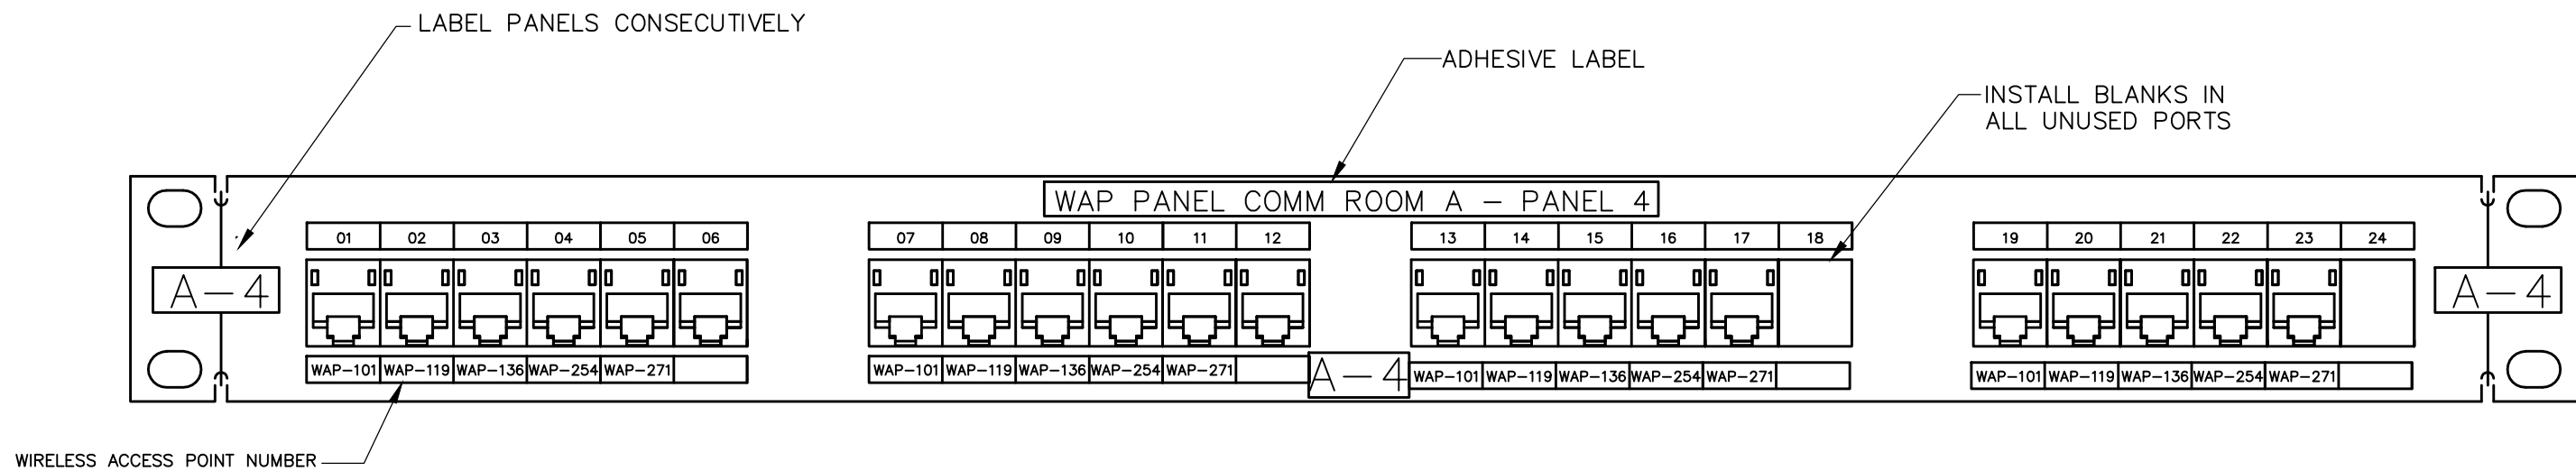


WIRELESS PANEL LABELING NOTES:

1. INSTALL A LABEL ON EACH PATCH PANEL DETAILING THE COMM ROOM NUMBER AND PANEL NUMBER.
2. ALL LABELS SHALL BE LASER PRINTED AND CUT TO FIT. ALL NUMBERS SHALL EXACTLY ALIGN WITH THE LOCATION ON THE PATCH PANEL.
3. EACH PORT SHALL BE LABELED WITH THE DEVICE NUMBER TO WHICH THE PORT IS CONNECTED.
4. CABLES SHALL BE TERMINATED ON PATCH PANELS IN NUMERICAL ORDER. NO EXCEPTIONS.

WAP-XXX
 WIRELESS ACCESS POINT IDENTIFIER
 WAP = DESTINATION DEVICE
 XXX = ROOM NUMBER

WIRELESS PANEL LABELING

NO SCALE

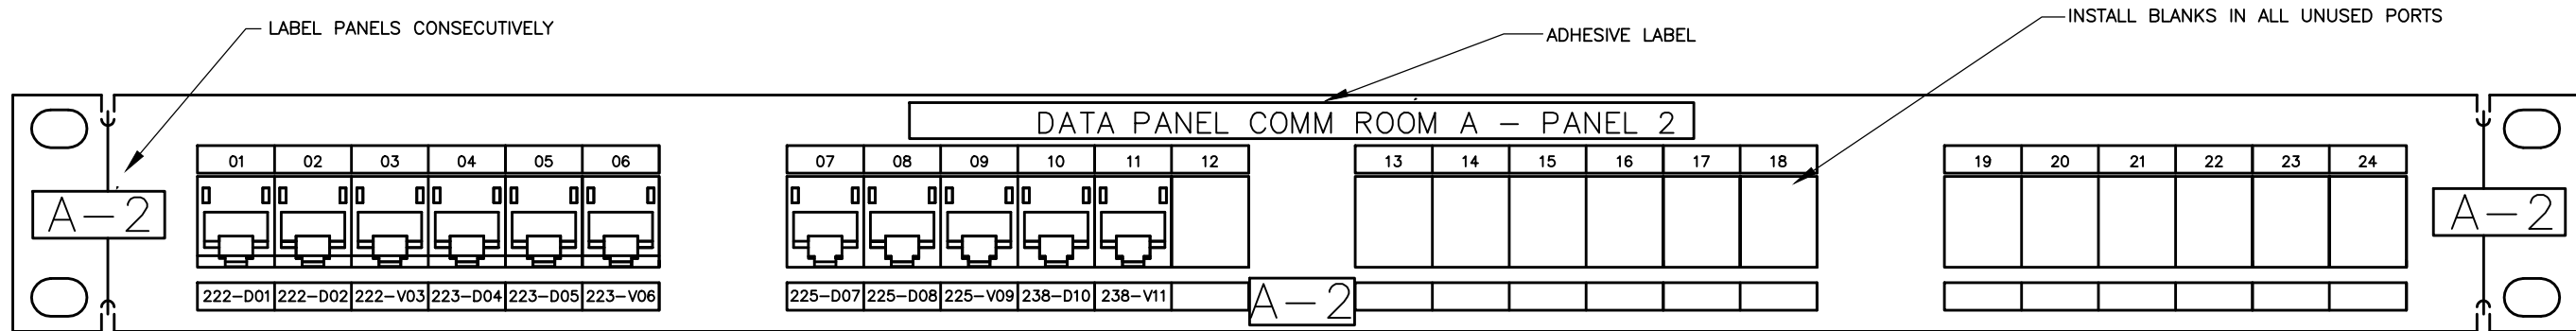


DATA PANEL LABELING NOTES:

1. INSTALL A LABEL ON EACH PATCH PANEL DETAILING THE RACK NUMBER AND PATCH PANEL NUMBER.
2. ALL LABELS SHALL BE LASER PRINTED AND CUT TO FIT. ALL NUMBERS SHALL EXACTLY ALIGN WITH THE LOCATION ON THE PATCH PANEL.
3. IF THE PANEL IS NOT PRE-LABELED 01-24 THEN THE CONTRACTOR SHALL INSTALL A LABEL FOR EACH PORT.
4. INDIVIDUAL CABLES AT A SINGLE FACEPLATE SHALL BE LABELED IN SEQUENCE AS PER THE PATCH PANEL.
5. THE CABLES SHALL BE TERMINATED ON THE PATCH PANEL IN NUMERICAL ORDER. NO EXCEPTIONS.

RRR-YYX
 DATA IDENTIFIER:
 RRR = ROOM NUMBER
 Y = FUNCTION (D=DATA)
 XX = PORT NUMBER

DATA PANEL LABELING

NO SCALE

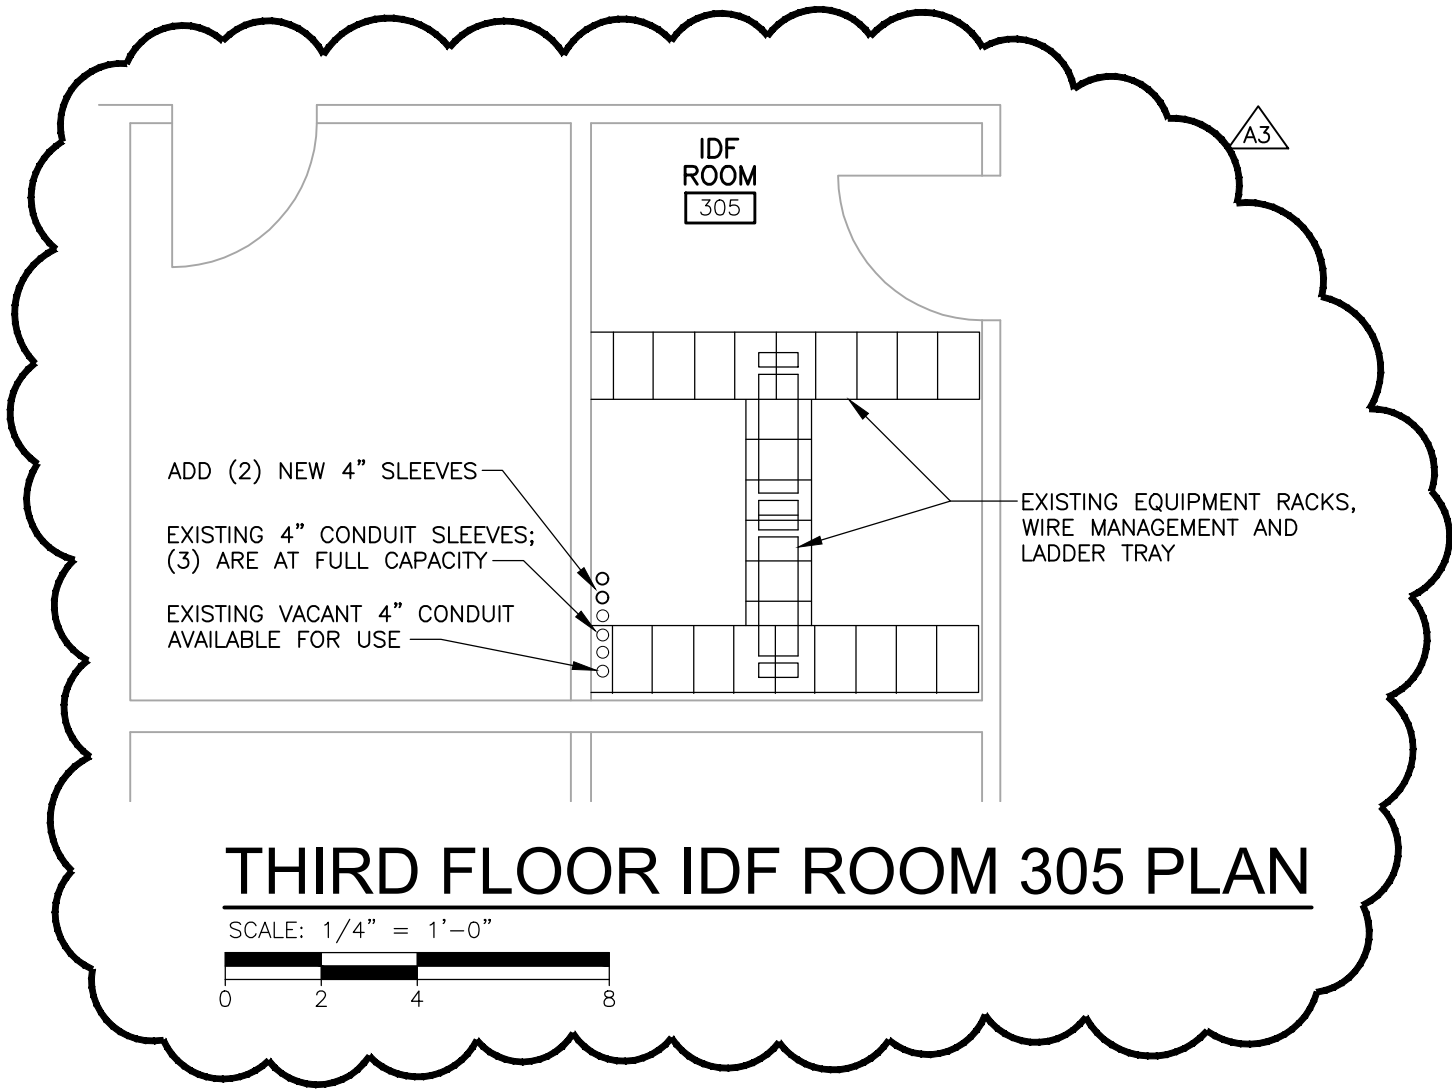

COMMUNICATION EQUIPMENT SCHEDULE

ALL NEW CABLING MUST BE TERMINATED IN IDF ROOM 305 ON THIRD FLOOR. ANY RE-USED EXISTING CABLING FOR THIS PROJECT MUST BE RE-TERMINATED IN IDF THIRD FLOOR. ANY REMAINING CABLES NOT RELATED TO THIS PROJECT WILL CONTINUE TO BE LOCATED IN IDF THIRD FLOOR.

PATCH PANEL –DATA & VOICE, UNLOADED PANEL, POPULATE ALL UN-USED PORTS WITH BLANKS. TERMINATE ALL CABLES WITH THE FOLLOWING JACKS.
 DATA = ORANGE SYSTEMAX #MSS400-112

PATCH PANEL –WIRELESS, UNLOADED PANEL, POPULATE ALL UN-USED PORTS WITH BLANKS. TERMINATE ALL CABLES WITH ORANGE JACKS.

SINGLE RACK UNIT PATCH CORD ORGANIZER (PCO-1).

MANUFACTURED SLEEVES, 2" FIRE-STOP SLEEVE, HILTI SPEED SLEEVE #CP 653 2", CONTRACTOR SHALL UTILIZE FOR ANY ADDITIONAL PENETRATIONS INTO ROOMS IF NO EXISTING AVAILABLE.

RACK MOUNTED PERFORATED EQUIPMENT SHELF.

MANUFACTURED SLEEVES, 4" FIRE-STOP SLEEVE, HILTI SPEED SLEEVE #CP 653 4", CONTRACTOR SHALL UTILIZE FOR BACKBONE OR TELECOMM ROOM PENETRATIONS IF NO EXISTING AVAILABLE.

MANUFACTURED SLEEVES, 2" FIRE-STOP SLEEVE, HILTI SPEED SLEEVE #CP 653 2", CONTRACTOR SHALL UTILIZE FOR ANY ADDITIONAL PENETRATIONS INTO ROOMS IF NO EXISTING SLEEVES ARE AVAILABLE.

COMMUNICATION SYMBOL LEGEND

SYMBOL	DESCRIPTION
	DATA OUTLET IN WALL OR COMBINED POWER SURFACE RACEWAY
	KEYNOTES. REFER TO NOTES ON THE SHEET FOR ADDITIONAL INFORMATION
	WAP WIRELESS ACCESS POINT. PROVIDED AND INSTALLED BY CONTRACTOR
	SPEED SLEEVE ABOVE DROP CEILING. SIZE AS NOTED. INSTALLED BY THIS CONTRACTOR. FIRESTOP ALL EXISTING SLEEVES USED UNDER THIS CONTRACT TO MEET CODES.

THE FOLLOWING SUBSCRIPTS AND ABBREVIATIONS MAY BE USED THROUGHOUT THE DRAWINGS IN ONE OR MORE COMBINATIONS.

SYMBOL	DESCRIPTION	SYMBOL	DESCRIPTION
C-EMT	EMT TYPE CONDUIT	2G	TWO-GANG BOX
EC	ELECTRICAL CONTRACTOR		–PROVIDED BY EC
PET	PROTECTED ENTRANCE TERMINAL	NIC	NOT IN CONTRACT
QTY	QUANTITY	AC	ABOVE COUNTER –INSTALL BACKBOX SAME HEIGHT AS OTHER ELECTRICAL OUTLETS ABOVE THE COUNTER.
AWG	AMERICAN WIRE GAUGE		
PBO	PROVIDED BY OTHERS	PCO-1	PATCH CORD ORGANIZER
EC	ELECTRICAL CONTRACTOR		–1 UNIT HIGH
AFG	ABOVE FINISHED GRADE	PCO-2	PATCH CORD ORGANIZER
AFF	ABOVE FINISHED FLOOR		–2 UNITS HIGH

COMMUNICATION CABLE SCHEDULE

DESCRIPTION
CAT-6E PLENUM CABLE. GREEN FOR WIRELESS ACCESS POINTS.
CAT-6E PLENUM CABLE. GREEN FOR STANDARD DATA CONNECTIONS.
12 STRAND MULTIMODE, 50 MICRON FIBER CABLE, CORNING FIBER #012T8P-31180-29
12 STRAND SINGLEMODE, OS2 FIBER CABLE, CORNING FIBER #012E88-33131-29



WAYNE STATE
 UNIVERSITY

ft&h

engineers
 scientists
 architects
 constructors

fishbeck, thompson, carr & huber, inc.
 www.ftch.com

Wayne State University

5454 Cass Ave, Detroit, MI 48202

Prentis Building Computer Lab Relocation

WSU PROJECT NUMBER: 022-319456

REVISIONS

8/23/2018 A3 ADDENDUM NO. 3

8/13/2018 BIDS

Drawn By MRF
 Designer LTI
 Reviewer RMM
 Manager MMS

Hard copy is intended to be 24"x36" when plotted. Scale(s) indicated and graphic quality may not be accurate for any other size.

PROJECT NO.

180746

COMMUNICATIONS
 LEGEND AND DETAILS

TC101

©Copyright 2018
 All Rights Reserved

CONTRACTOR SHALL UTILIZE EXISTING CAT 6E CABLING PRIOR TO UTILIZING NEW CAT 6E CABLING. FIELD CONFIRM WITH C&IT

NOT ALL ITEMS ON THIS SHEET ARE APPLICABLE TO THIS PROJECT THIS SHEET IS ISSUED TO CONVEY LOW VOLTAGE WIRING REQUIREMENTS. CONFIRM ALL WORK REQUIRED WITH WSU C&IT PERSONNEL AND STANDARDS. CONTRACTOR SHALL SUBMIT AND GAIN APPROVED SHOP DRAWINGS PRIOR TO ROUGH-IN OR INSTALLATION OF ANY EQUIPMENT, DEVICE OR CABLE. WSU C&IT LINK IS AS FOLLOWS:

<https://computing.wayne.edu/docs/wsucommunicationsstandards.pdf>