


## RIORS WAYNE STATE

WSUATHLETICS.COM


END/SIDELINE LETTERING

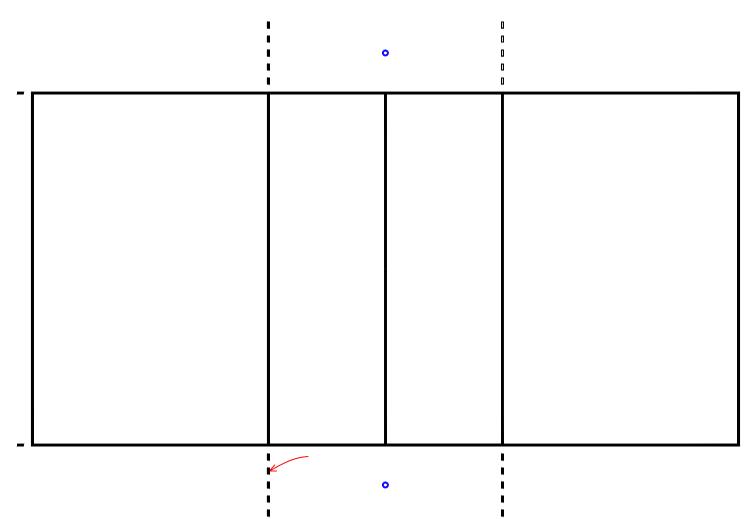

3 NCAA VOLLEYBALL COURT DIAGRAM

REF: NCAA 2010-2011 WOMEN'S VOLLEYBALL RULE BOOK SCALE: 1/8" = 1'-0"



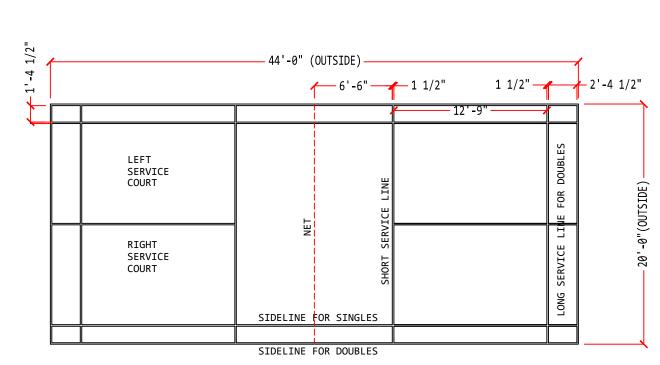

4 BADMINTON COURT DIAGRAM

REF: INTERNATIONAL BADMINTON FEDERATION SCALE: 1/8" = 1'-0"

4 INSTALLATION DRAWING ARE PAINTED IN YELLOW - PER PF/STEVEN
REVISED PER EMAIL "080-221231-1 WSU
ATHLETICS GYM FLOORS" DATED 07.16.12 DESCRIPTION

SUBMITTED FOR REVIEW AND APPROVAL 07/11/12 AP DATE BY WAYNE STATE UNIVERSITY MATTHAEI GYMNASIUM

2910 FALLING WATERS BLVD. LINDENHURST, IL. 60046 PH. 847.245.8450 FAX. 847.245.8589

COLOR: EBONY P231 POLO PLAZ FAST BREAK GAME LINE PAINT STRIPING REQUIREMENTS (1) SHALL FOLLOW NCAA RULE BOOKS, UNLESS STATED O NOTIFIED OTHERWISE. (2) ALL GAME LINES ARE 2" WIDE, UNLESS NOTED (3) THE LOCATION OF PAINTED COURTS ARE DEPENDENT UPÓN THE EXISTING OR NEWLY INSTALLED BASKETBALL BACKBOARDS AND FLOOR INSERTS. ALL EVENT STRIPING SHALL BE VERIFIED WITH THE ASSOCIATED EQUIPMENT ONSITE PRIOR TO PAINTING. STRIPING HIERARCHY: \* NOTE: OVERLAPPING EVENT STRIPING SHALL FOLLOW A STRIPING HIERARCHY AS LISTED BELOW. EVENTS WITH LOWER PRIORITY SHALL BREAK FOR EVENTS WITH HIGHER PRIORITY WITH THE TOP OF THE LIST HAVING THE HIGHEST PRIORTY. (A) 1 MAIN BASKETBALL SHALL BE PAINTED AS SHOWN COLOR: GREEN #1375 AND YELLOW PMS#1225C (B) 1 MAIN VOLLEYBALL SHALL BE, PAINTED COLOR: GREEN #1375

SCOPE OF WORK

SEAL / FINISH / STAIN

POLOPLAZ STAIN & SEAL

\*SEAL/FINISH: POLO PLAZ WORLD CLASS FINISH &

CONNOR ANCHORED REZILL SLEEPER DIN ON

25/32" X 2-1/4" SECOND & BETTER MAPLE.

45" PARQUET PATTERN AT MAIN COURT. 25/32X2-1/4" SECOND & BETTER MAPLE STRAIGHT LAID AT BALANCE OF ROOM. STRAIGHT LAID MAPLE SHALL RUN PARRALEL TO THE LENGHT OF THE MAIN BASKETBALL

WOOD FLOORING

\*FINISH LAYER:

REPRESENTATION OF GRAPHICS THAT SHALL BE PAINTEL ONTO THE FLOORING. (1) SELECTED PAINT COLORS FOR THE GRAPHICS SHALL E = POLO PLZ SAFETY BLACK \* BLACK

(C) 2 CROSS BASKETBALL SHALL BE PAINTED AS SHOWN, COLOR: GREEN #1375 (D) 1 SIDE VOLLEYBALL COURT PAINTED AS SHOWN,

, The same of the

GRAPHICS / ARTWORK

\* SEE ARTWORK DRAWINGS BY SIMON SIGNS FOR TRUE

COLOR: YELLOW PMS#1225C

GRAPHICS/ARTWORK:

\* GREEN = POLOPLAZ #1375 \* NCAA LOGO = POLO PLAZ #1001 \* NCAA LOGO = POLO PLAZ SAFETY WHITE ACCESSORIES

\*ALUM PLATE: HYDRO-WELLS ALUMINUM PLATE. AVAILABLE IN 6" AND 12" WIDE.

AND 12" WIDE.

\*WALL BASE:

\*WALL BASE:

\*\*WALL BASE: JOHNSONITE VENT COVE BASE AND PRE-MOLDED

CORNERS, COLOR: BLACK
\*ADHERED WITH PARABOND FUSION X COVE BASE

REVISED PER CLIENTS MARKED UP DRAWING RECIEVED ON 5/30/14. RESUBMITTED FOR REVIEW

> 07/17/12 AP BASKETBALL KEY LANES ARE STAINED AND LINES 07/17/12 AP 07/16/12 AP

6/6/14 DD

5151 JOHN C LODGE SERVICE DRIVE DETROIT, MI 48201

REF: NCAA 2012-2013 MEN'S AND WOMEN'S RULES
AND INTERPRETATIONS RULE BOOK

— 28'-0" COACHING BOX —

SIDELINE

7'-0" 12" 36" 2" 36" 2" 36" 2"

12" WIDE BY

— 28'-0" СОАСНING ВОХ —

NCAA BASKETBALL COURT DIAGRAM